
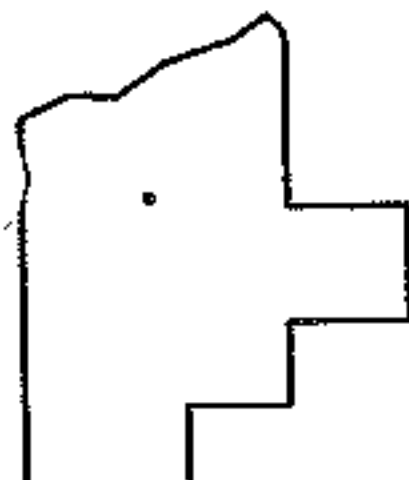
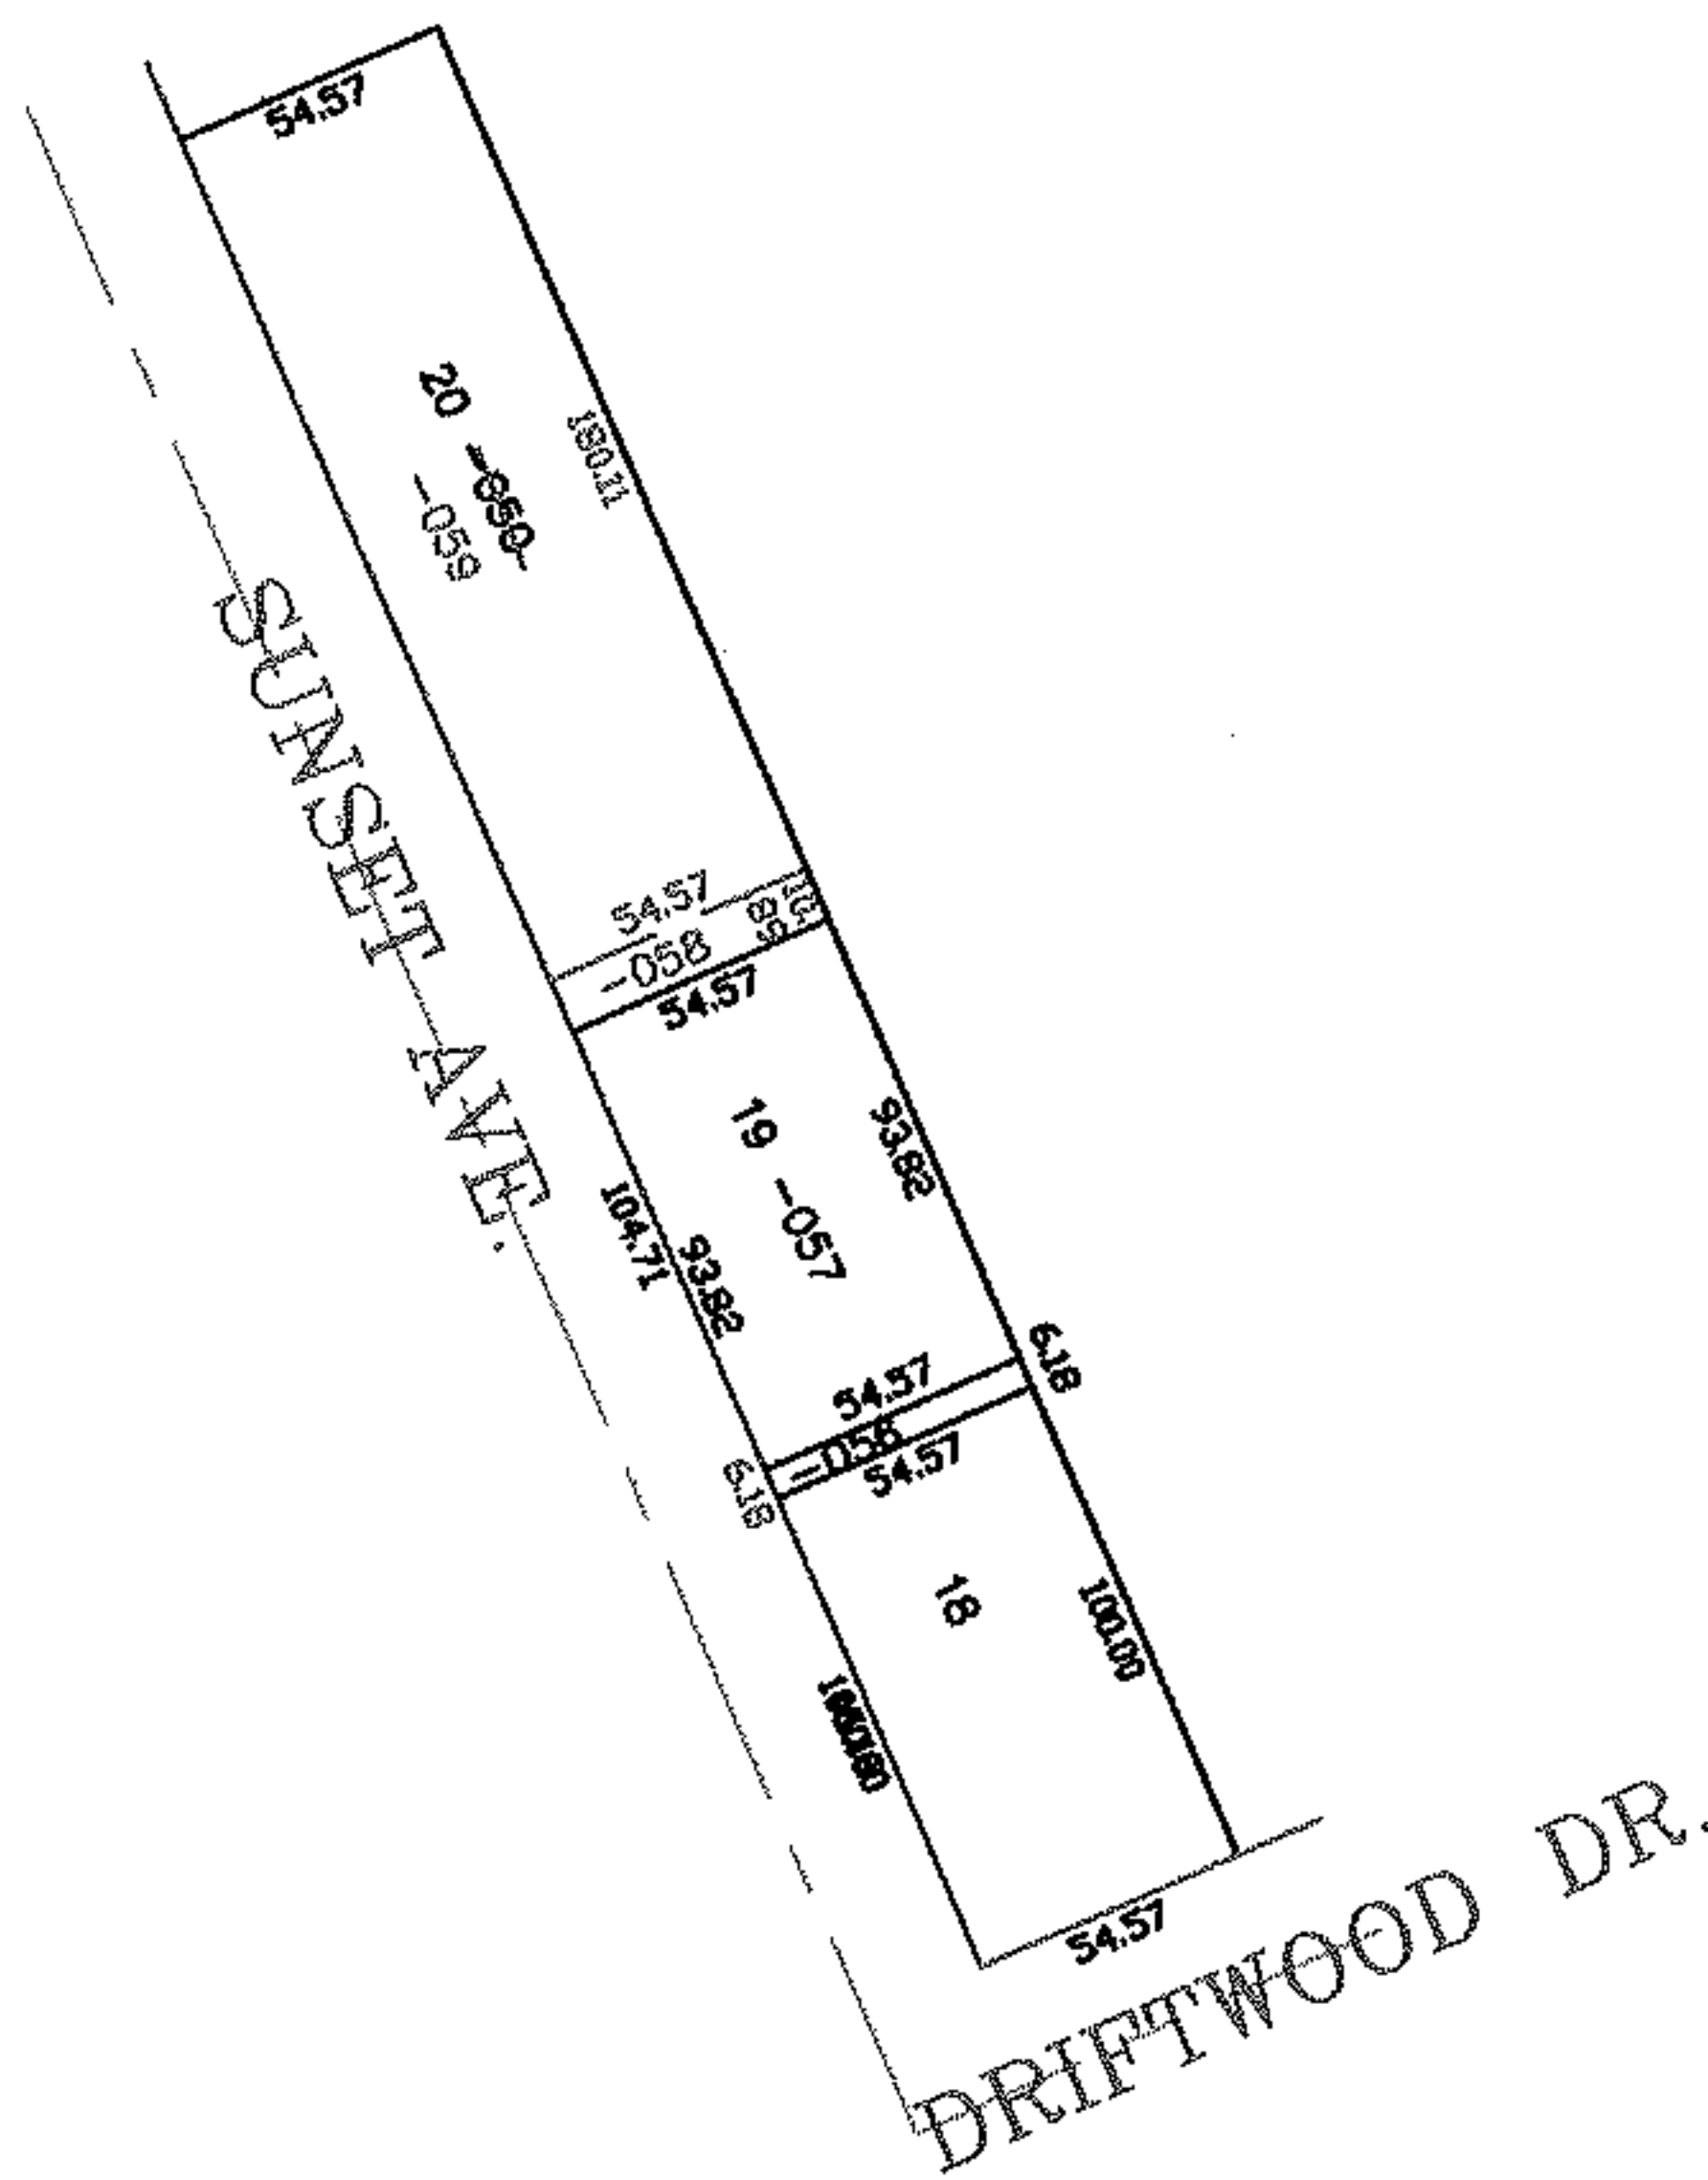


PARENT PARCEL: 02-01-002-105-057, -050

CHILD PARCEL: 02-01-002-105-058, -059

STARTING POINT: RIGHT-OF-WAY LINE OF SUNSET AVE. & DRIFTWOOD DR.

NO. 01915

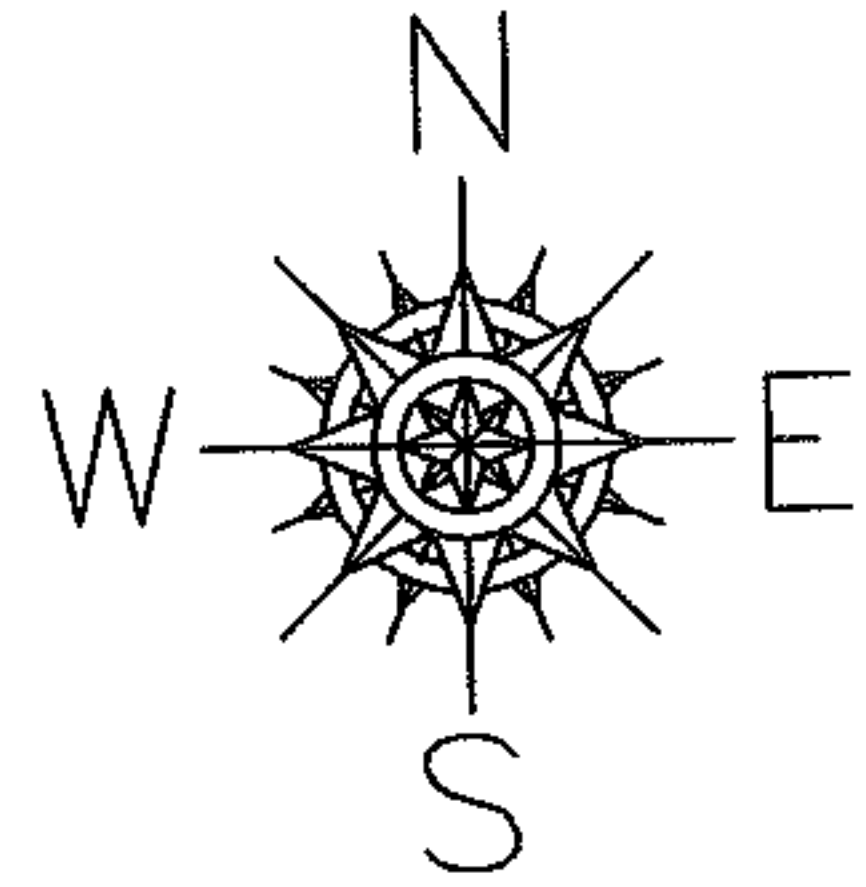

SPLITS/DEEDS PROCESSED

LORAIN COUNTY TAX MAP DEPARTMENT
226 MIDDLE AVE. ELYRIA, OHIO

SURVEYED BY: CHRISTOPHER HIRZEL

CLOSURE: 0.00 : 10.000

MAP PAGE(S): 02-01-003-A

APPROVED BY: JAH DATE: 5-16-05

SCALE: 1" = 100' PRIOR INSTRUMENT: PL VL 76/74