


RASTER

RASTER

PARENT PARCEL: 06-25-001-000-076
 CHILD PARCEL: XX-XX-XXX-XXX-XXX
 STARTING POINT: S.W. CORNER OF S/L 1 IN SUGARLANE INDUSTRIAL PARK
PLAT VOL. 36 PG. 15-16



09-01920-C

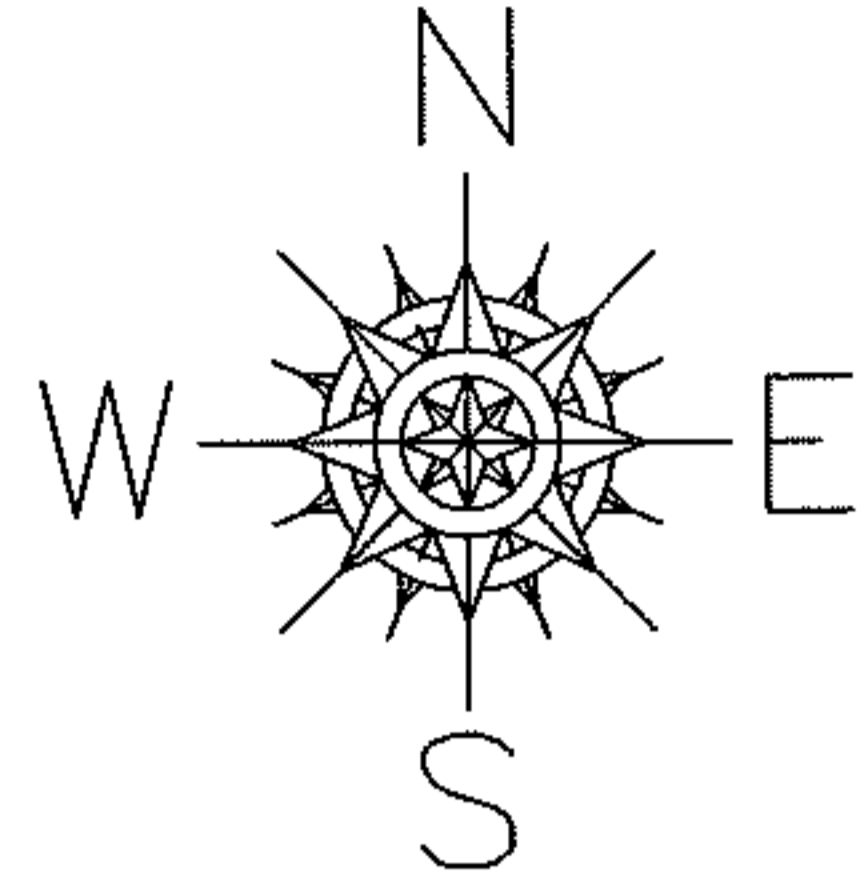

MAP CORR. ONLY

CORRECTION PER DEED
19980585070

SUGARLANE 60'

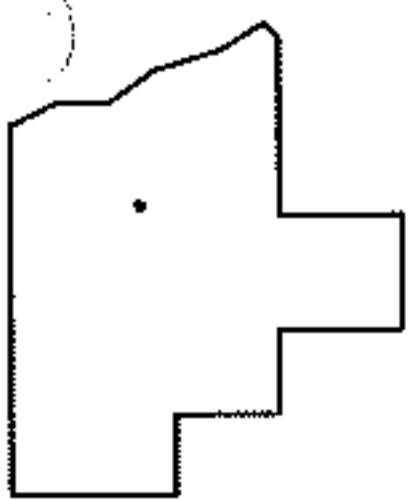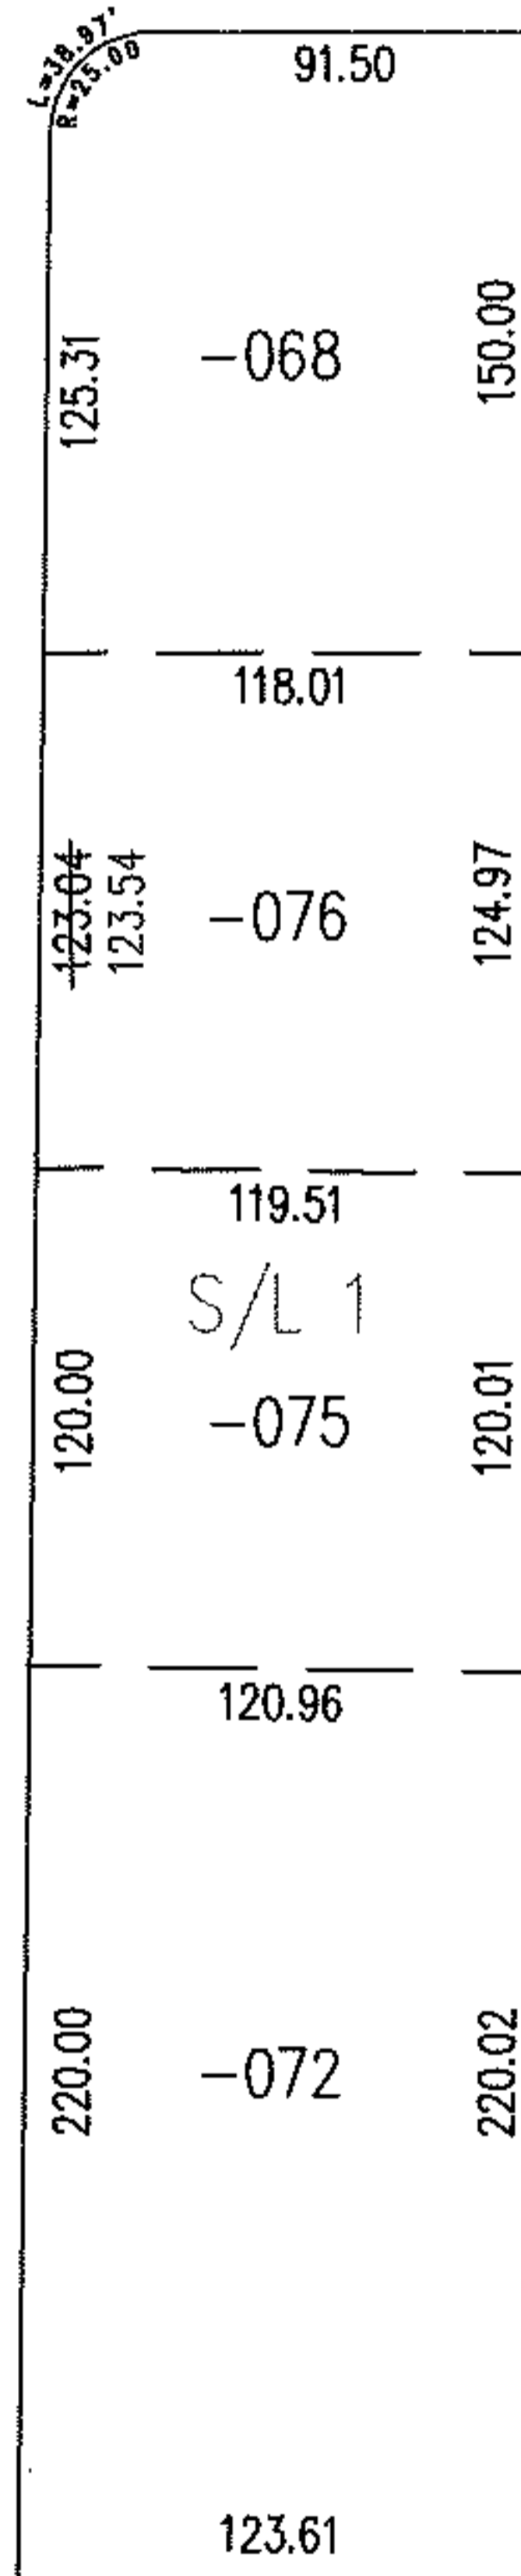

SPLITS/DEEDS PROCESSED
 LORAIN COUNTY TAX MAP DEPARTMENT
 226 MIDDLE AVE. ELYRIA, OHIO

SURVEYED BY: KS & ASSOC
 CLOSURE: 0.01 : 10,000
 MAP PAGE(S): 6-144
 APPROVED BY: TJS DATE: 11/3/09
 SCALE: 1" = 100 PRIOR INST.: 19980585070