



MASTER

PARENT PARCEL: 04-00-017-101-052

CHILD PARCEL: 04-00-017-101-191, -192

STARTING POINT: CENTERLINE OF WEBBER RD. & AVON-BELDEN RD.

NO. 01921

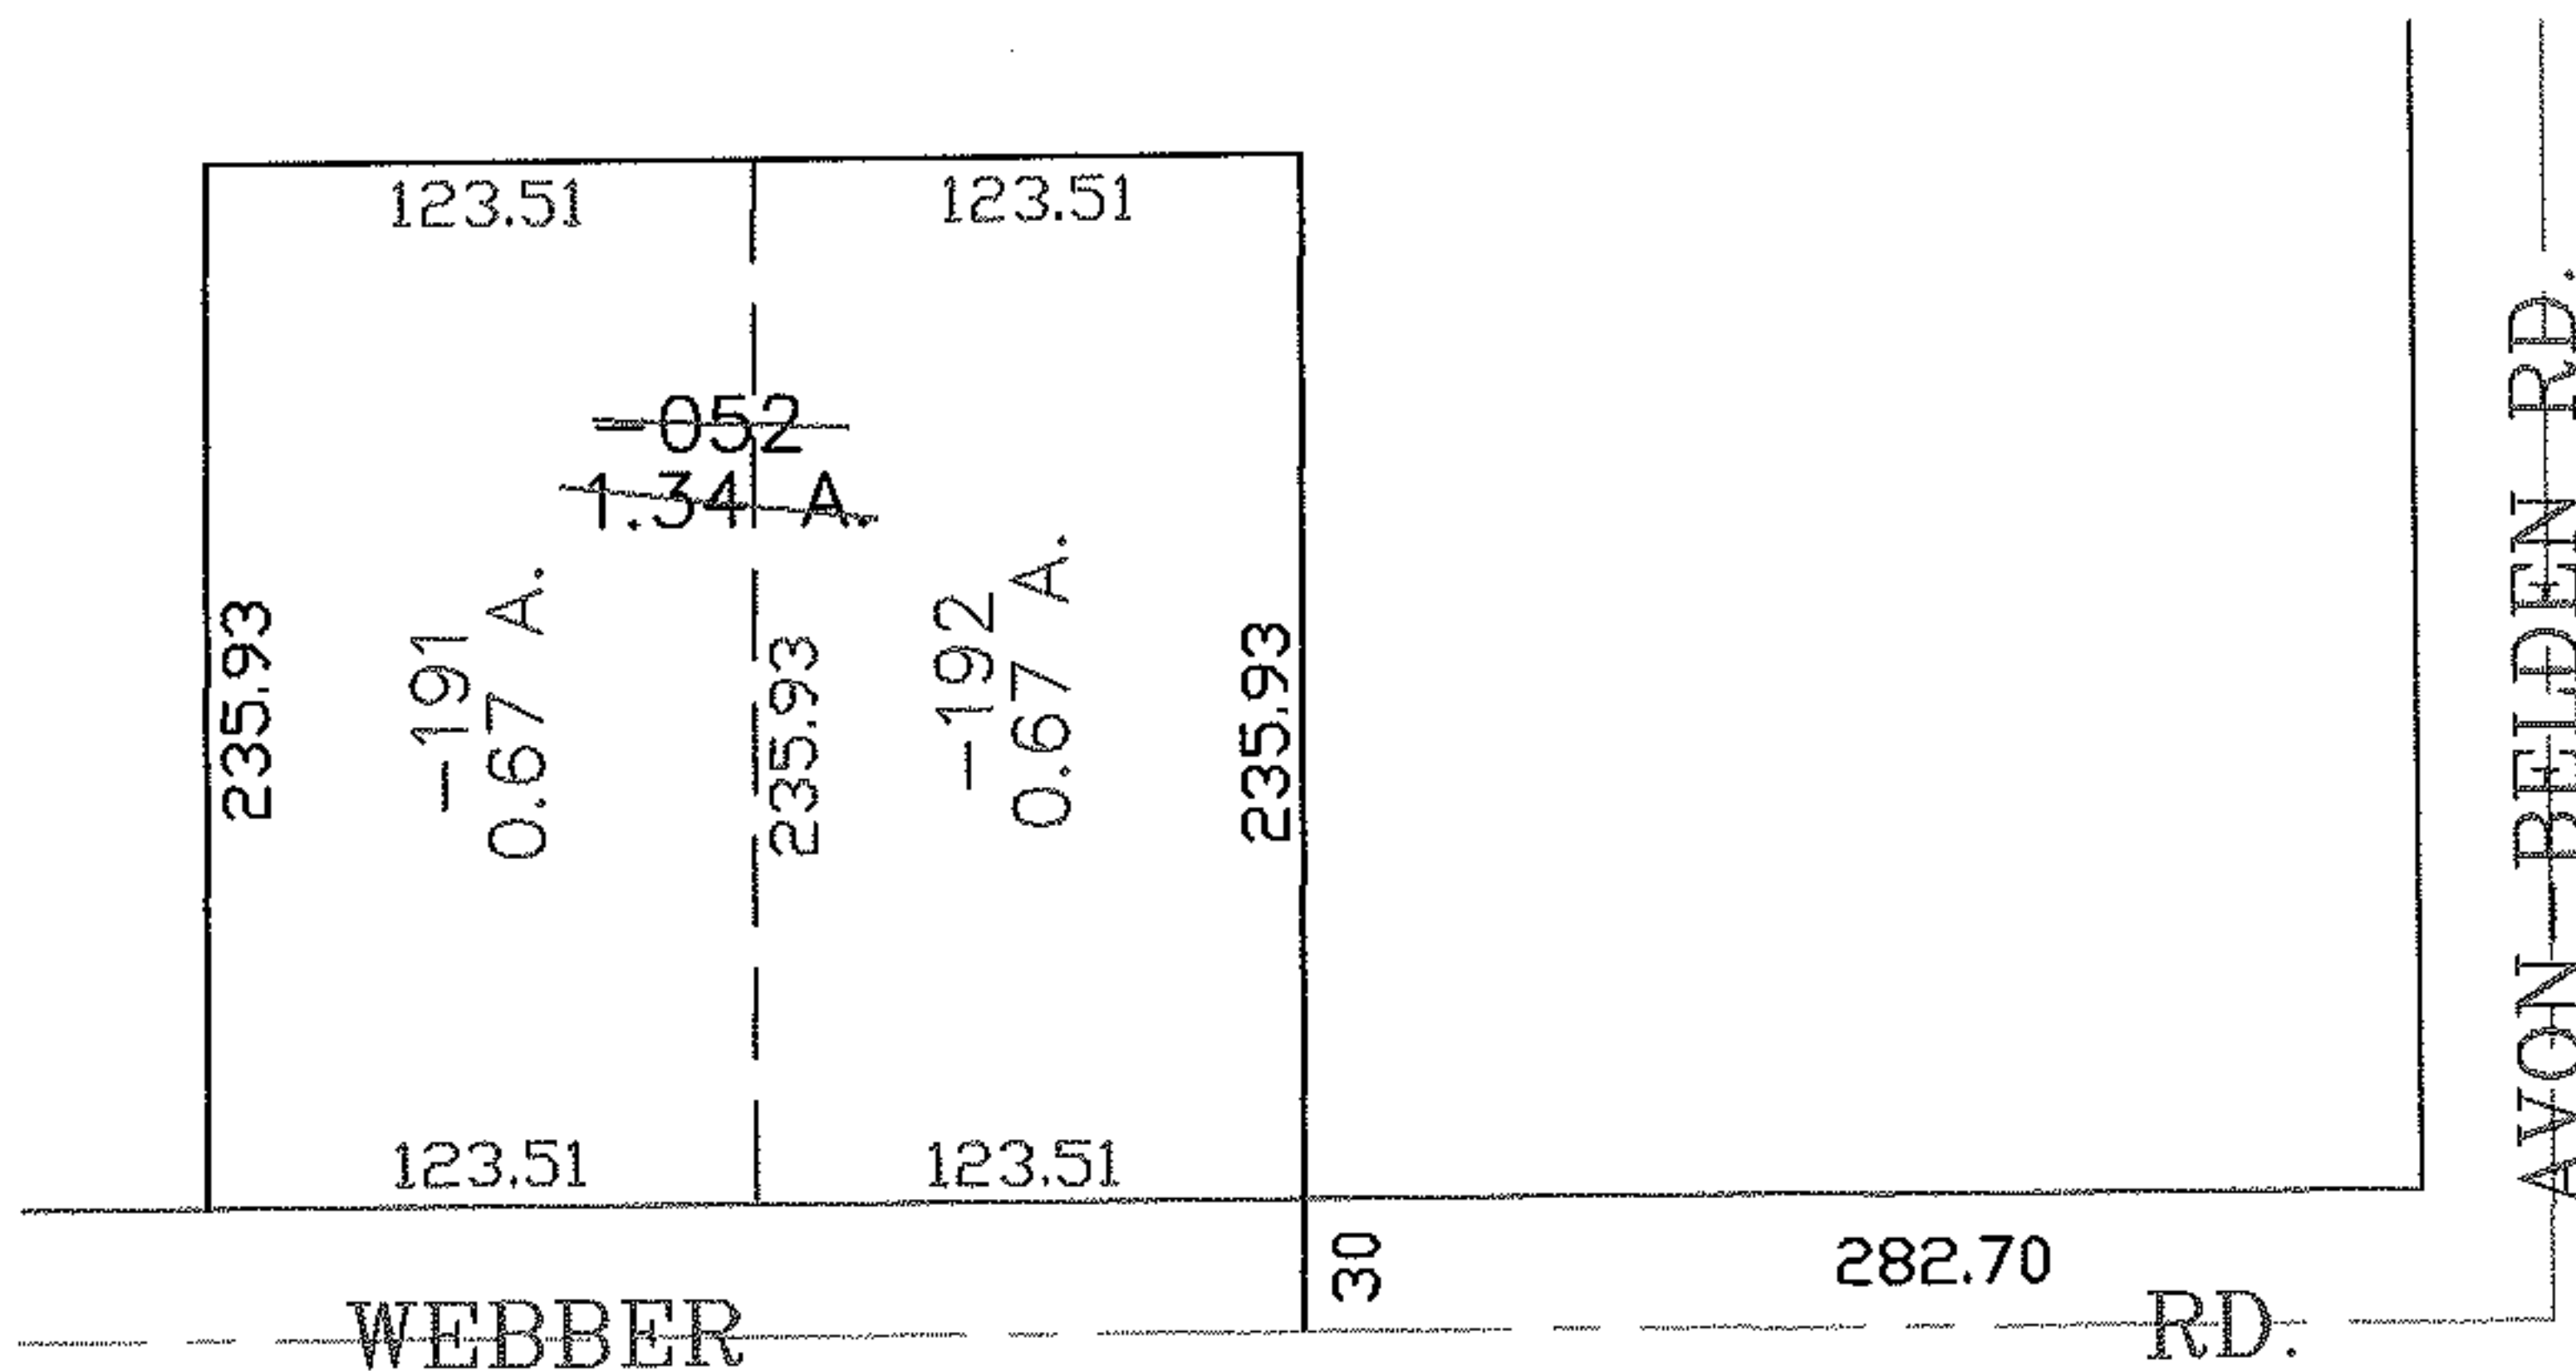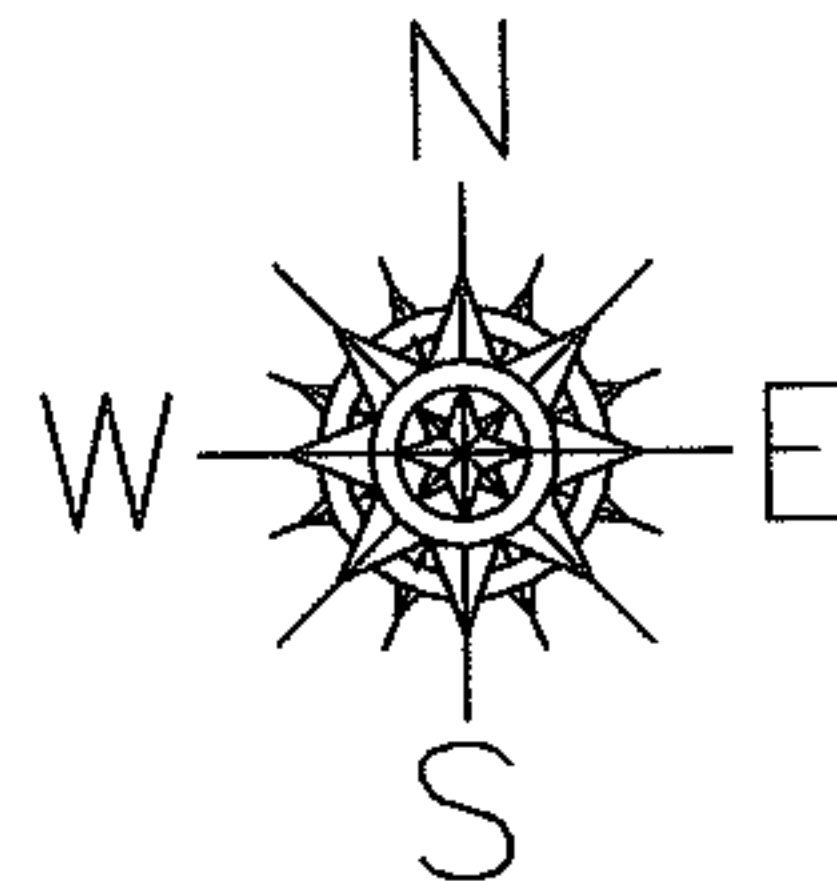

SPLITS/DEEDS PROCESSED

LORAIN COUNTY TAX MAP DEPARTMENT
226 MIDDLE AVE. ELYRIA, OHIO

SURVEYED BY: PATRICK MCGANNON

CLOSURE: 0.00 : 10.000

MAP PAGE(S): 04-00-017-B

APPROVED BY: JAH DATE: 5-23-05

SCALE: 1"= 100 PRIOR INSTRUMENT: 20030899267