


PARENT PARCEL: 15-00-060-000-024

09-01923-C



CHILD PARCEL: --SAME--

STARTING POINT: INT CL NICKLE PLATE DIAGONAL RD AND S.R. 303

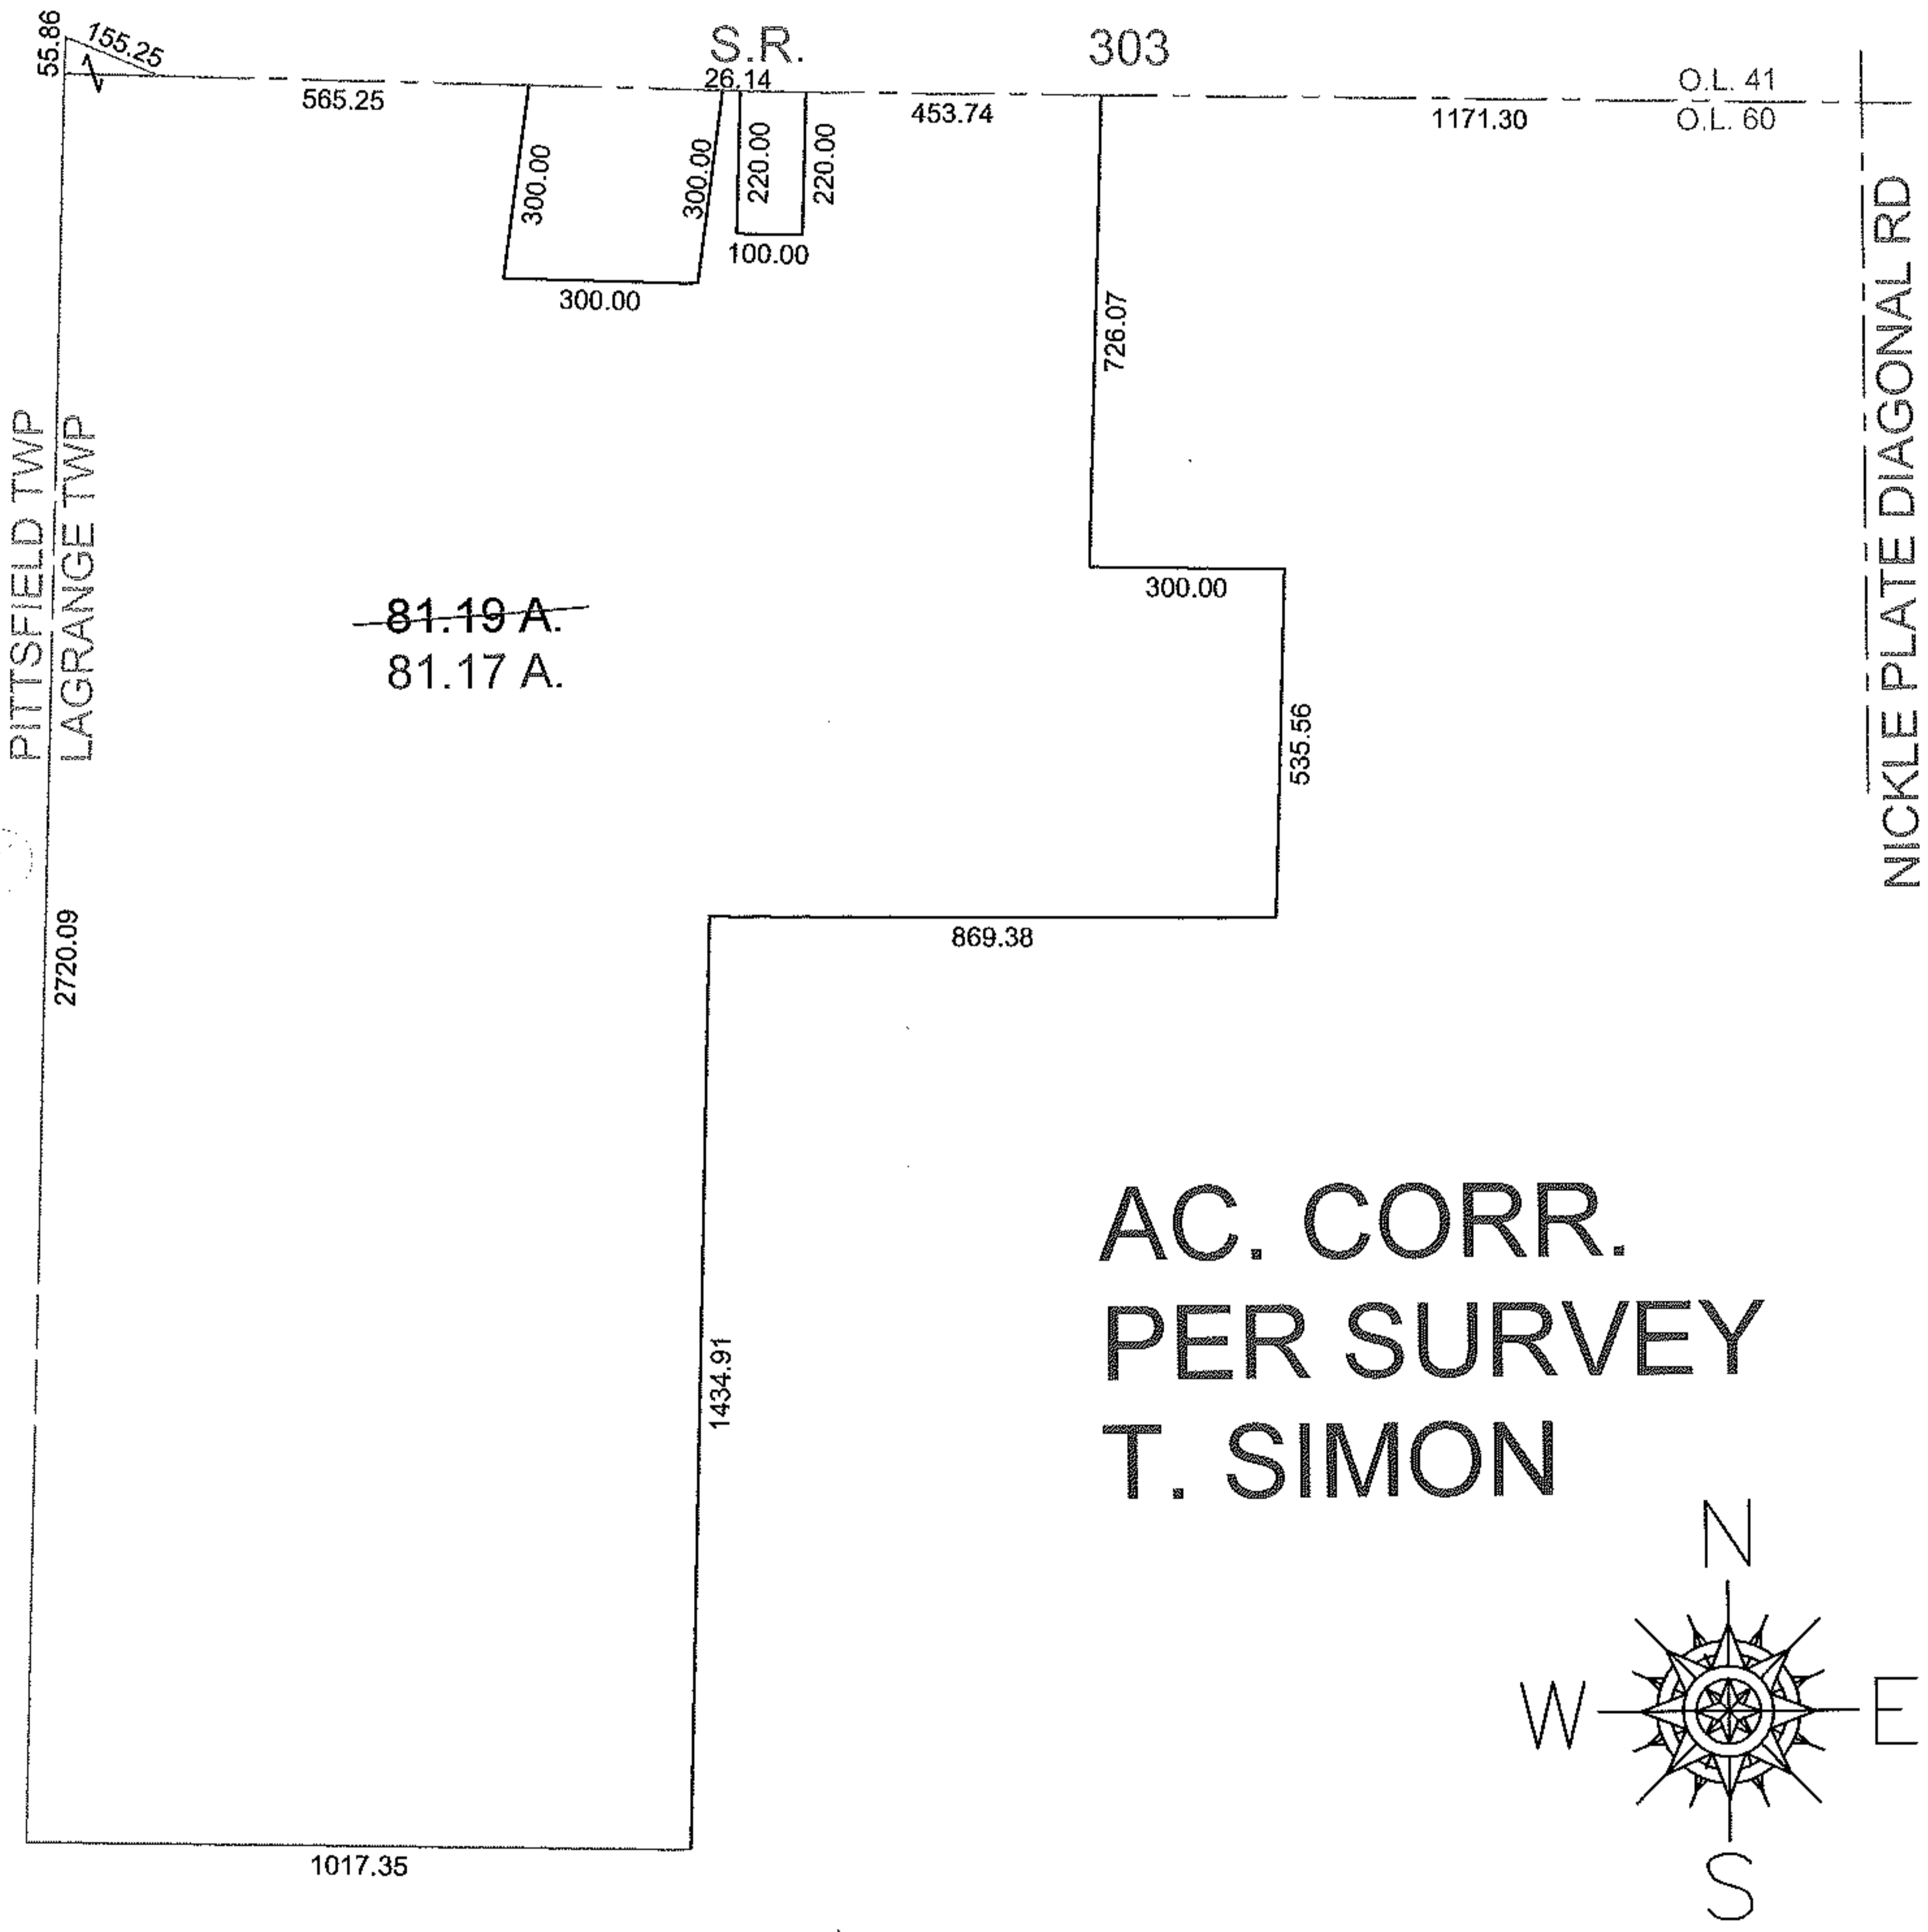

~~81.19 A.~~
81.17 A.

AC. CORR.
PER SURVEY
T. SIMON

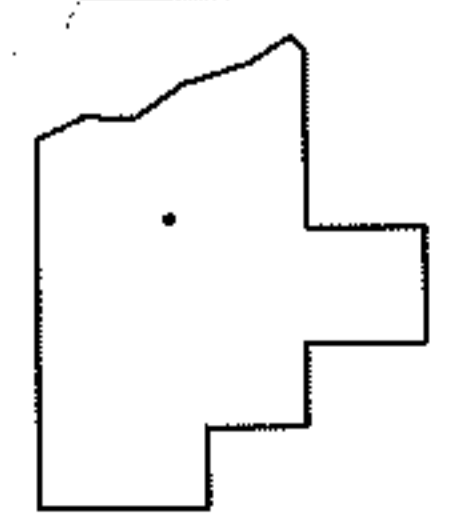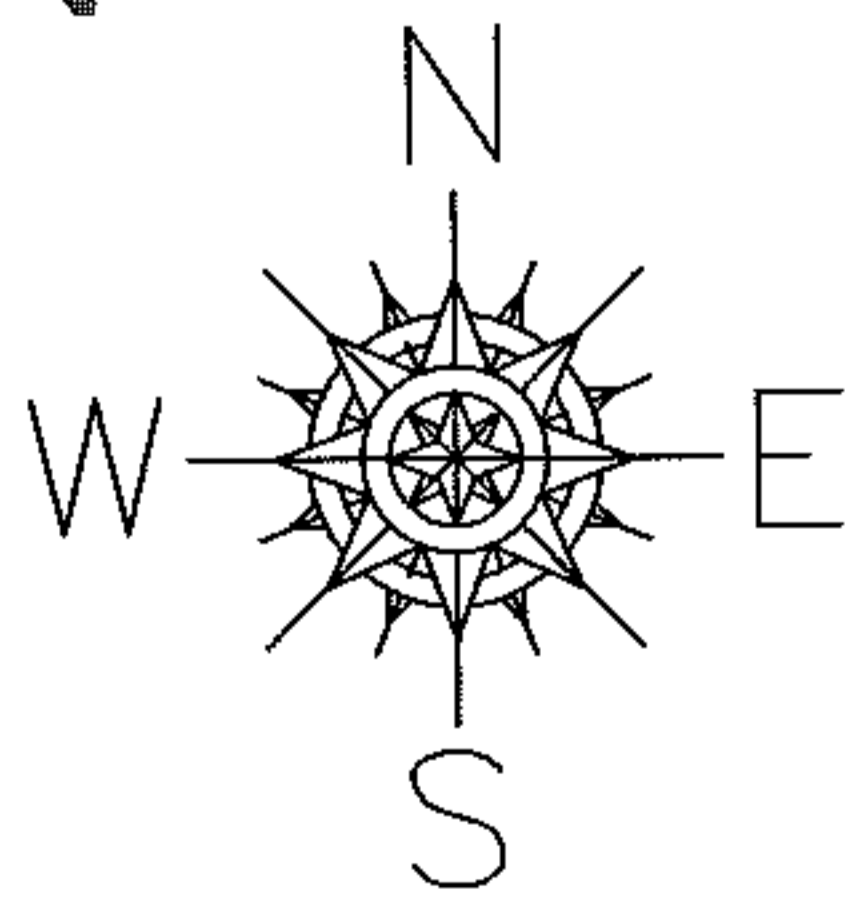

SPLITS/DEEDS PROCESSED

LORAIN COUNTY TAX MAP DEPARTMENT
226 MIDDLE AVE. ELYRIA, OHIO

SURVEYED BY: THOMAS A. SIMON
 CLOSURE: 1:10,000
 MAP PAGE(S): 15-00-060-A
 APPROVED BY: DRH DATE: 11/6/2009
 SCALE: 1"= 400 PRIOR INST.: 20030917832