




RASTER

PARENT PARCEL: 02-01-008-101-357

CHILD PARCEL: 02-01-008-101-381, -382

STARTING POINT: SOUTHWEST CORNER OF NOTTINGHAM WOODS SUBD.

NO. 01924

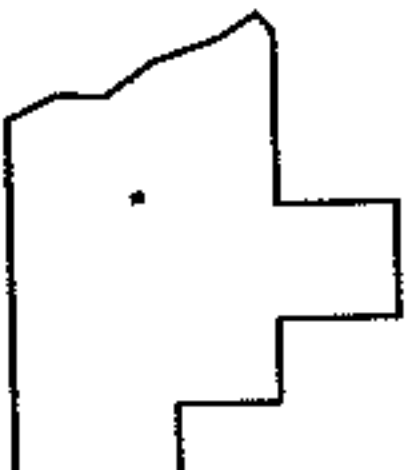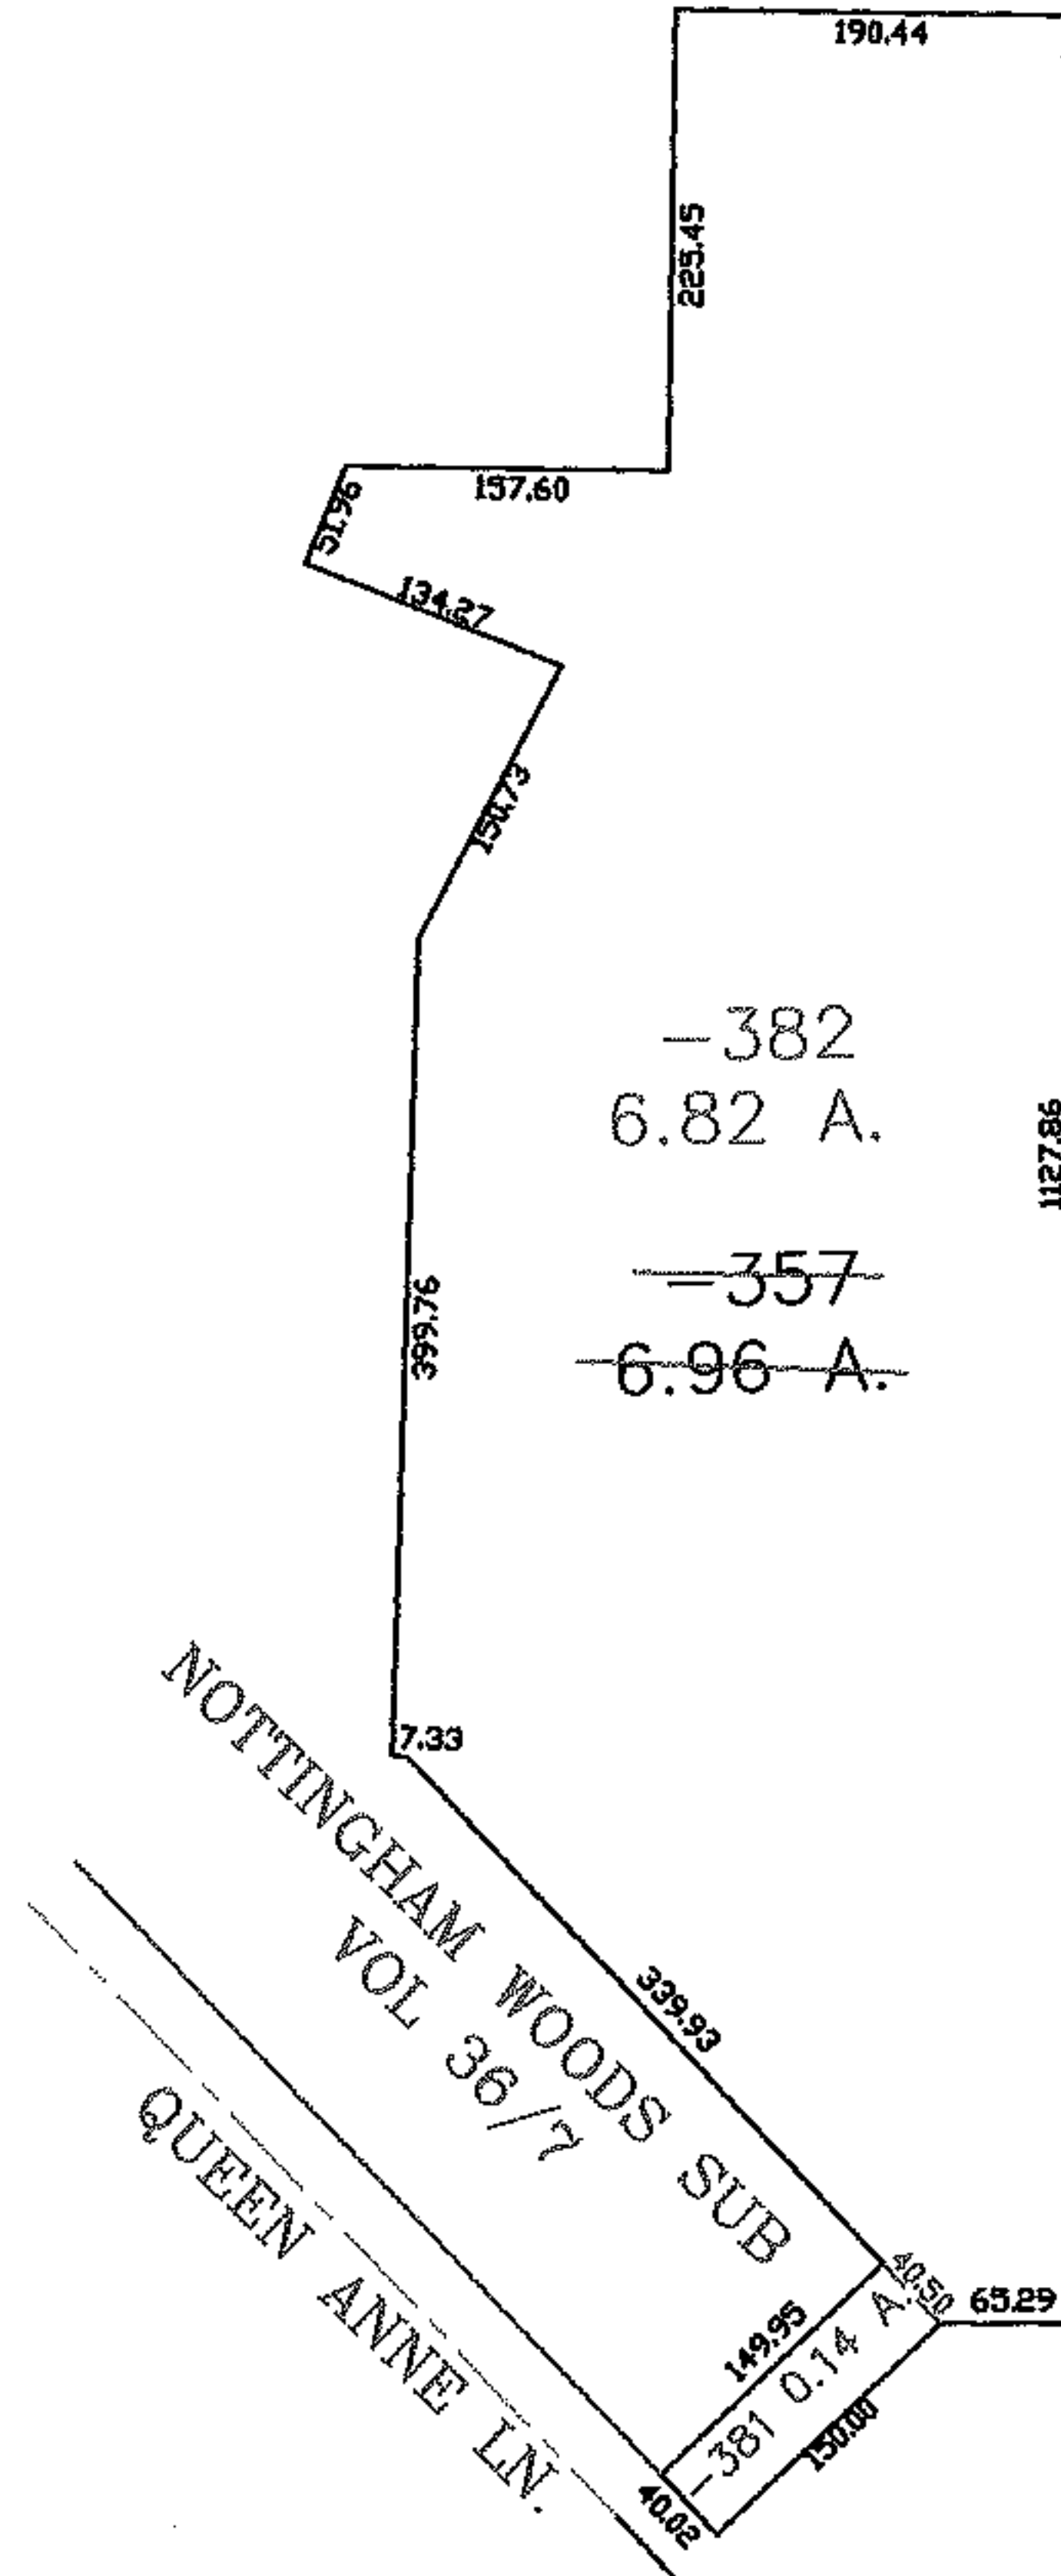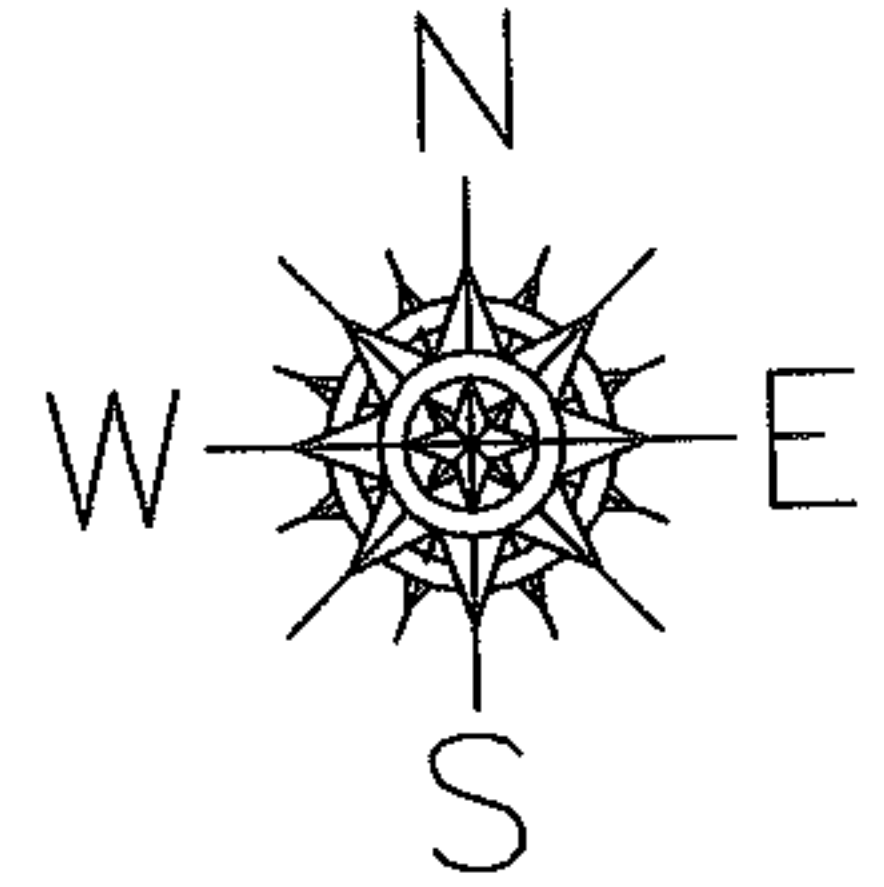

SPLITS/DEEDS PROCESSED
LORAIN COUNTY TAX MAP DEPARTMENT
 226 MIDDLE AVE. ELYRIA, OHIO

SURVEYED BY: PATRICK A. MCGANNON
 CLOSURE: 0.00 : 10.000
 MAP PAGE(S): 02-01-008-A
 APPROVED BY: JAH DATE: 5-25-05
 SCALE: 1" = 200 PRIOR INSTRUMENT: PL 36/7