
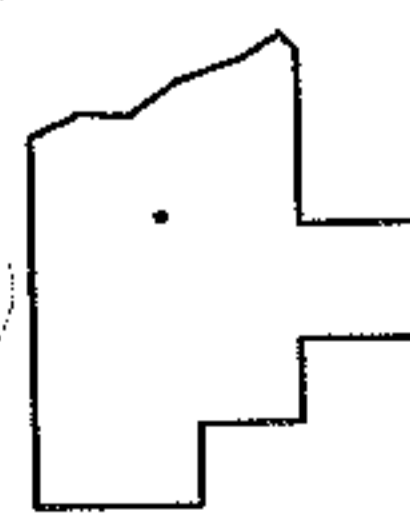
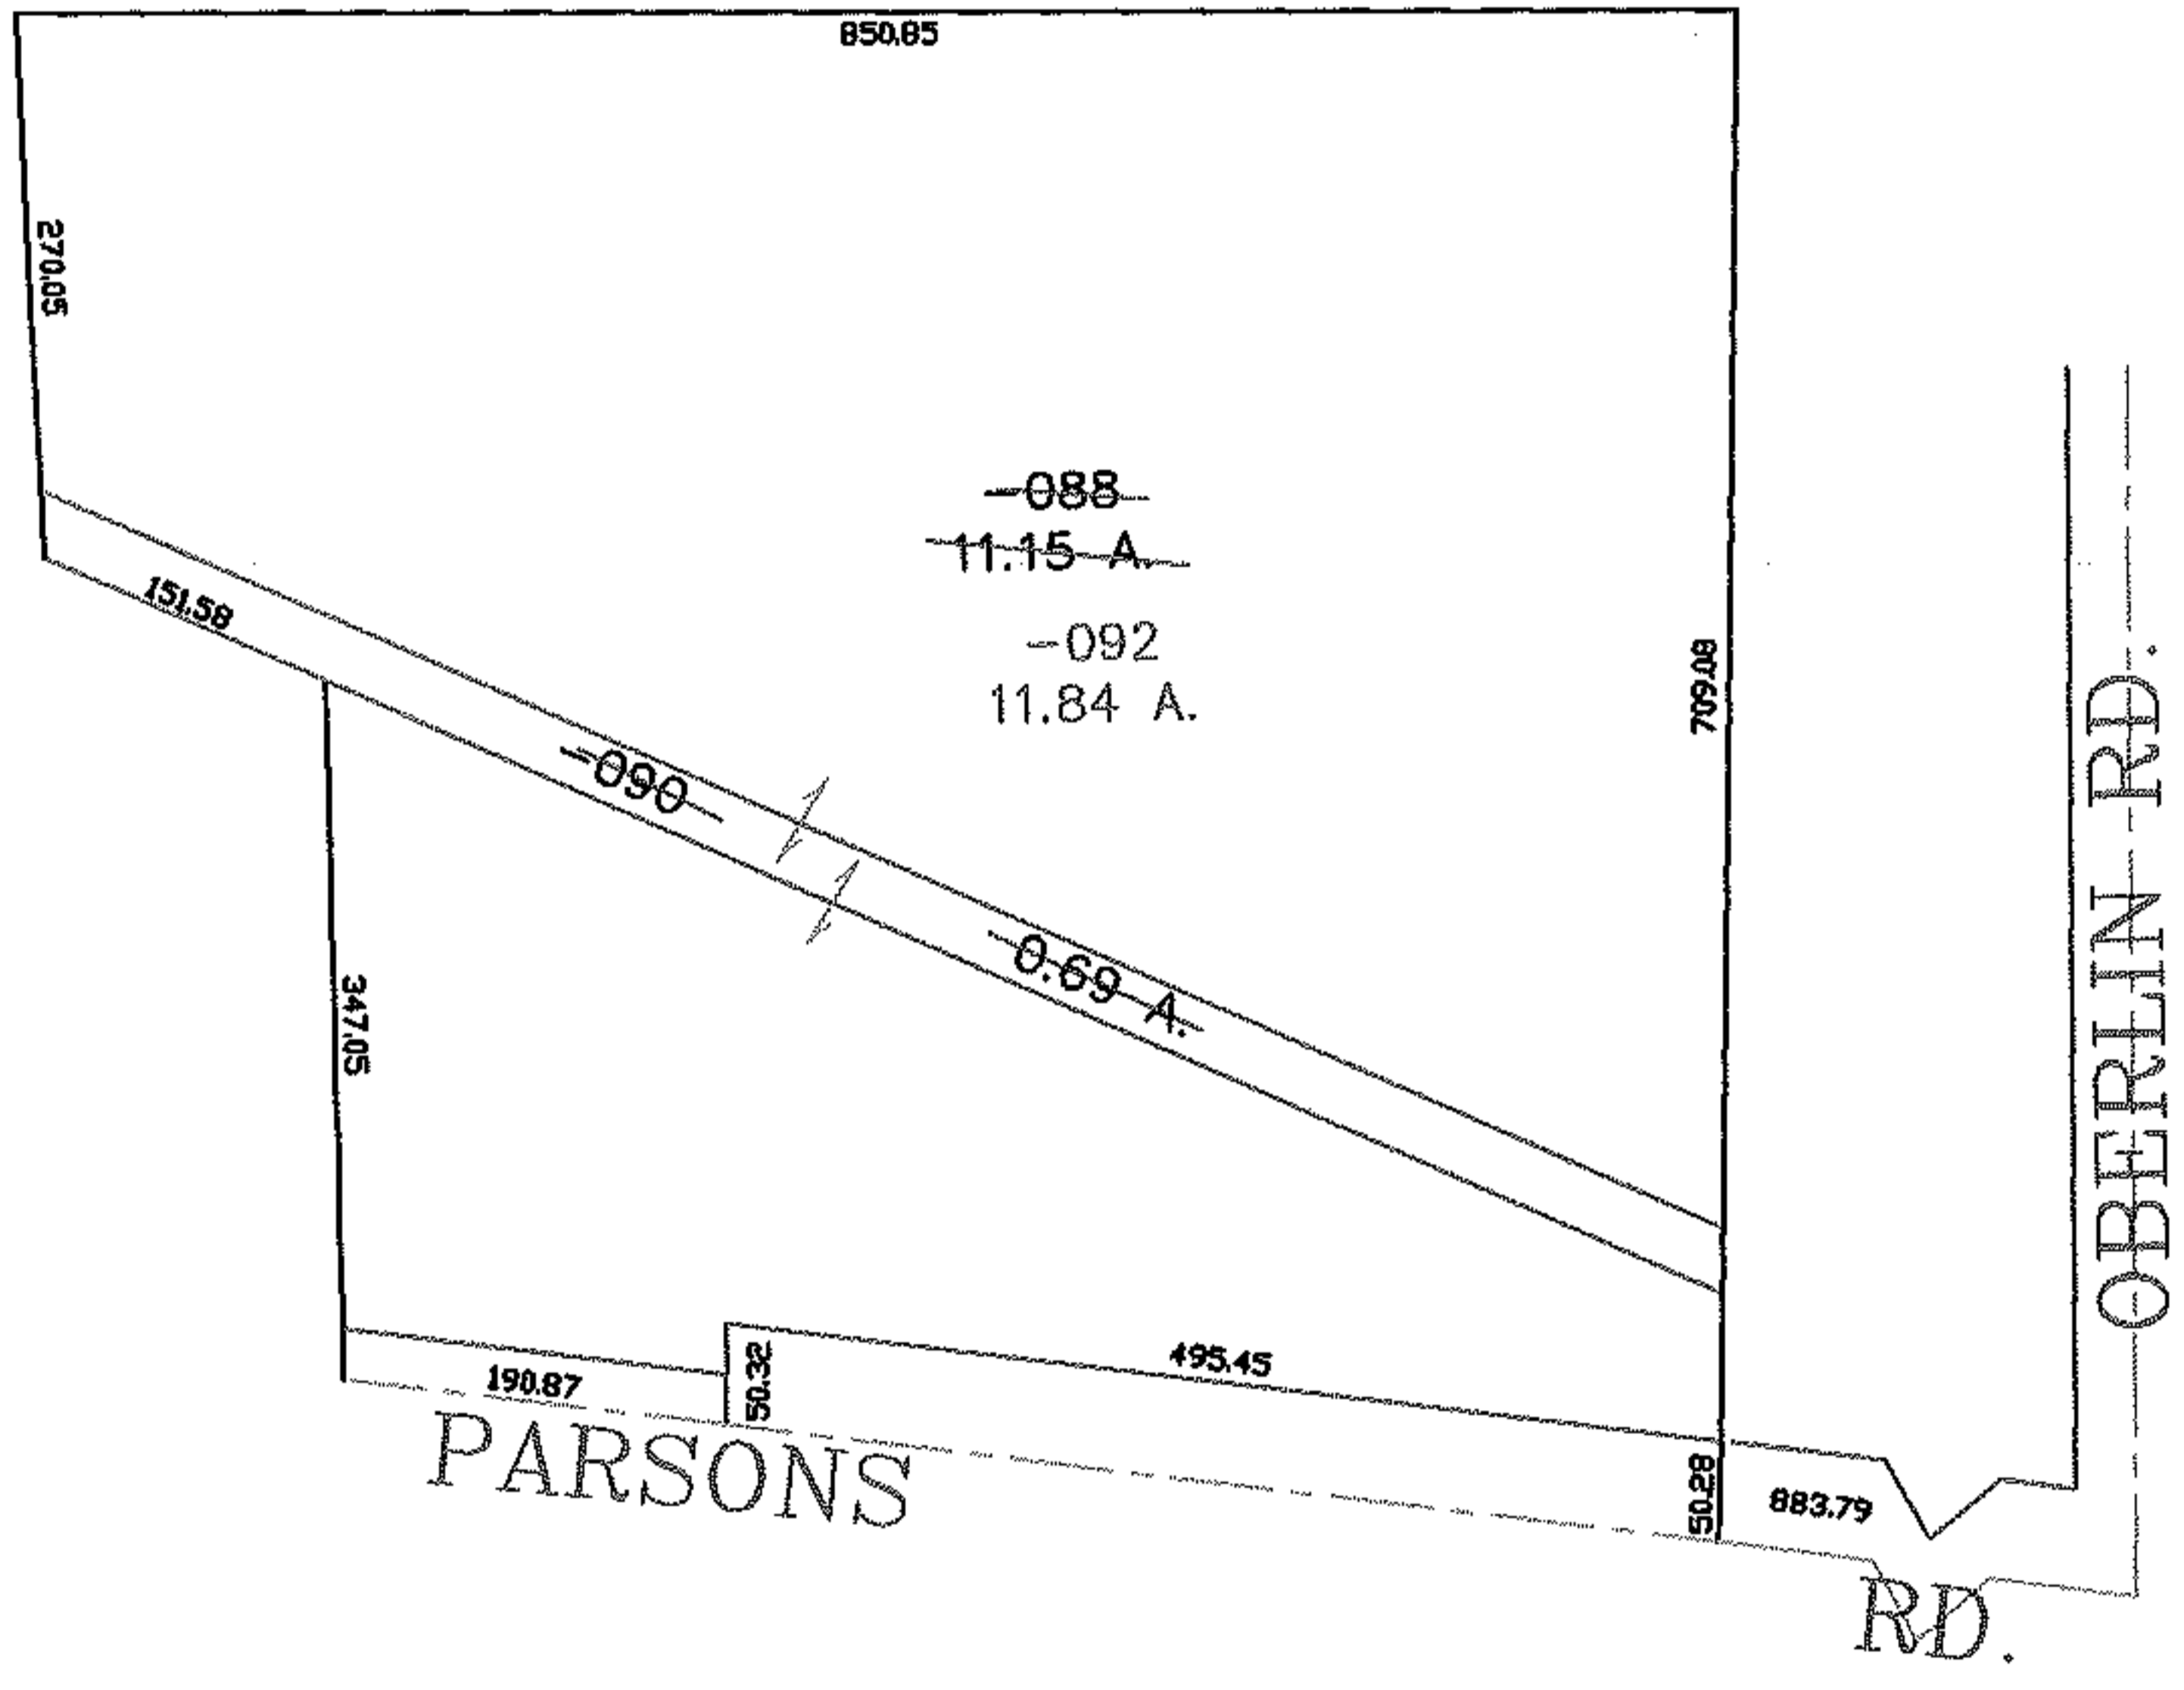


MASTER

PARENT PARCEL: 09-00-097-000-090, -088
CHILD PARCEL: 09-00-097-000-092
STARTING POINT: CENTERLINE OF PARSONS RD. & OBERLIN RD.

NO. 01925

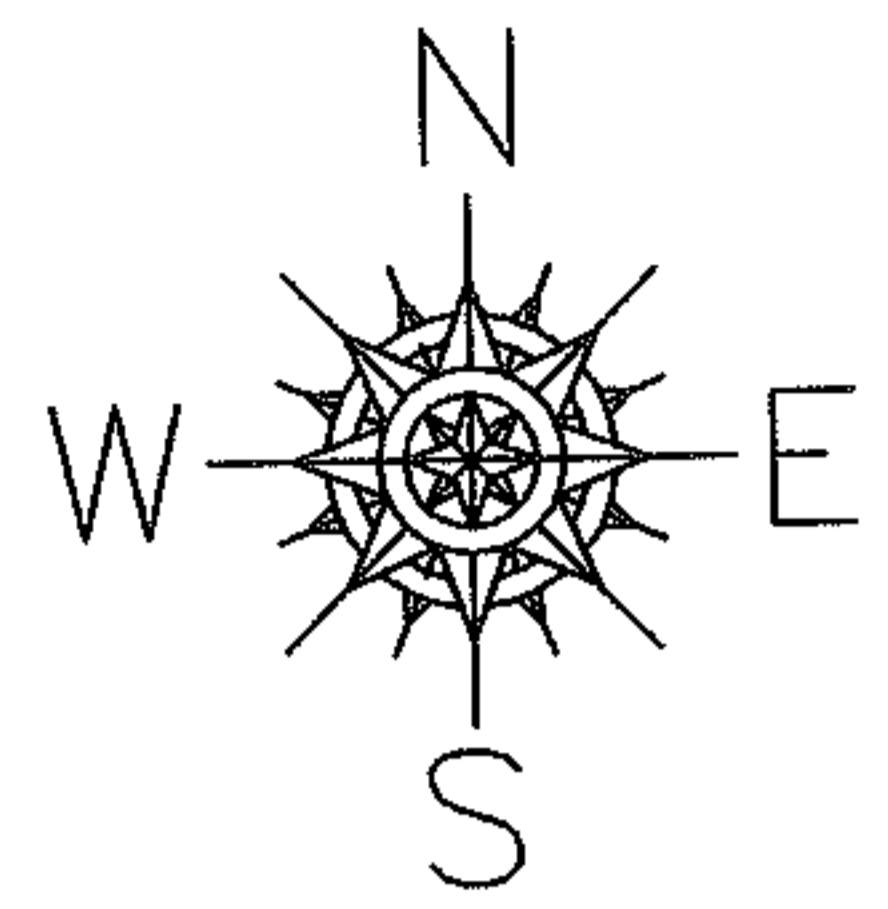

SPLITS/DEEDS PROCESSED
LORAIN COUNTY TAX MAP DEPARTMENT
226 MIDDLE AVE. ELYRIA, OHIO

SURVEYED BY: ALEX KELSER
CLOSURE: 0.00 : 10.000
MAP PAGE(S): 09-00-097-B
APPROVED BY: JAH DATE: 5-25-05
SCALE: 1" = 200 PRIOR INSTRUMENT: 2005059057