
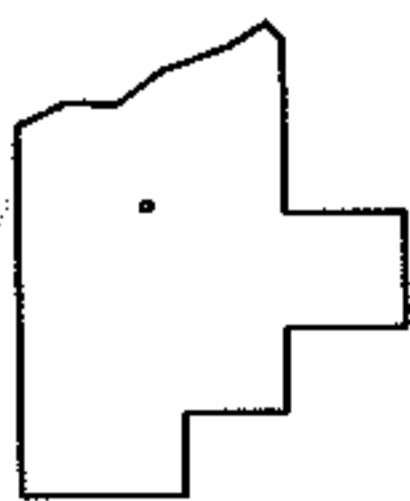
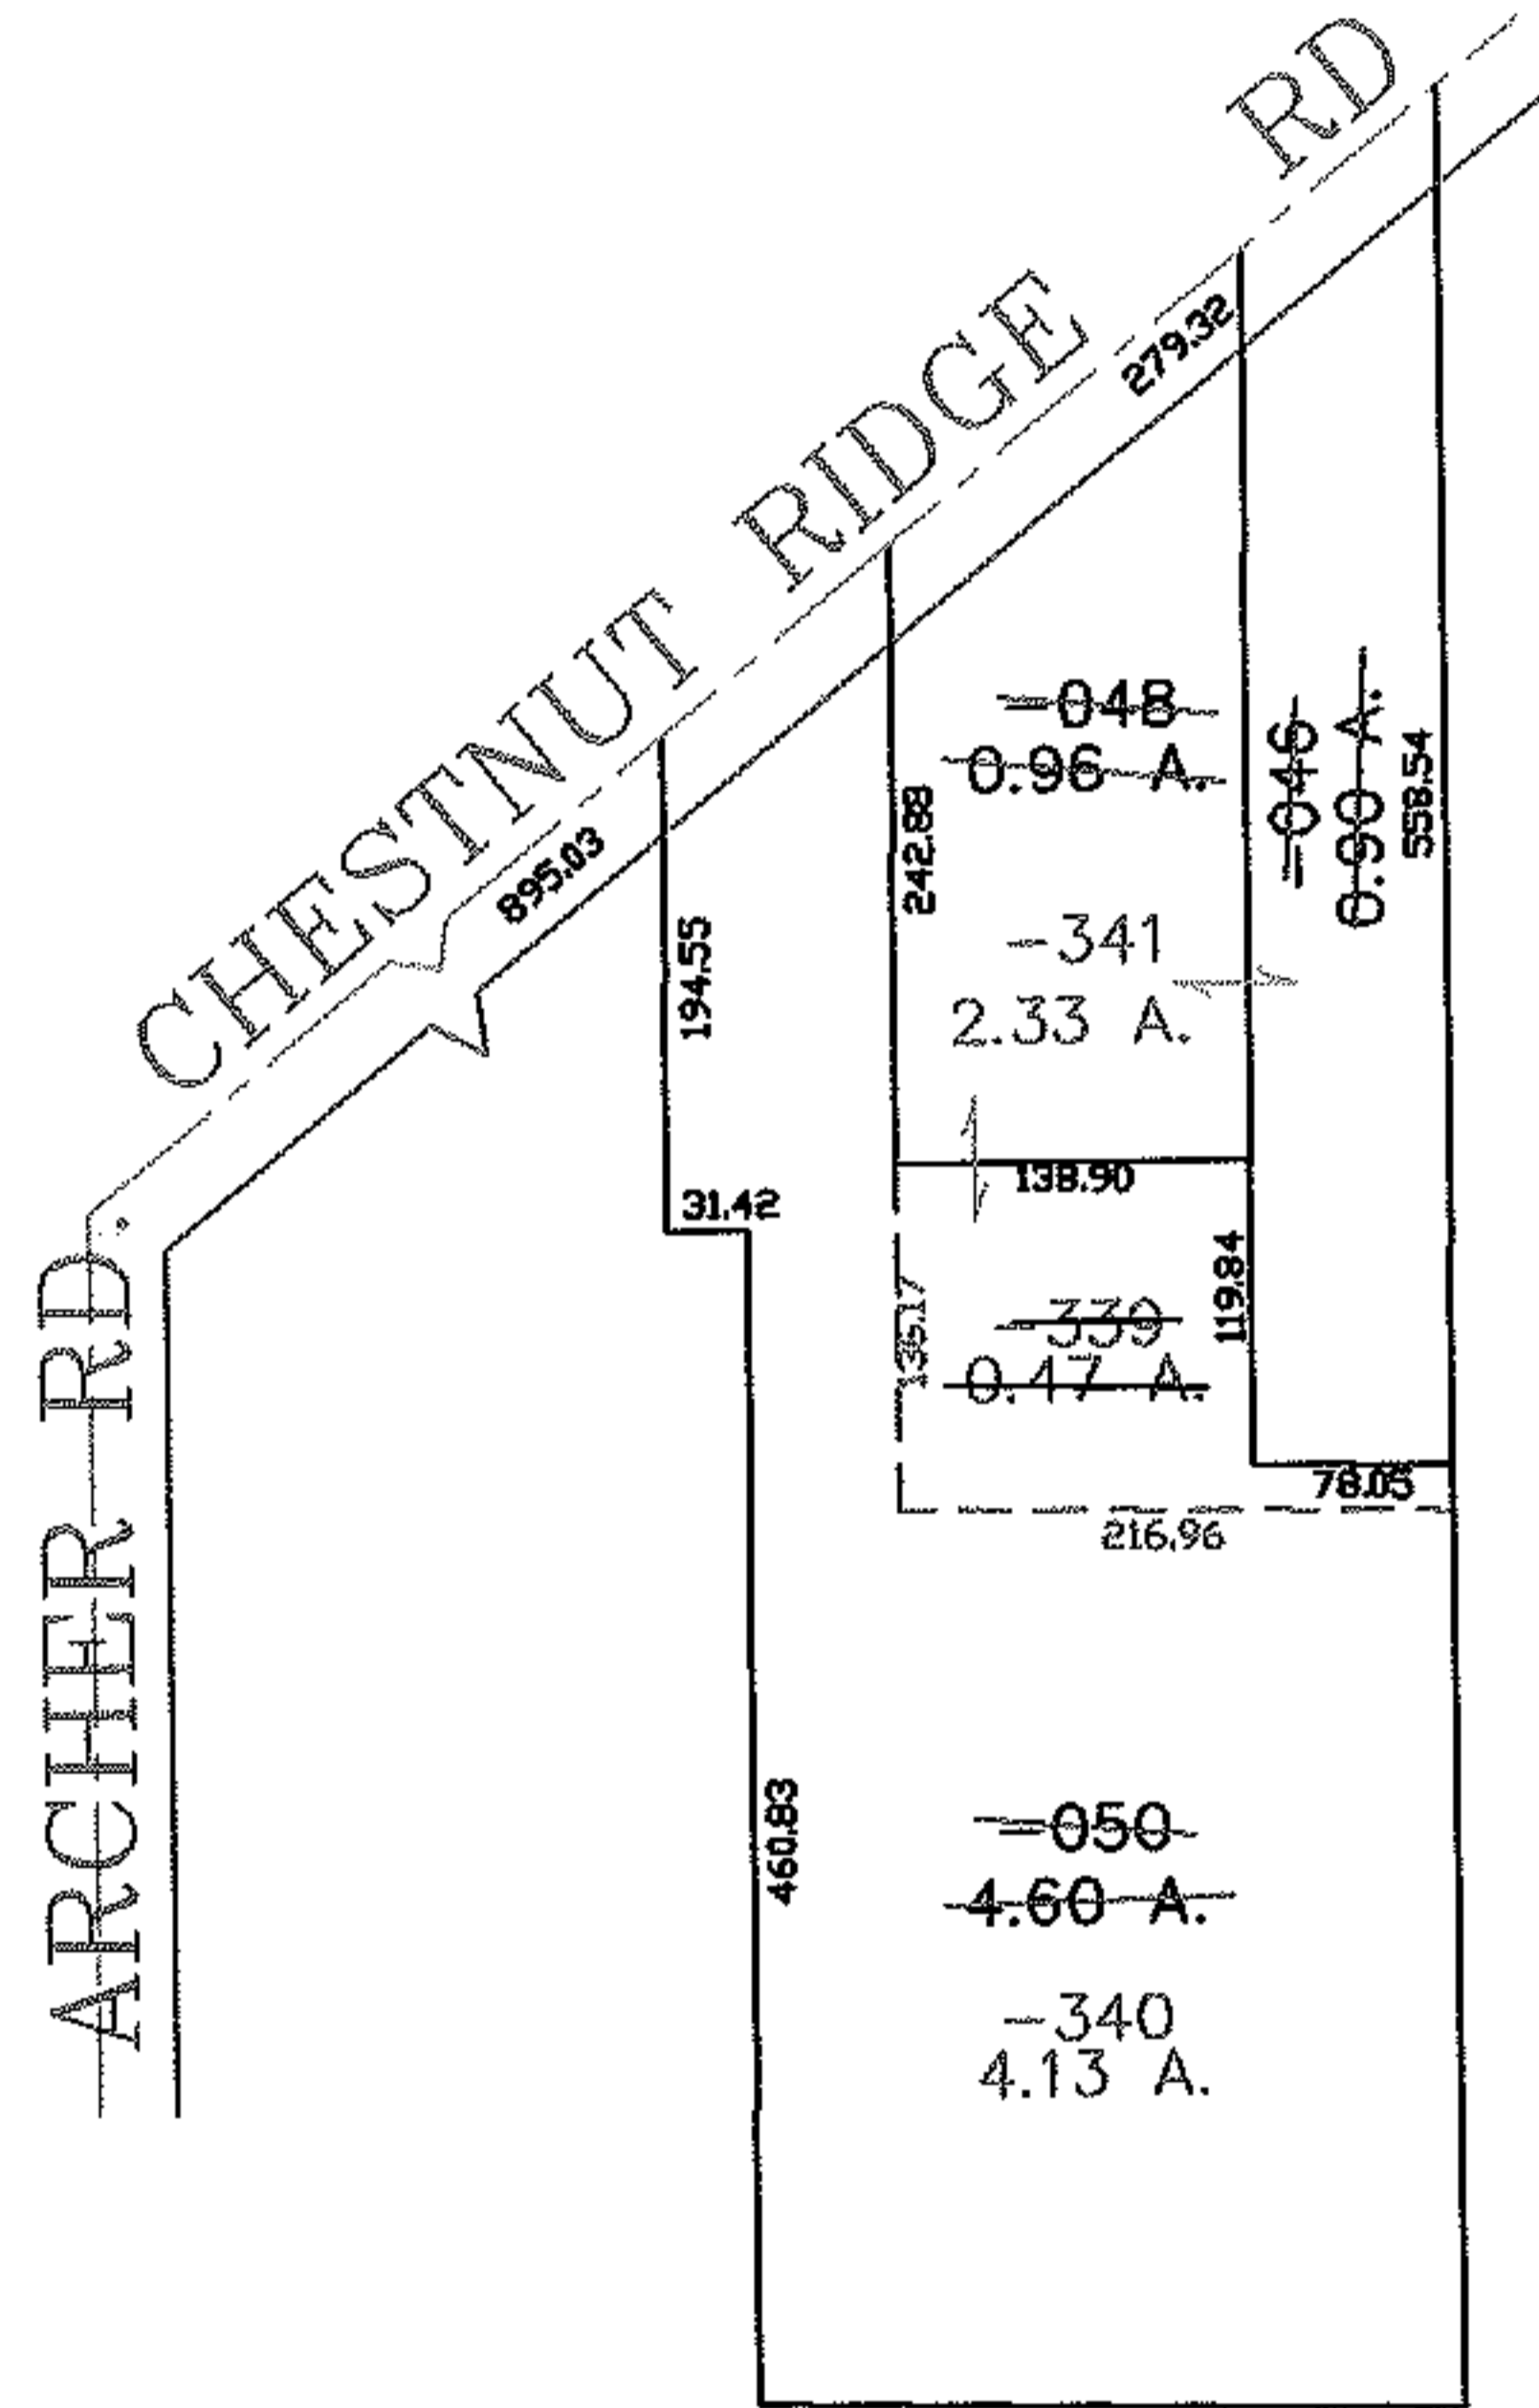


PARENT PARCEL: 07-00-036-000-050, -046, -048

CHILD PARCEL: 07-00-036-000-339 THRU -341

STARTING POINT: CENTERLINE OF ARCHER RD. & CHESTNUT RIDGE RD.

NO. 01926

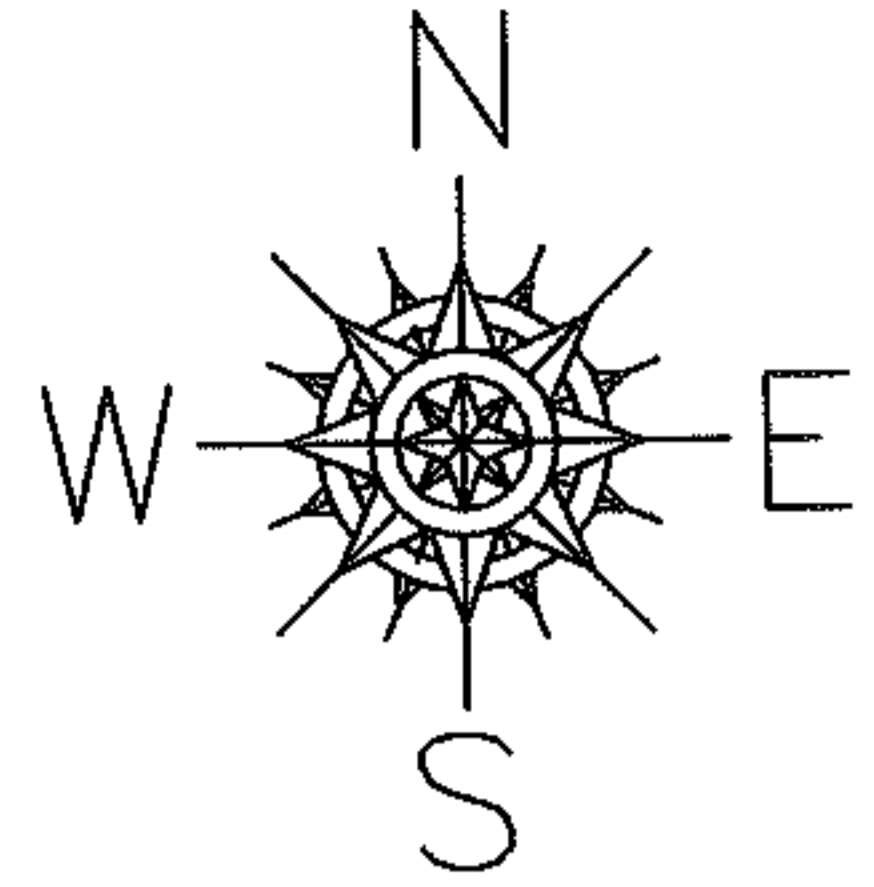

SPLITS/DEEDS PROCESSED
 LORAIN COUNTY TAX MAP DEPARTMENT
 226 MIDDLE AVE. ELYRIA, OHIO

SURVEYED BY: DAVID ELWELL
 CLOSURE: 0.00 : 10.000
 MAP PAGE(S): XX-XX-XXX
 APPROVED BY: JAH DATE: 5-27-05
 SCALE: 1" = 200 PRIOR INSTRUMENT: 20050061818