




HASTER

PARENT PARCEL: 16-00-044-000-037

CHILD PARCEL: 16-00-044-000-040, -041

STARTING POINT: CENTERLINE OF WAKEMAN-BELDEN RD. & O.L. 44

NO. 01928

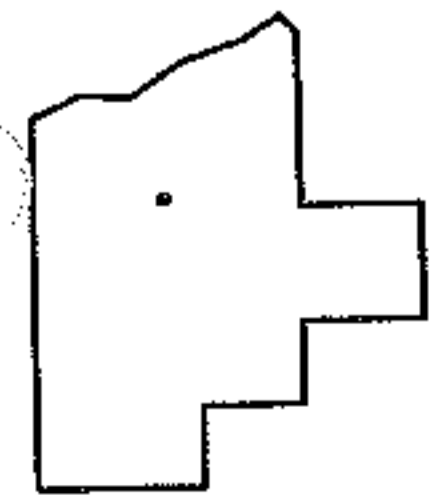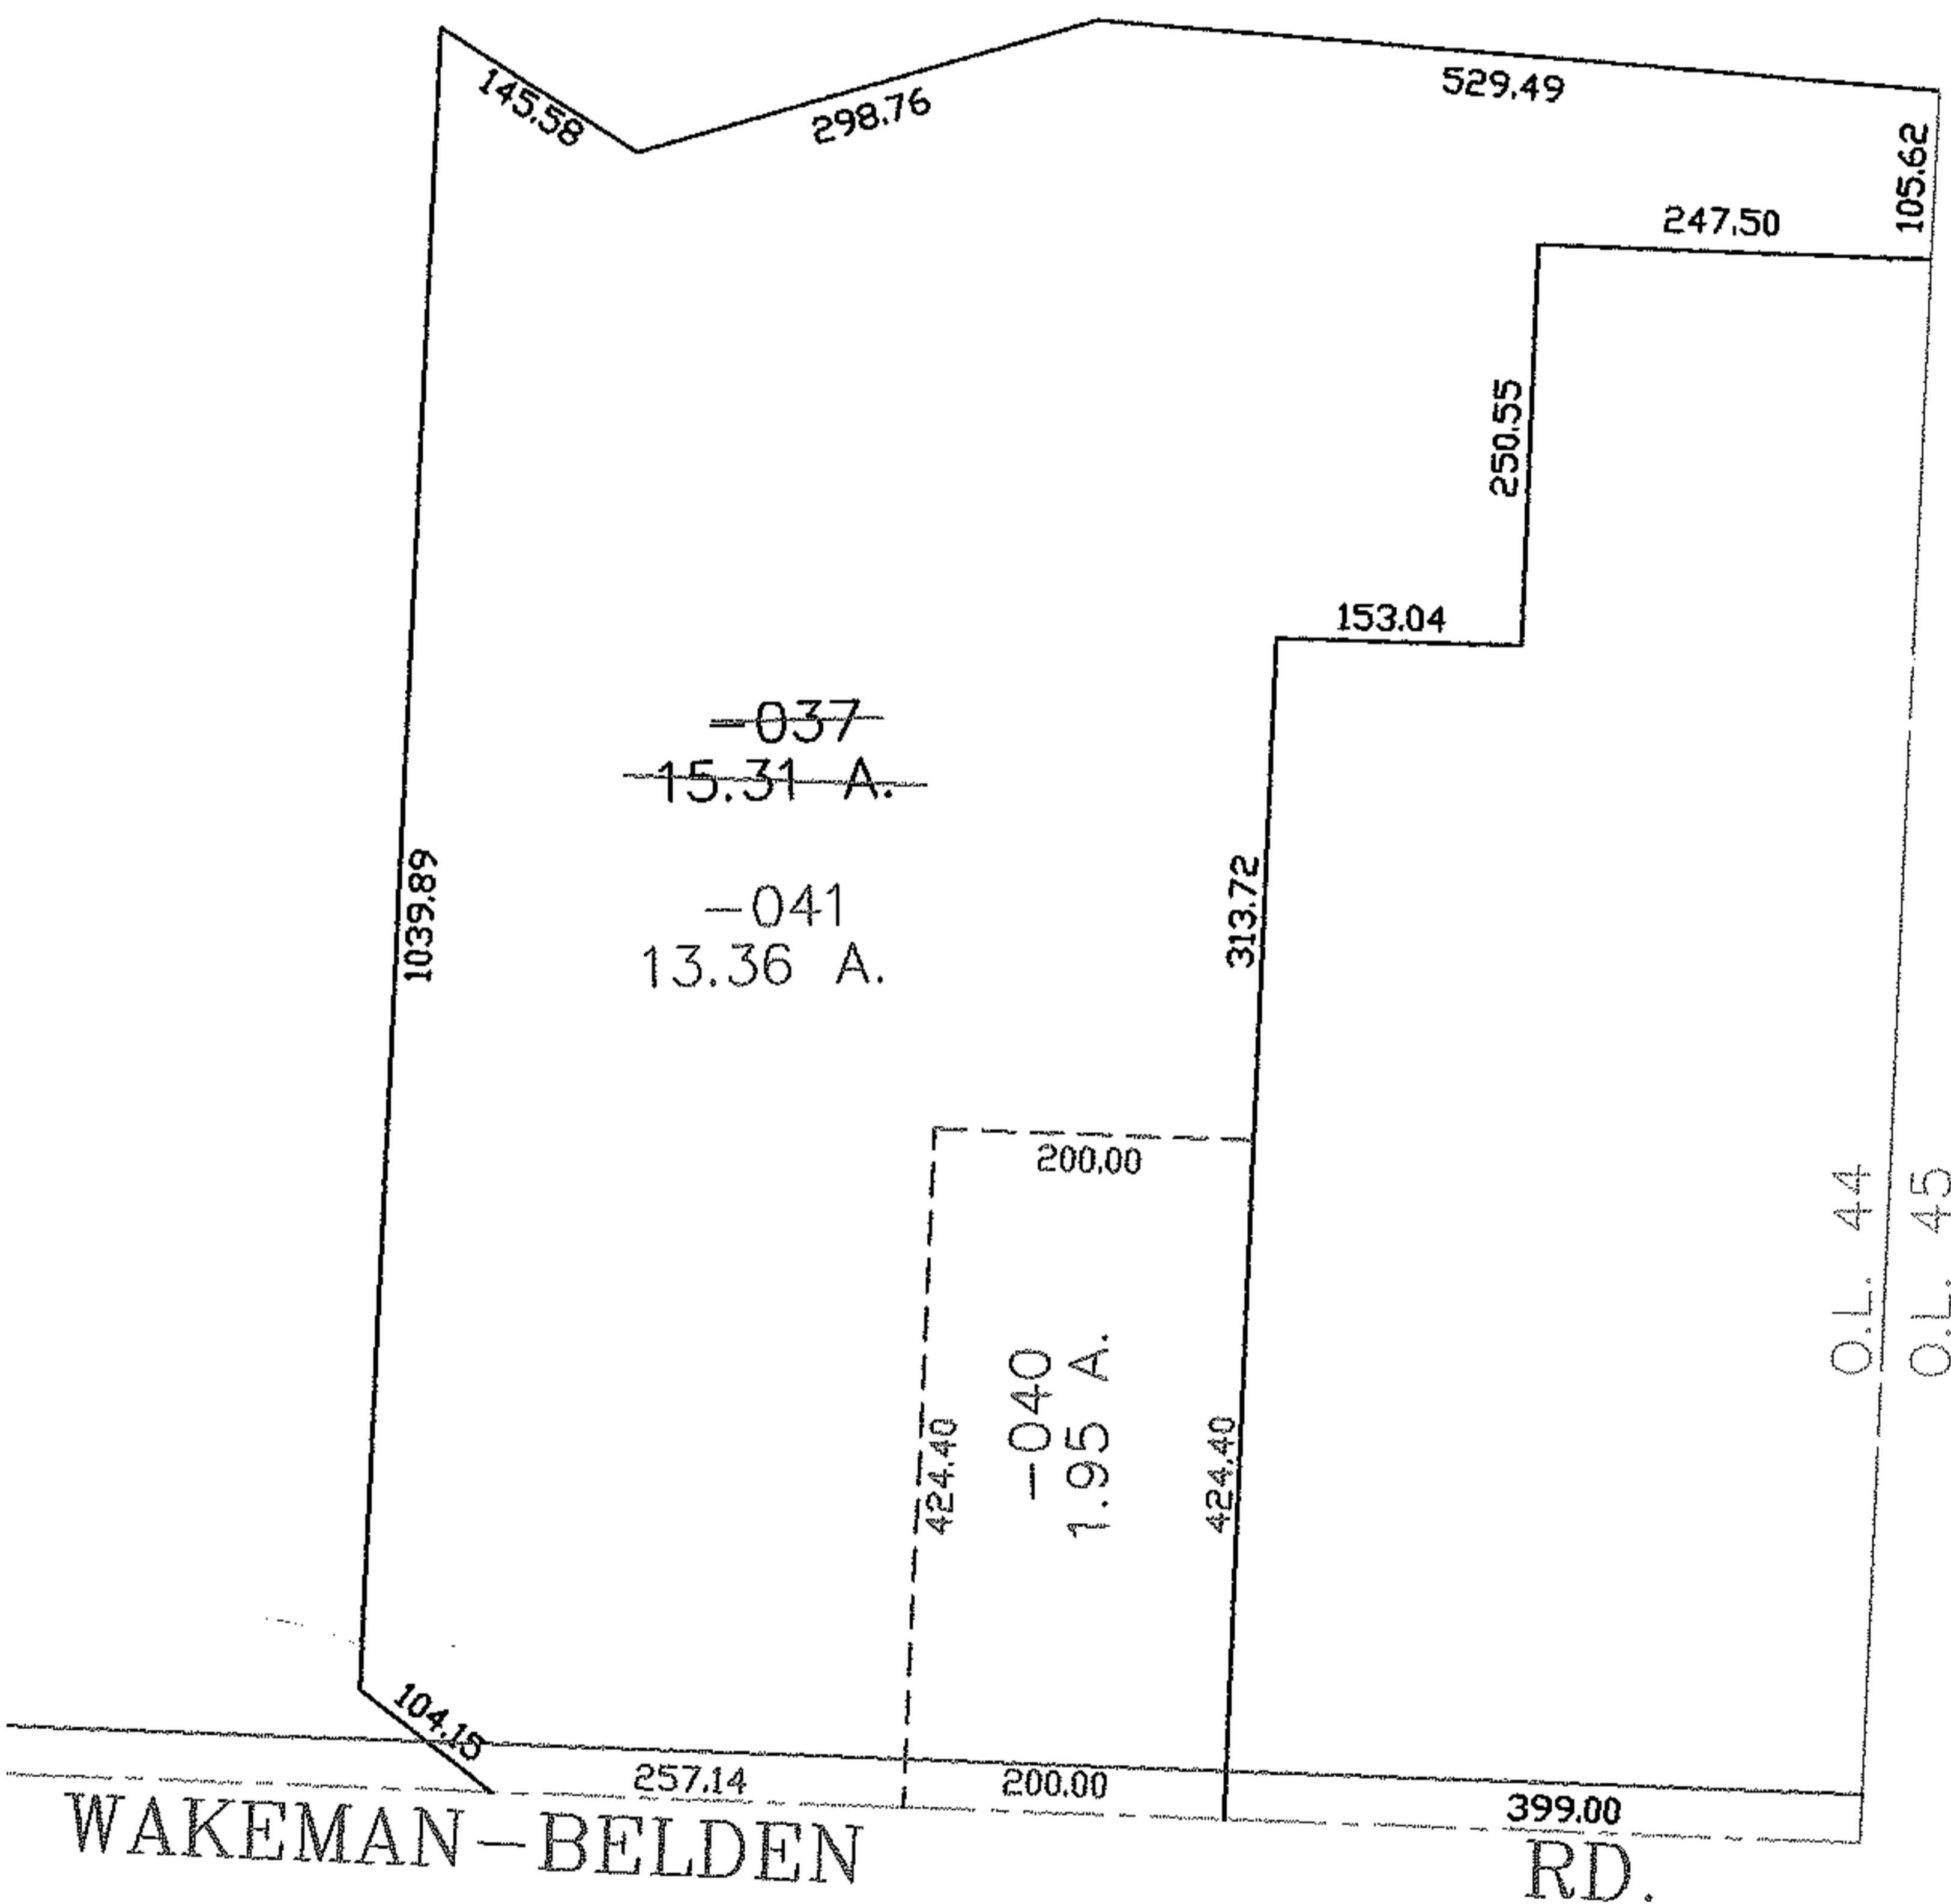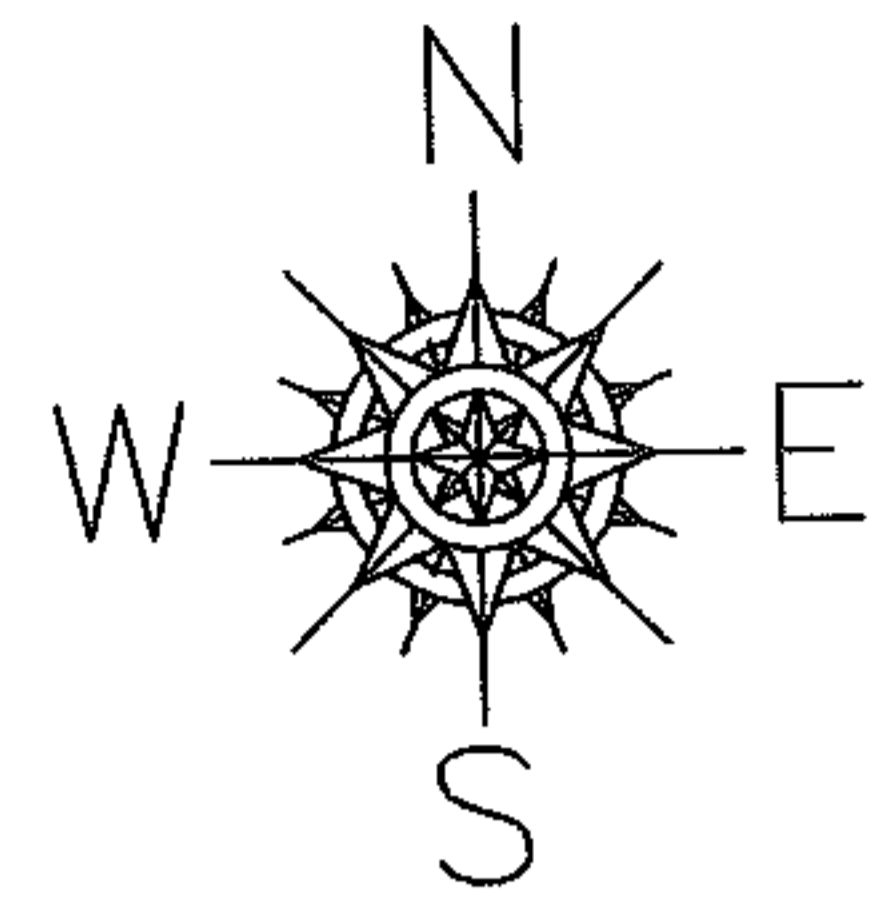

SPLITS/DEEDS PROCESSED
LORAIN COUNTY TAX MAP DEPARTMENT
 226 MIDDLE AVE. ELYRIA, OHIO

SURVEYED BY: RICHARD CARLSON
 CLOSURE: 0.00 : 10.000
 MAP PAGE(S): 16-00-044-B
 APPROVED BY: JAH DATE: 6-2-05
 SCALE: 1" = 200 PRIOR INSTRUMENT: 20050049971