


PARENT PARCEL: 02-01-002-101-020, -019, -021


CHILD PARCEL: 02-01-002-101-028, -029

STARTING POINT: CENTERLINE OF LAKESIDE AVE & DELEWARE CT.

NO. 01930

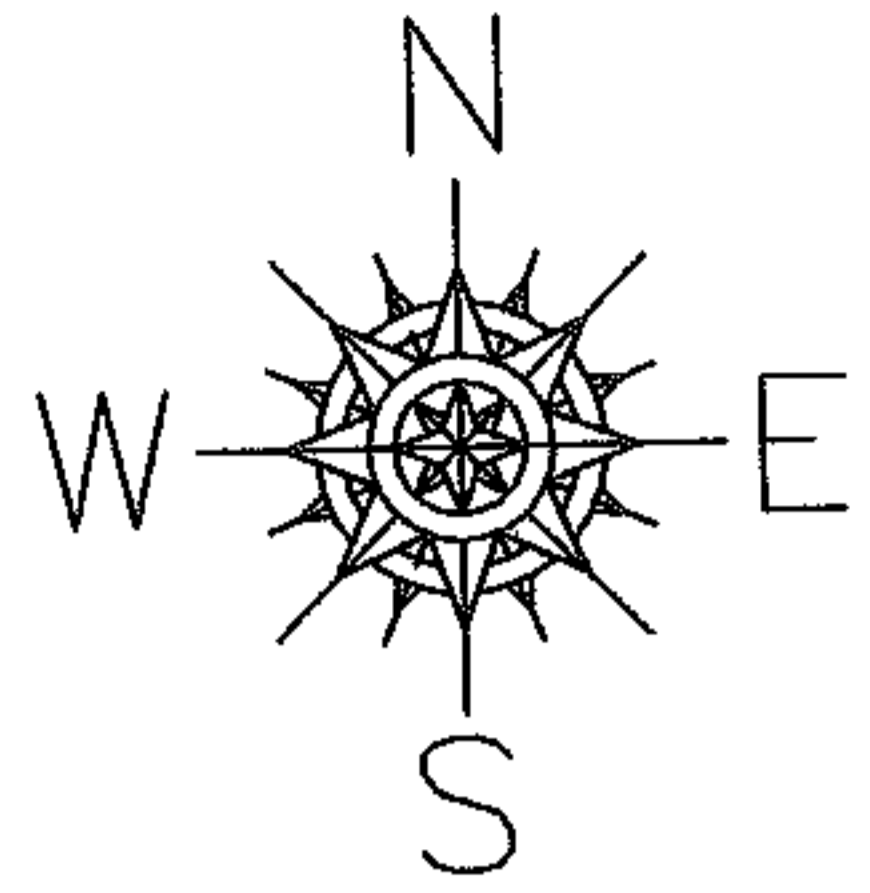

SCHULTZ & FARAGHER ADD.
VOL 6 PG 25

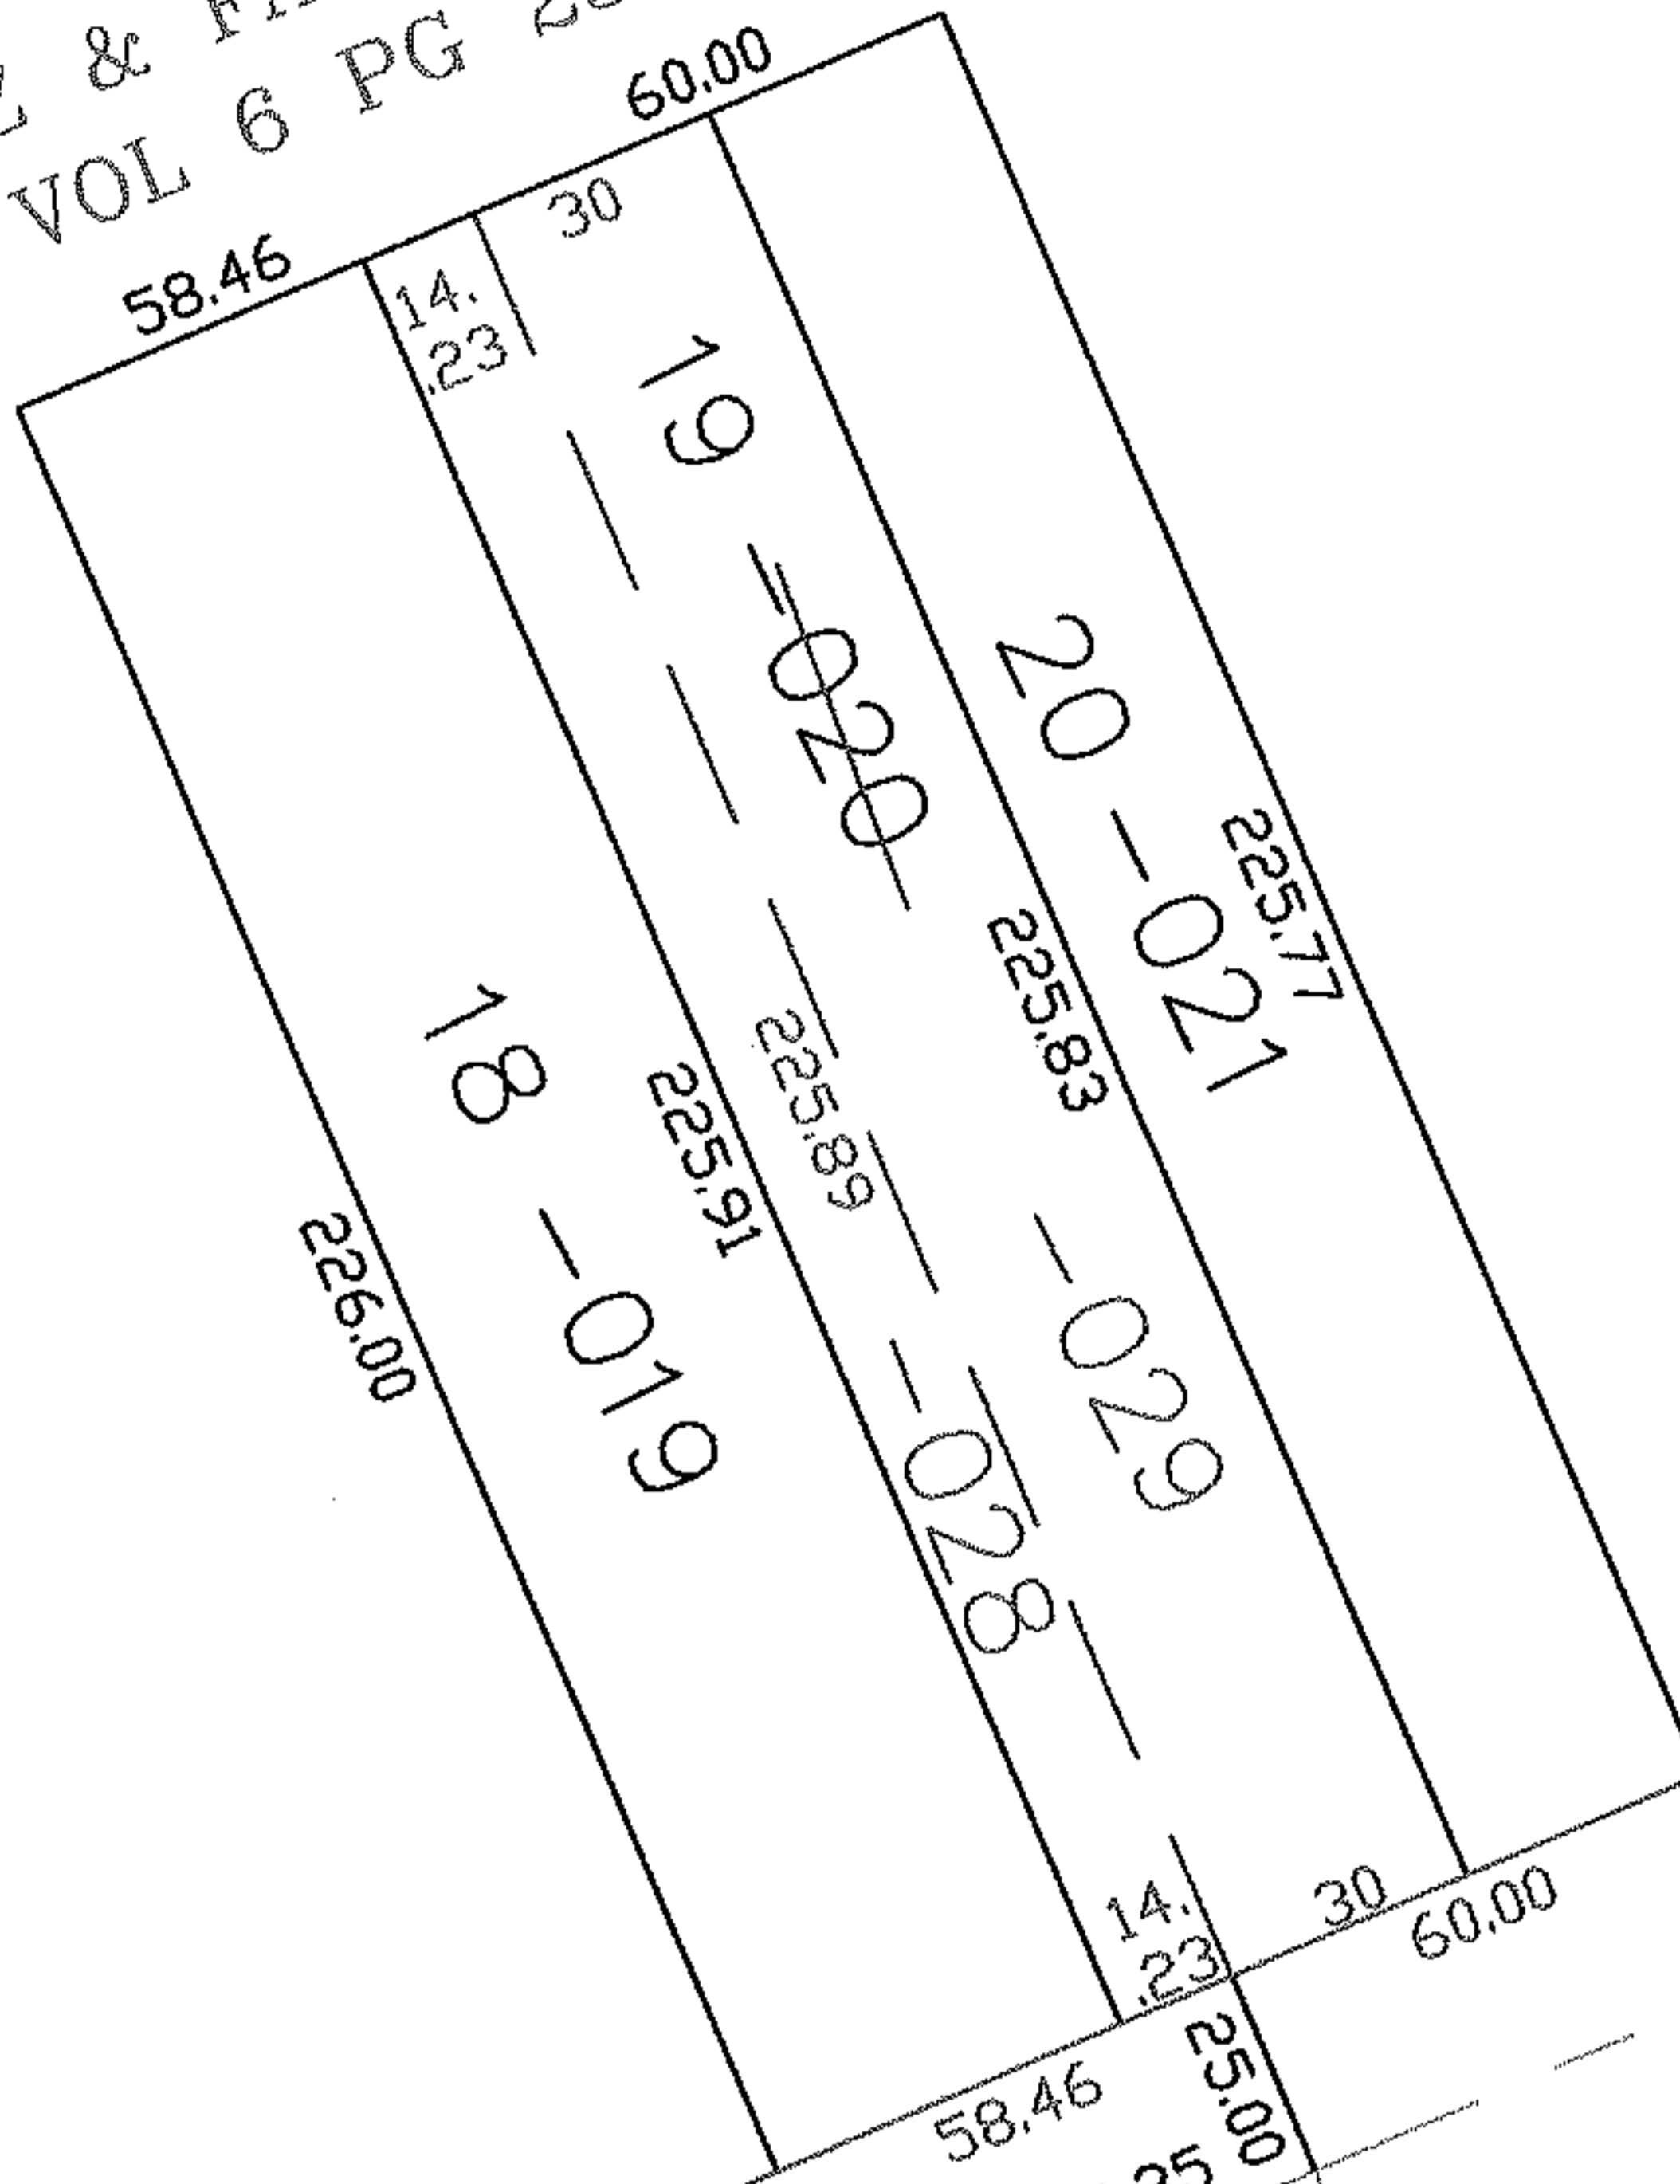

LAKESIDE AVE.
DELEWARE CT

SPLITS/DEEDS PROCESSED

LORAIN COUNTY TAX MAP DEPARTMENT
226 MIDDLE AVE. ELYRIA, OHIO

SURVEYED BY: THOMAS SIMON

CLOSURE: 0.00 : 10.000

MAP PAGE(S): 02-01-003-A

APPROVED BY: JAH DATE: 6-8-05

SCALE: 1" = 100 PRIOR INSTRUMENT: PL VL 6/25