
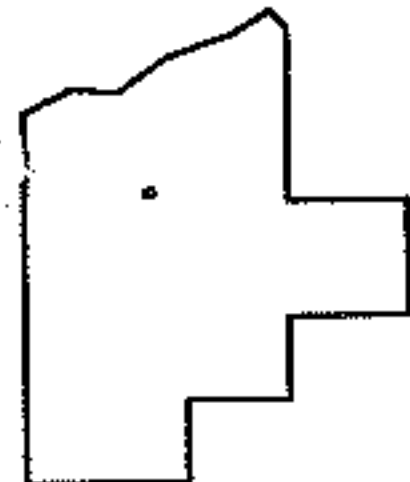
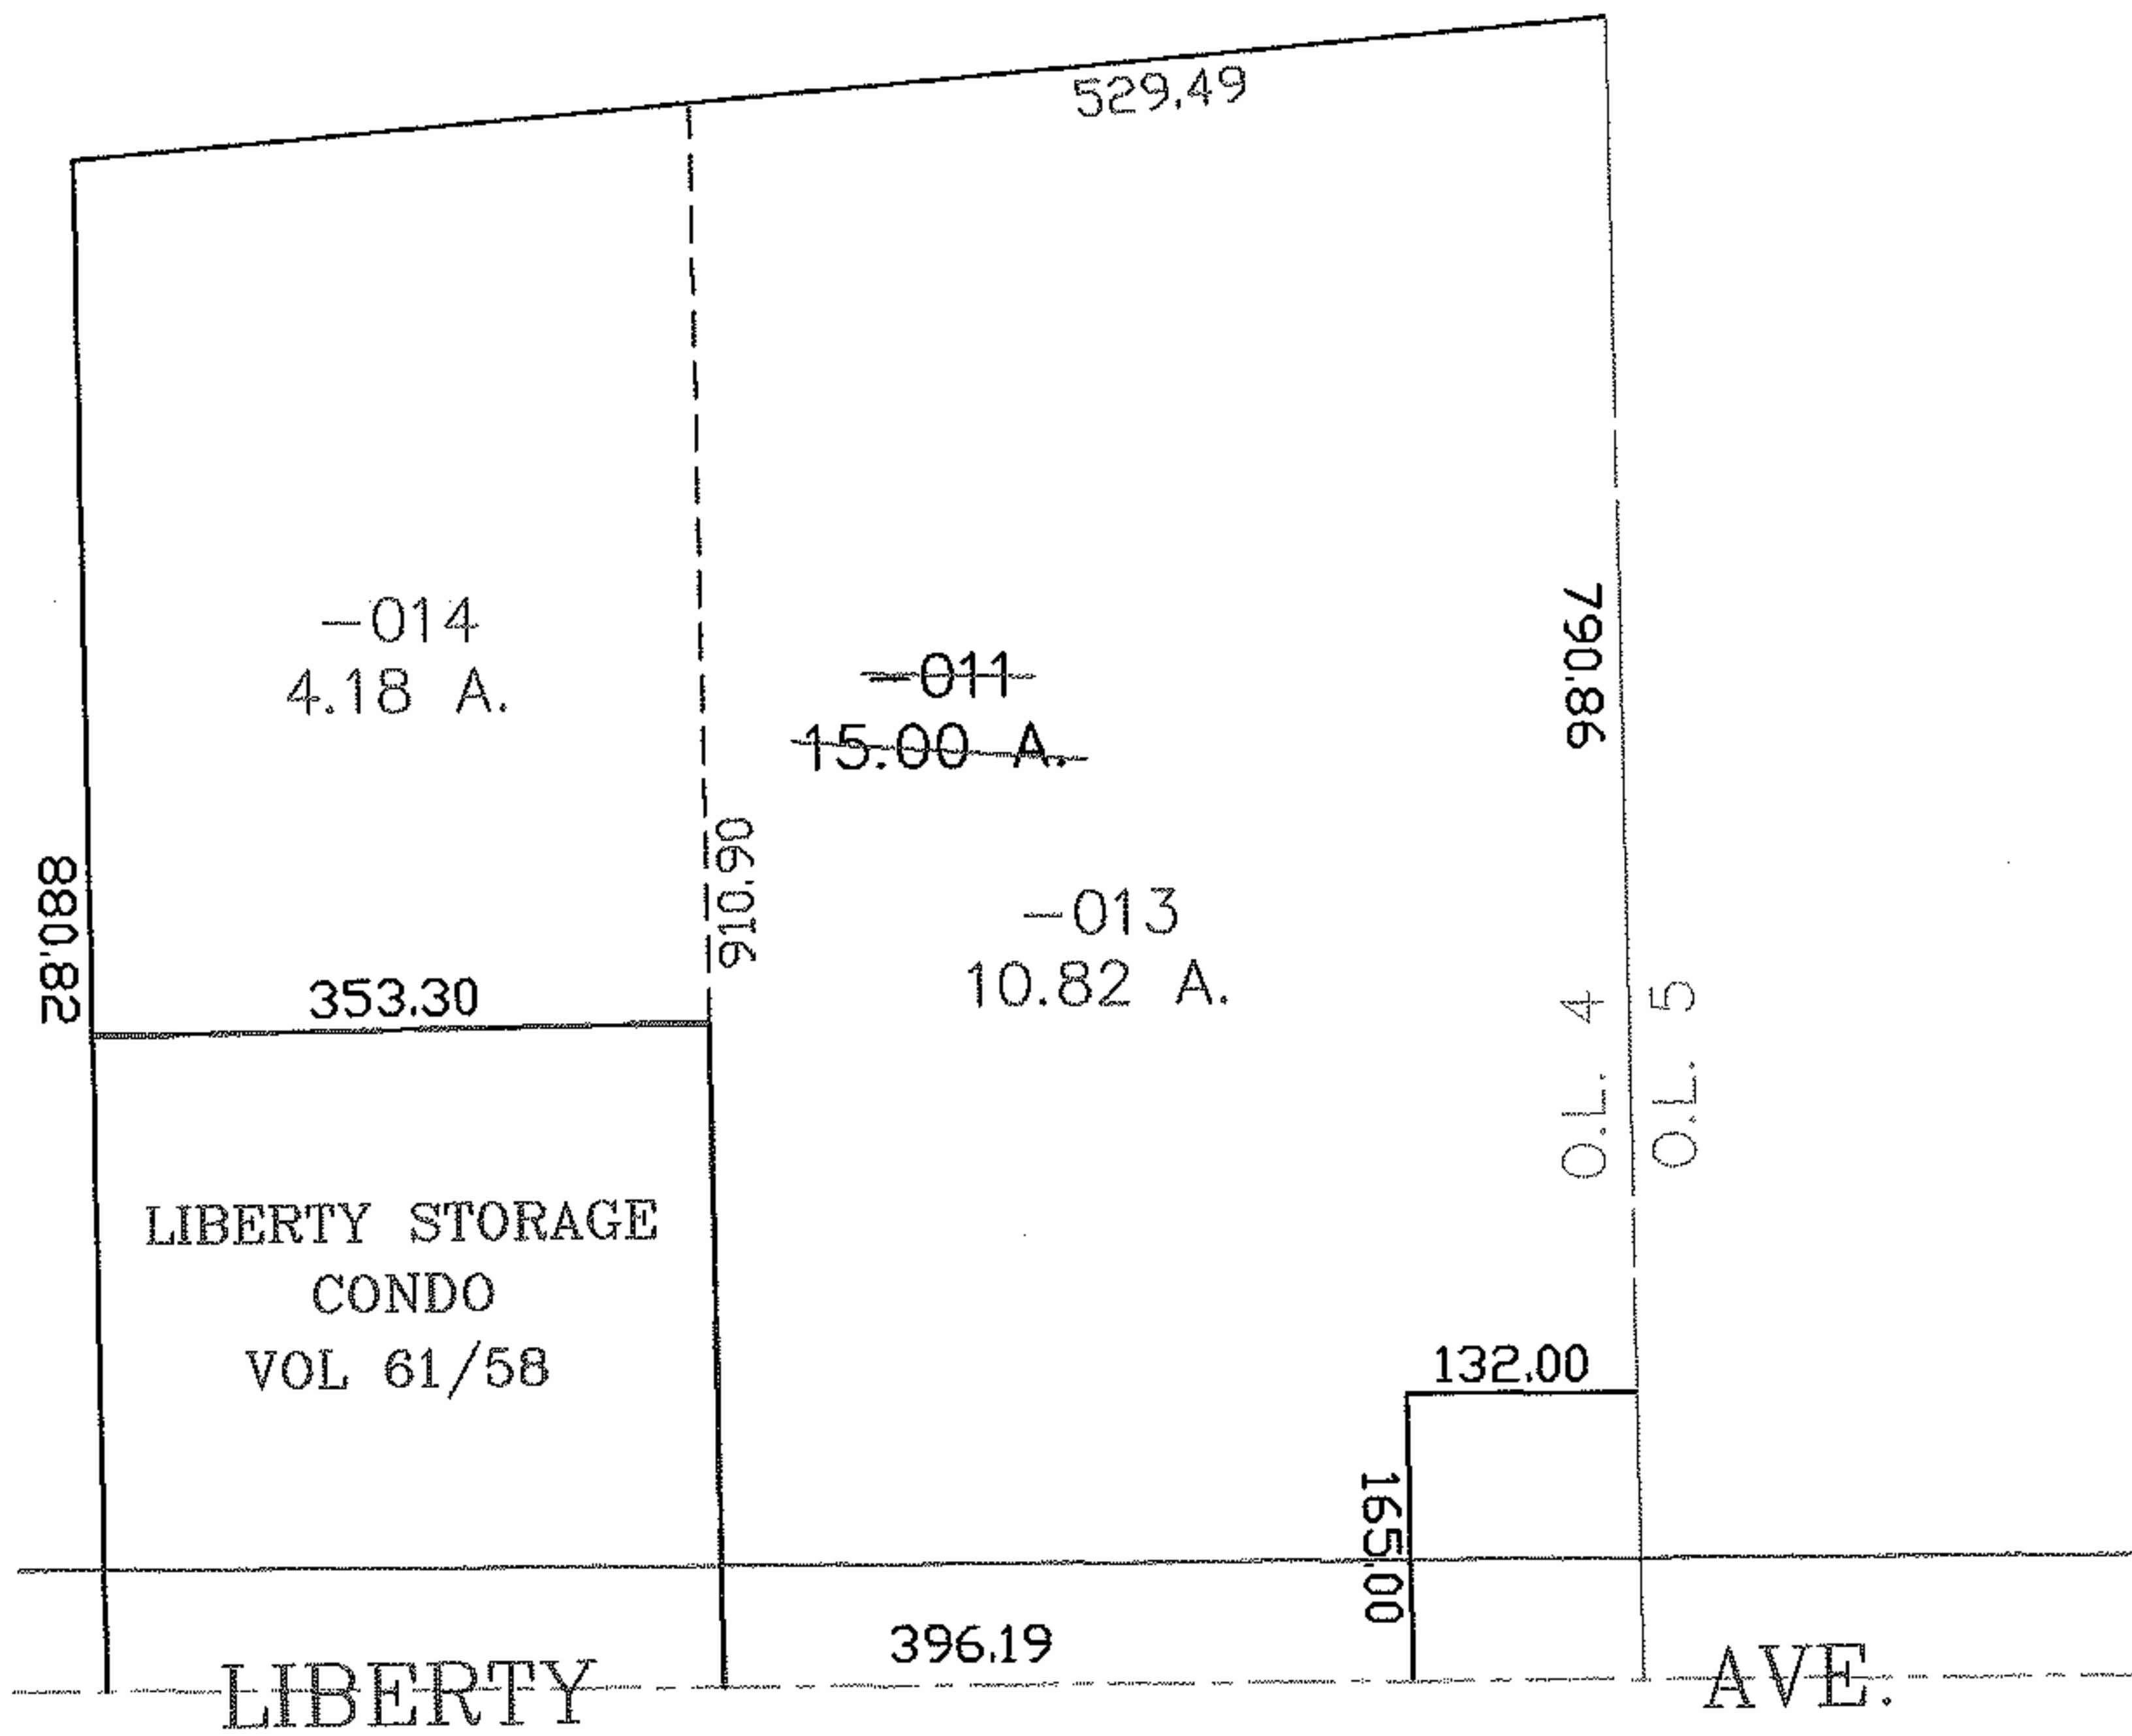


PARENT PARCEL: 01-00-004-115-011

CHILD PARCEL: 01-00-004-115-013, -014

STARTING POINT: CENTERLINE OF LIBERTY AVE & O.L. 4

NO. 01932

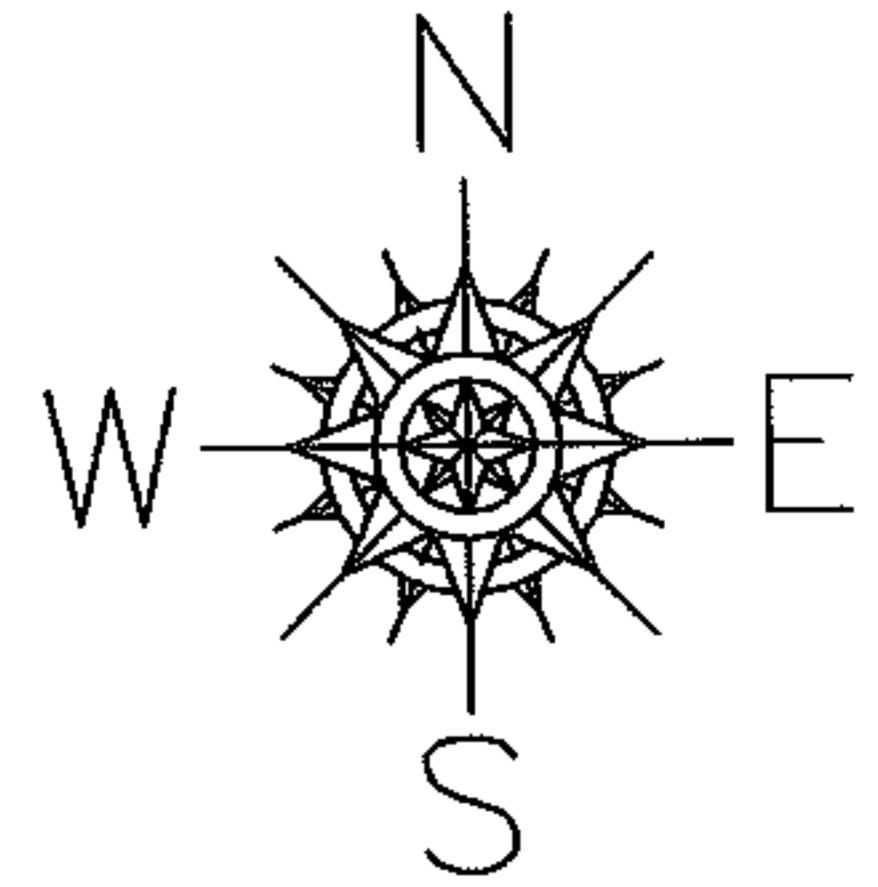

SPLITS/DEEDS PROCESSED
 LORAIN COUNTY TAX MAP DEPARTMENT
 226 MIDDLE AVE. ELYRIA, OHIO

SURVEYED BY: M.G. HURA
 CLOSURE: 0.00 : 10.000
 MAP PAGE(S): 01-00-004-B
 APPROVED BY: JAH DATE: 6-3-05
 SCALE: 1" = 200 PRIOR INSTRUMENT: TOR BK 31/9