




RASTER

PARENT PARCEL: 15-00-080-000-005

CHILD PARCEL: SAME

STARTING POINT: CENTERLINE OF NICKLE PLATE DIAGONAL RD & WHITNEY RD

09-01933-C

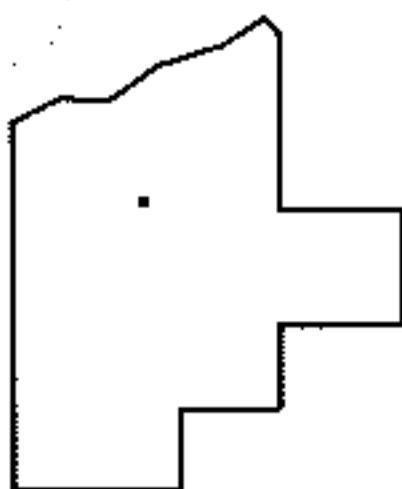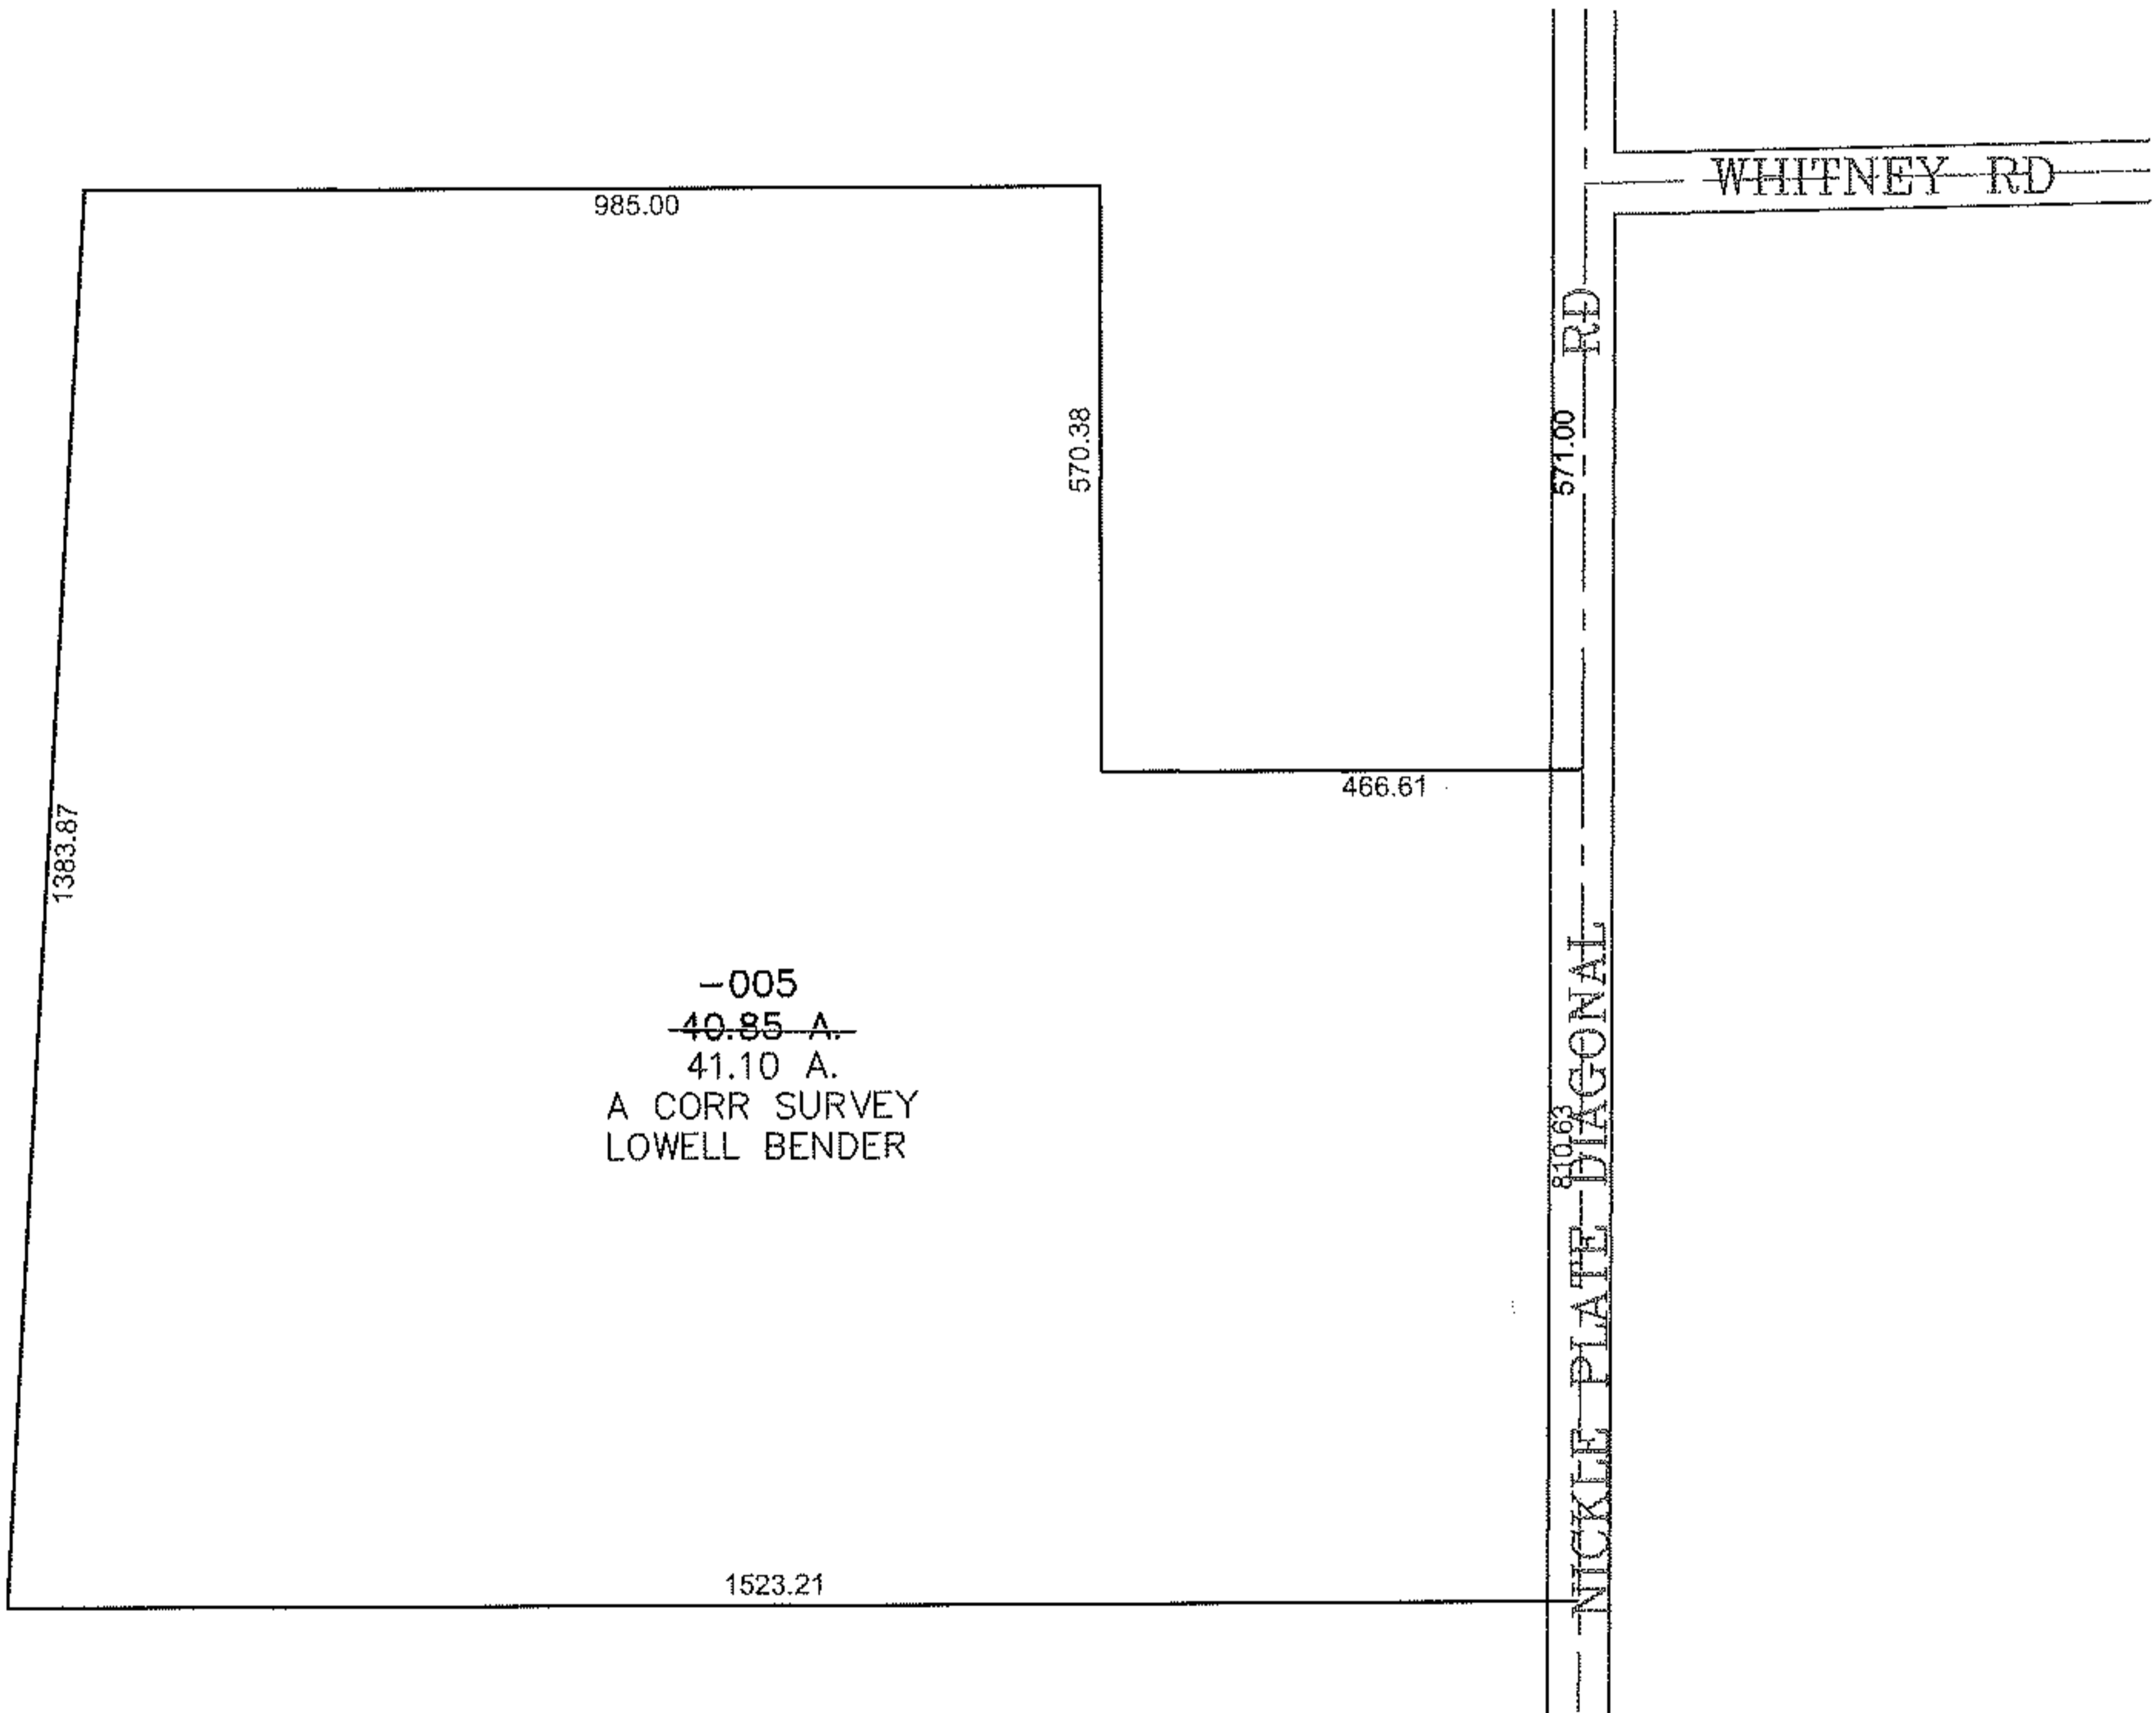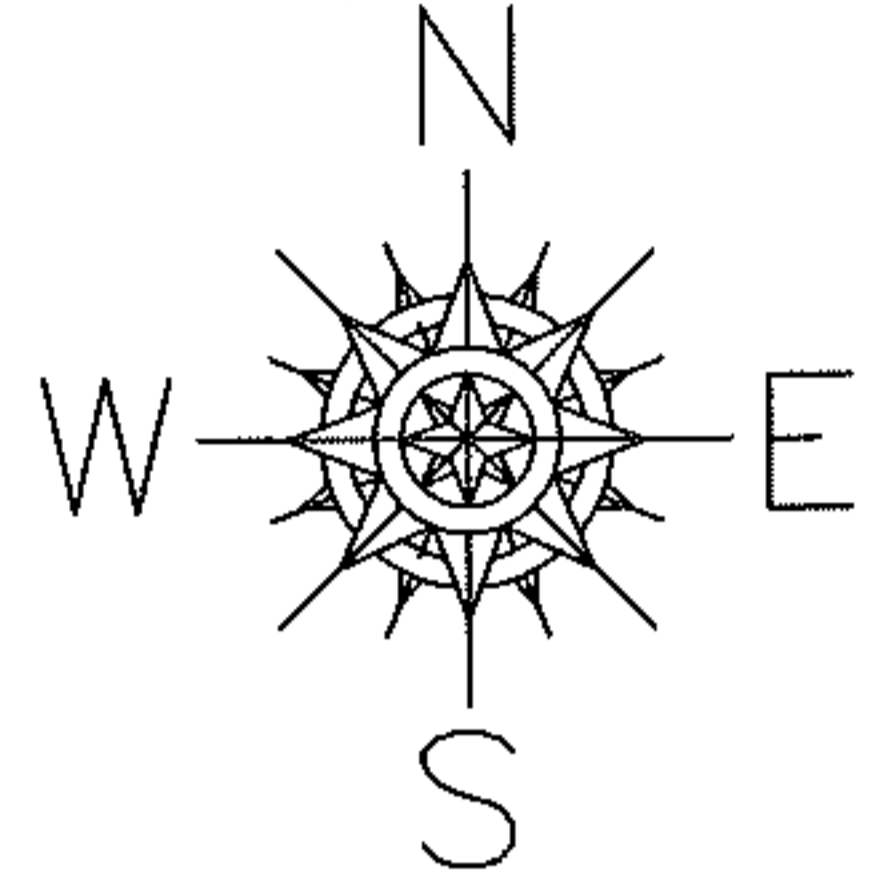

SPLITS/DEEDS PROCESSED
 LORAIN COUNTY TAX MAP DEPARTMENT
 226 MIDDLE AVE. ELYRIA, OHIO

SURVEYED BY: LOWELL BENDER
 CLOSURE: 0.00 : 10.000
 MAP PAGE(S): 15-E
 APPROVED BY: JAH DATE: 12-9-09
 SCALE: 1" = 300 PRIOR INSTRUMENT: 2003892943