


RASTER

PARENT PARCEL: 07-00-030-000-055  
CHILD PARCEL: 07-00-030-000-086 THRU -089  
STARTING POINT: CENTERLINE OF AVON BELDEN RD. & O.L. 30

NO. 01938

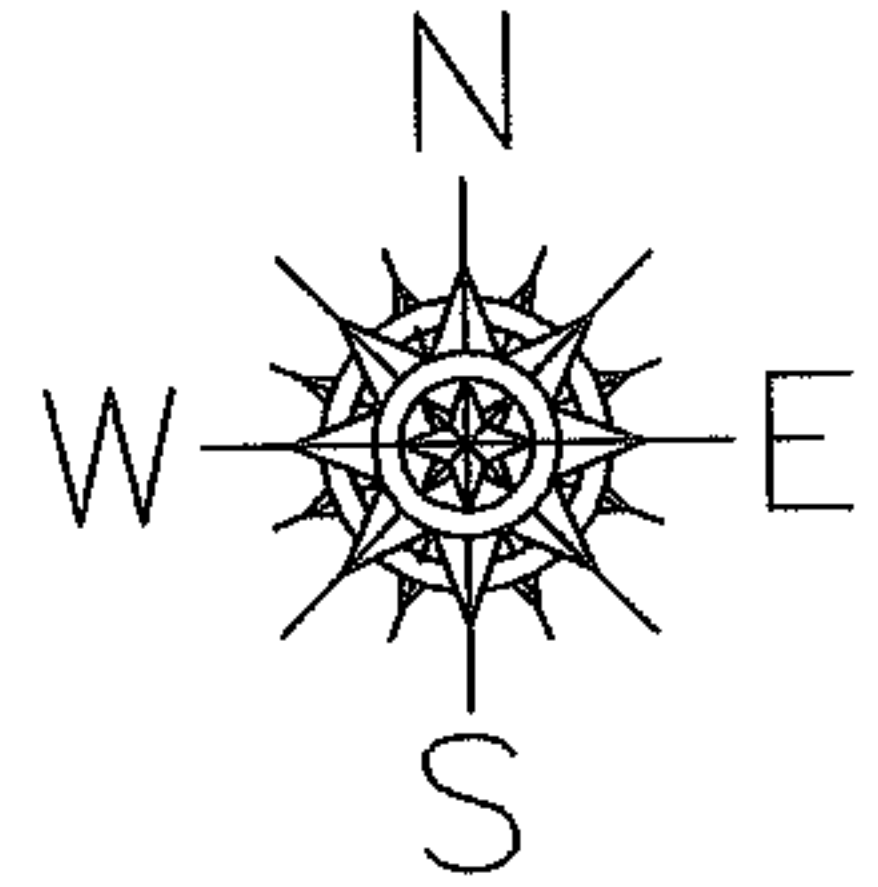

MILLS

RD.

AVON TWP O.L. 13  
N. RIDGEVILLE 980.28  
TWP O.L. 30

758.52

~~-055-~~  
~~20.92 A.~~

~~-087-~~  
~~18.45 A.~~

-089  
16.63 A.  
16.61 A.

A. CORR. PER SURVEY  
PHILLIP A. ROSEBECK

879.74

321.79

-086  
2.47 A.

330.43

237.12

-088  
1.82 A.

101.43

335.00


99.95

99.77

321.00

237.80

AVON BELDEN RD.

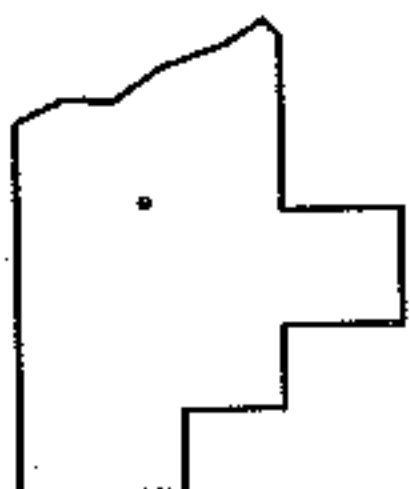

**SPLITS/DEEDS PROCESSED**  
LORAIN COUNTY TAX MAP DEPARTMENT  
226 MIDDLE AVE. ELYRIA, OHIO

SURVEYED BY: PHILLIP A. ROSEBECK  
CLOSURE: 0.00 : 10.000  
MAP PAGE(S): 07-00-030-B  
APPROVED BY: JAH DATE: 6-14-05  
SCALE: 1"= 200 PRIOR INSTRUMENT: 19980583050