


MASTER

PARENT PARCEL: 05-00-061-104-019, -036


CHILD PARCEL: 05-00-061-104-037 THRU -039

STARTING POINT: CENTERLINE OF OBERLIN AVE. & COOPER FOSTER PARK RD.

NO. 01939

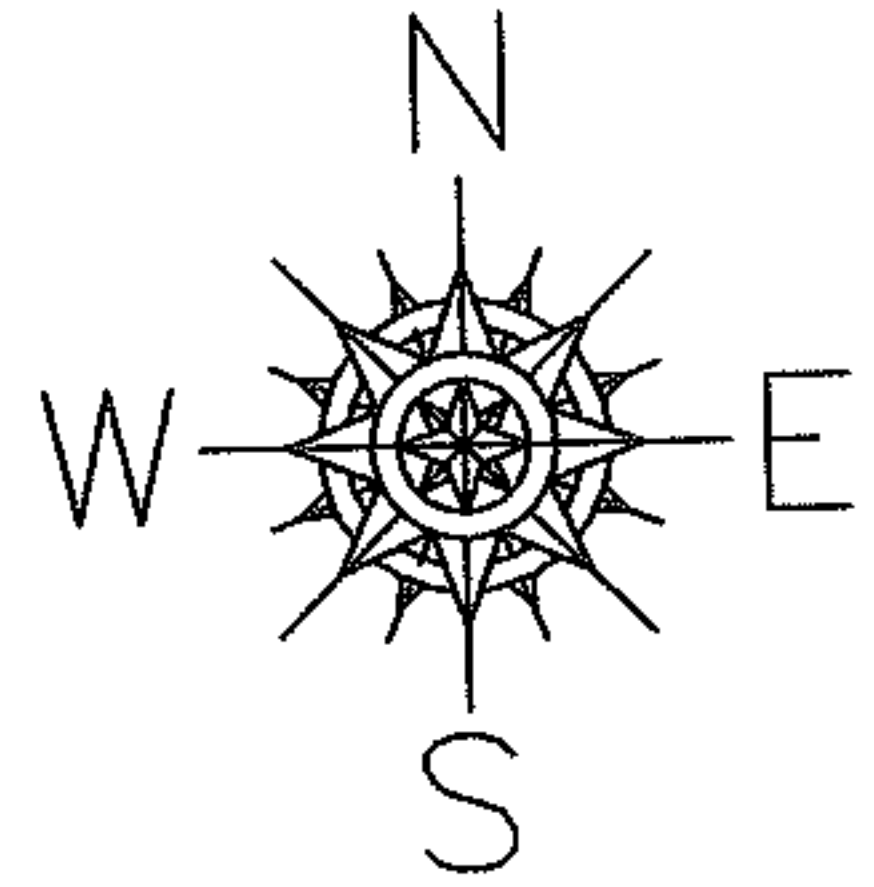

COOPER FOSTER PARK RD.

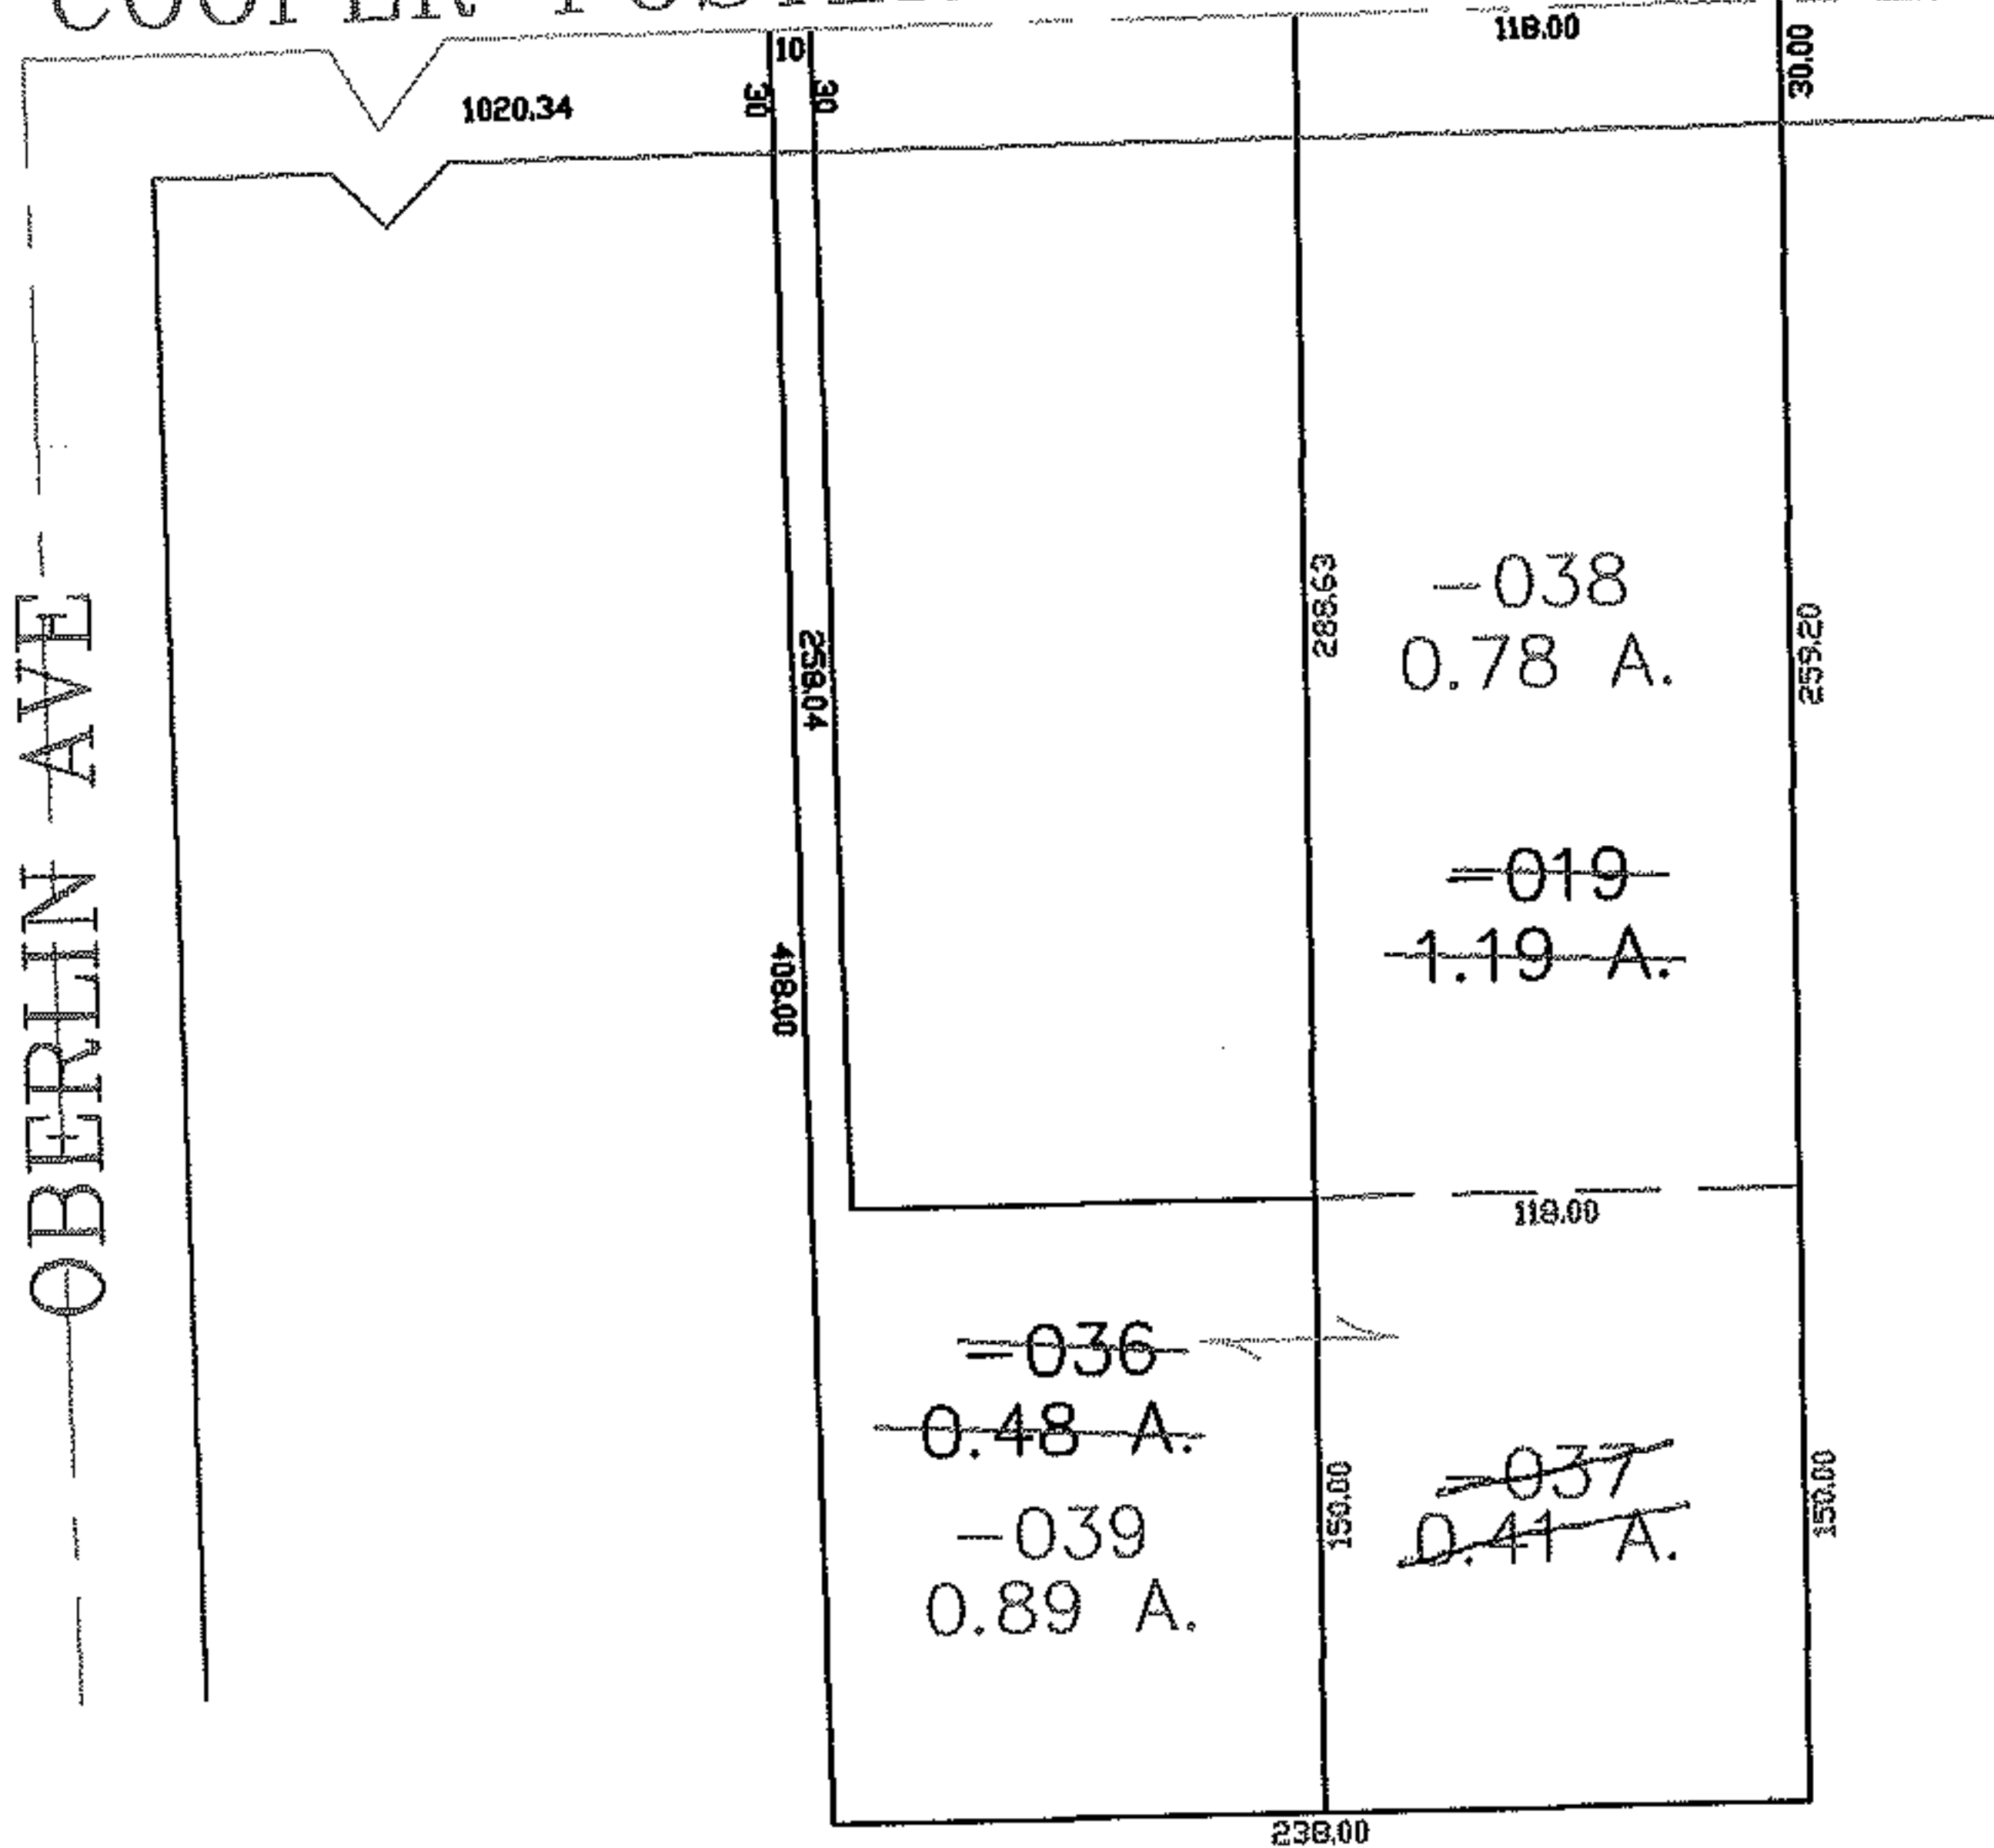

SPLITS/DEEDS PROCESSED

LORAIN COUNTY TAX MAP DEPARTMENT
226 MIDDLE AVE. ELYRIA, OHIO

SURVEYED BY: PATRICK A. MCGANNON

CLOSURE: 0.00 : 10.000

MAP PAGE(S): 6-15-05

APPROVED BY: JAH DATE: 6-15-05

SCALE: 1" = 100 PRIOR INSTRUMENT: 20050059037