
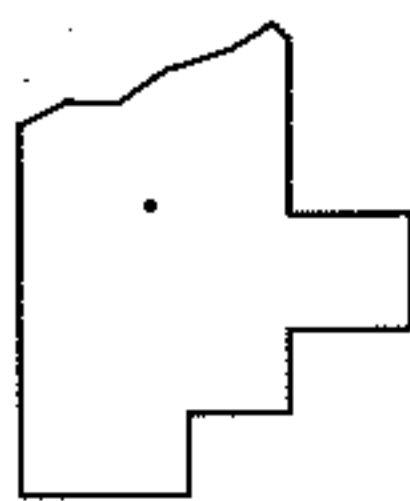


PARENT PARCEL: 15-00-027-000-049

CHILD PARCEL: SAME

STARTING POINT: CENTERLINE OF BIGGS RD & WHEELER RD

10-01941-D

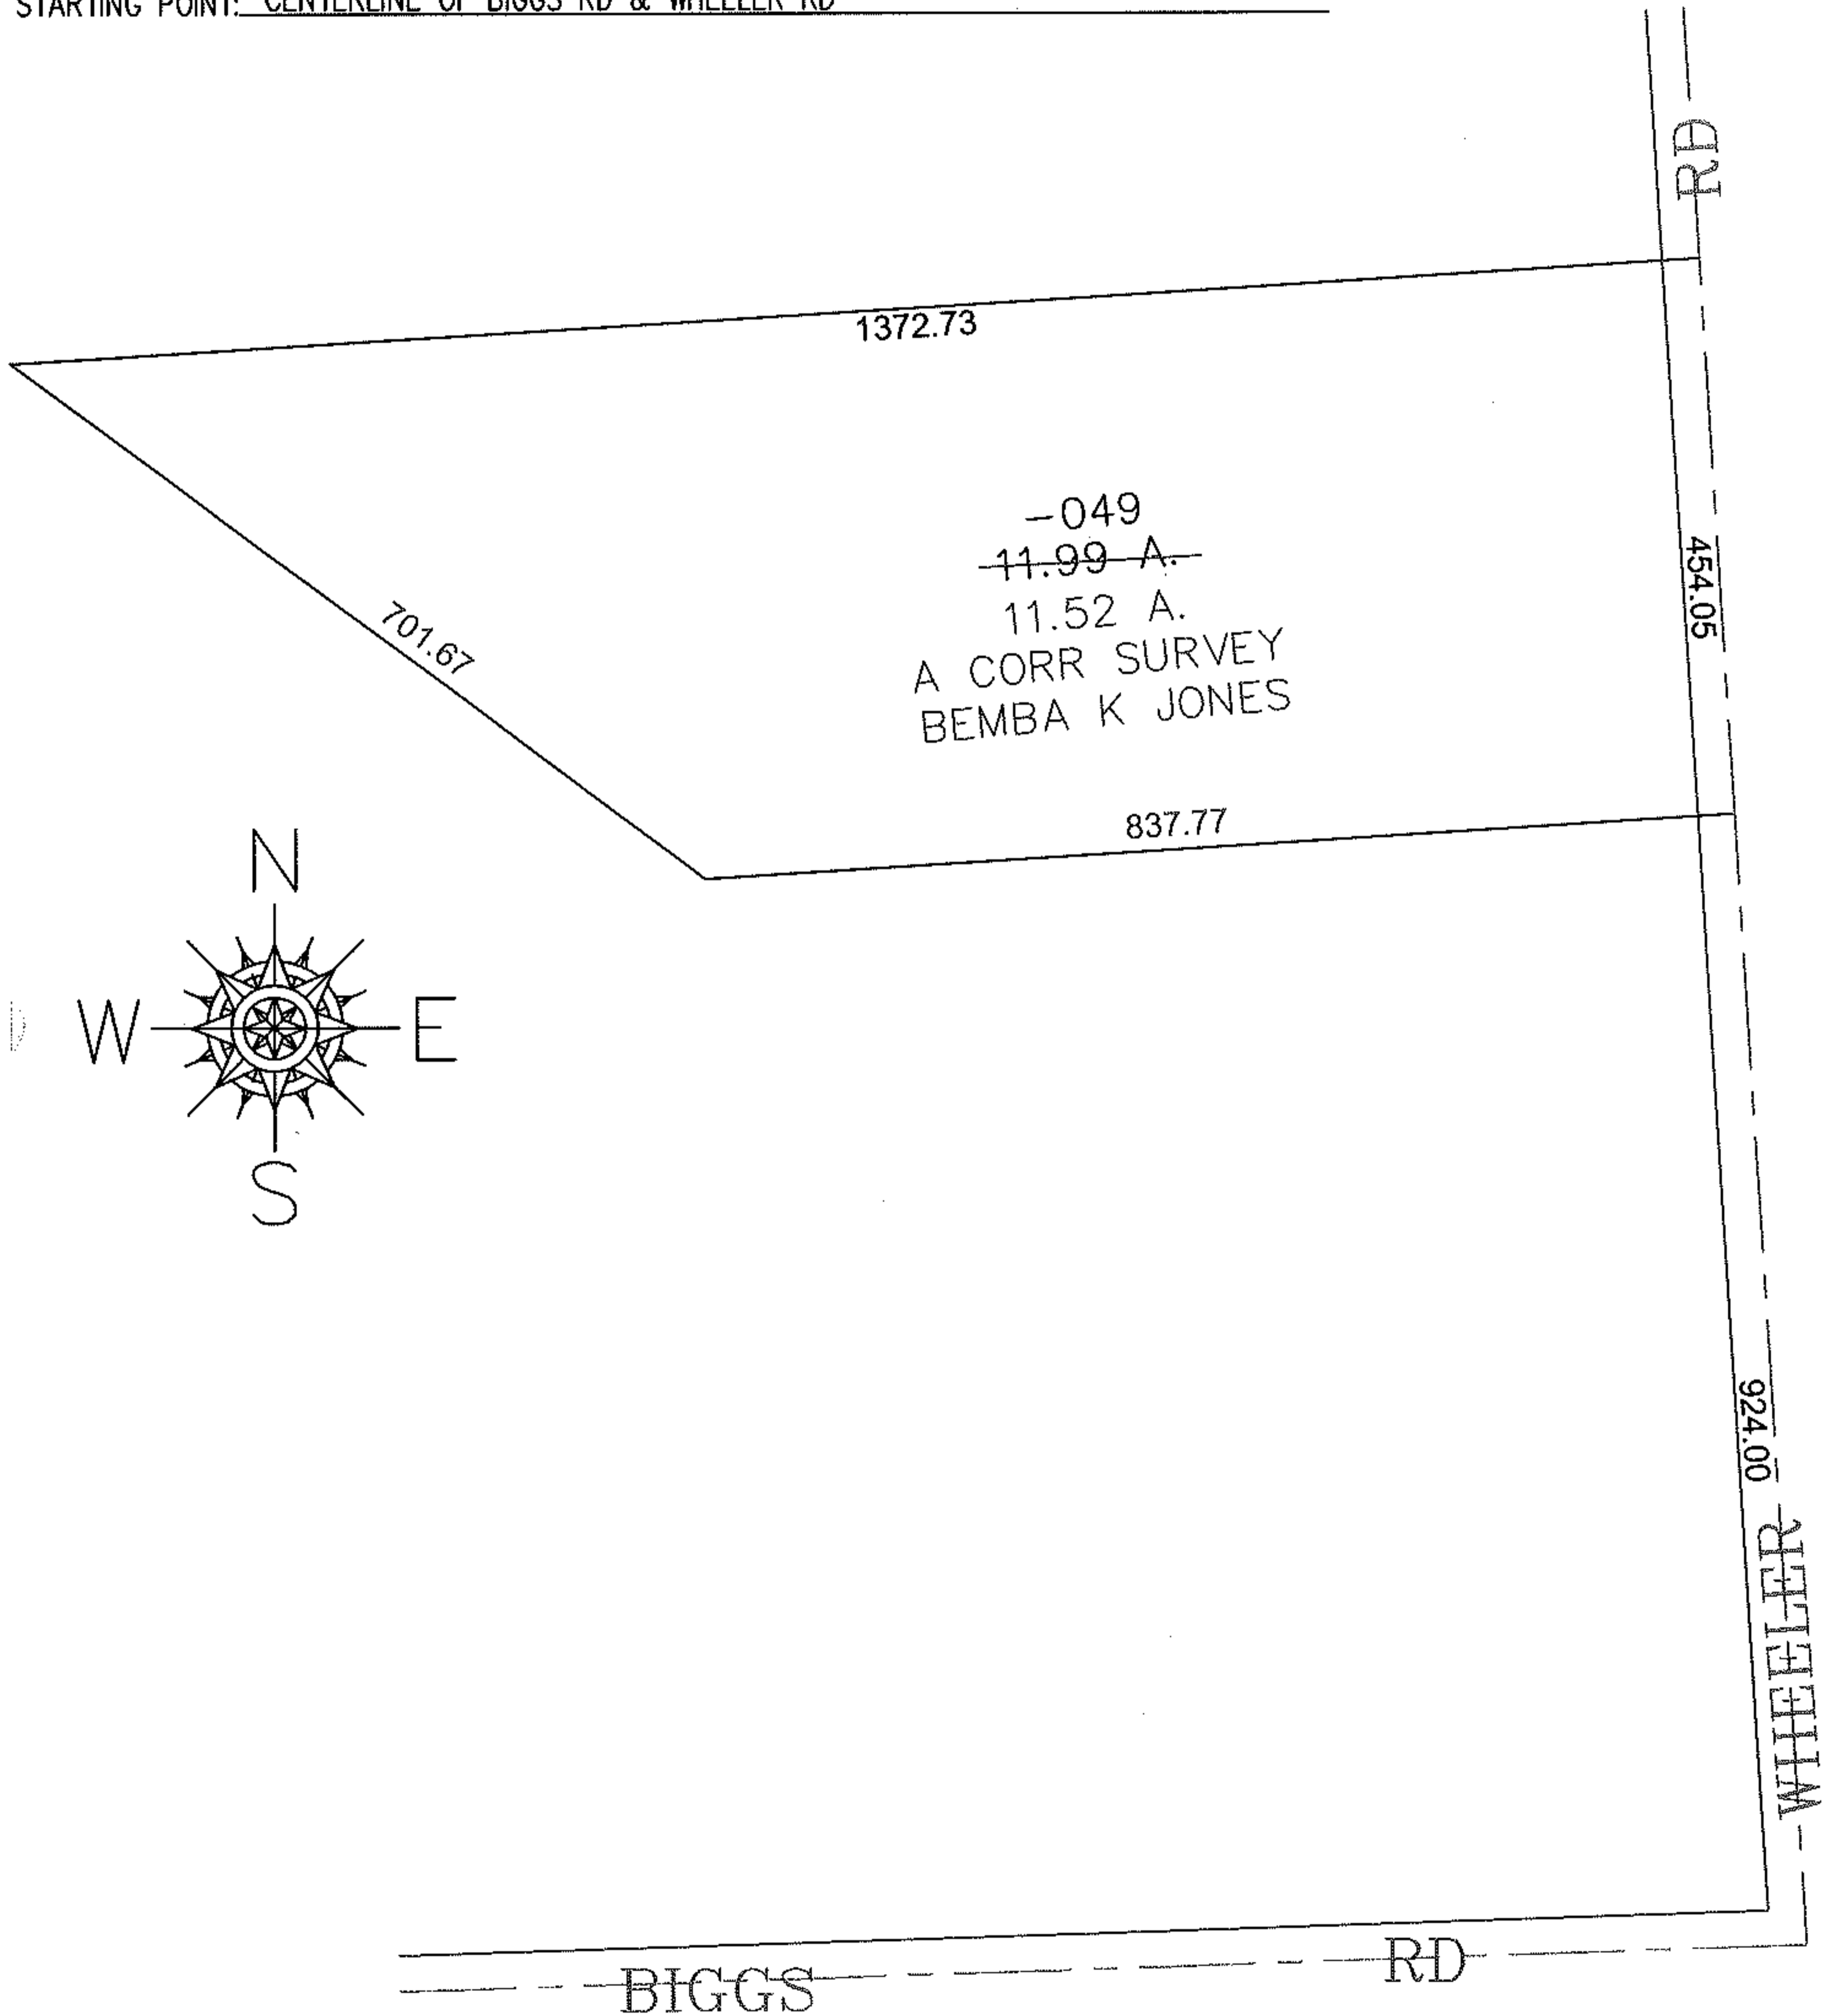

**SPLITS/DEEDS PROCESSED**  
 LORAIN COUNTY TAX MAP DEPARTMENT  
 226 MIDDLE AVE. ELYRIA, OHIO

SURVEYED BY: BEMBA K JONES  
 CLOSURE: 0.00 : 10,000  
 MAP PAGE(S): 15-C  
 APPROVED BY: JAH DATE: 1-4-10  
 SCALE: 1" = 200' PRIOR INSTRUMENT: 20030915146