




RASTER

PARENT PARCEL: 05-00-063-101-173

CHILD PARCEL: 05-00-063-101-195, -196

STARTING POINT: CENTERLINE OF MIDDLE RIDGE RD. & ROSEDALE DR.

NO. 01941

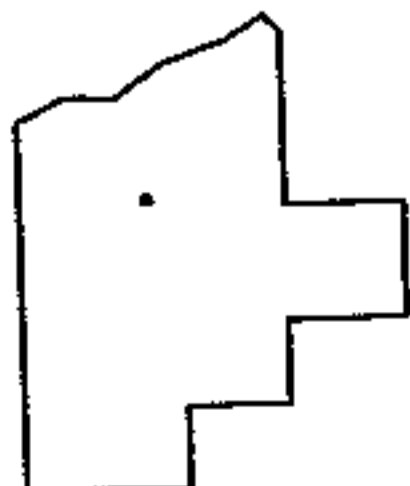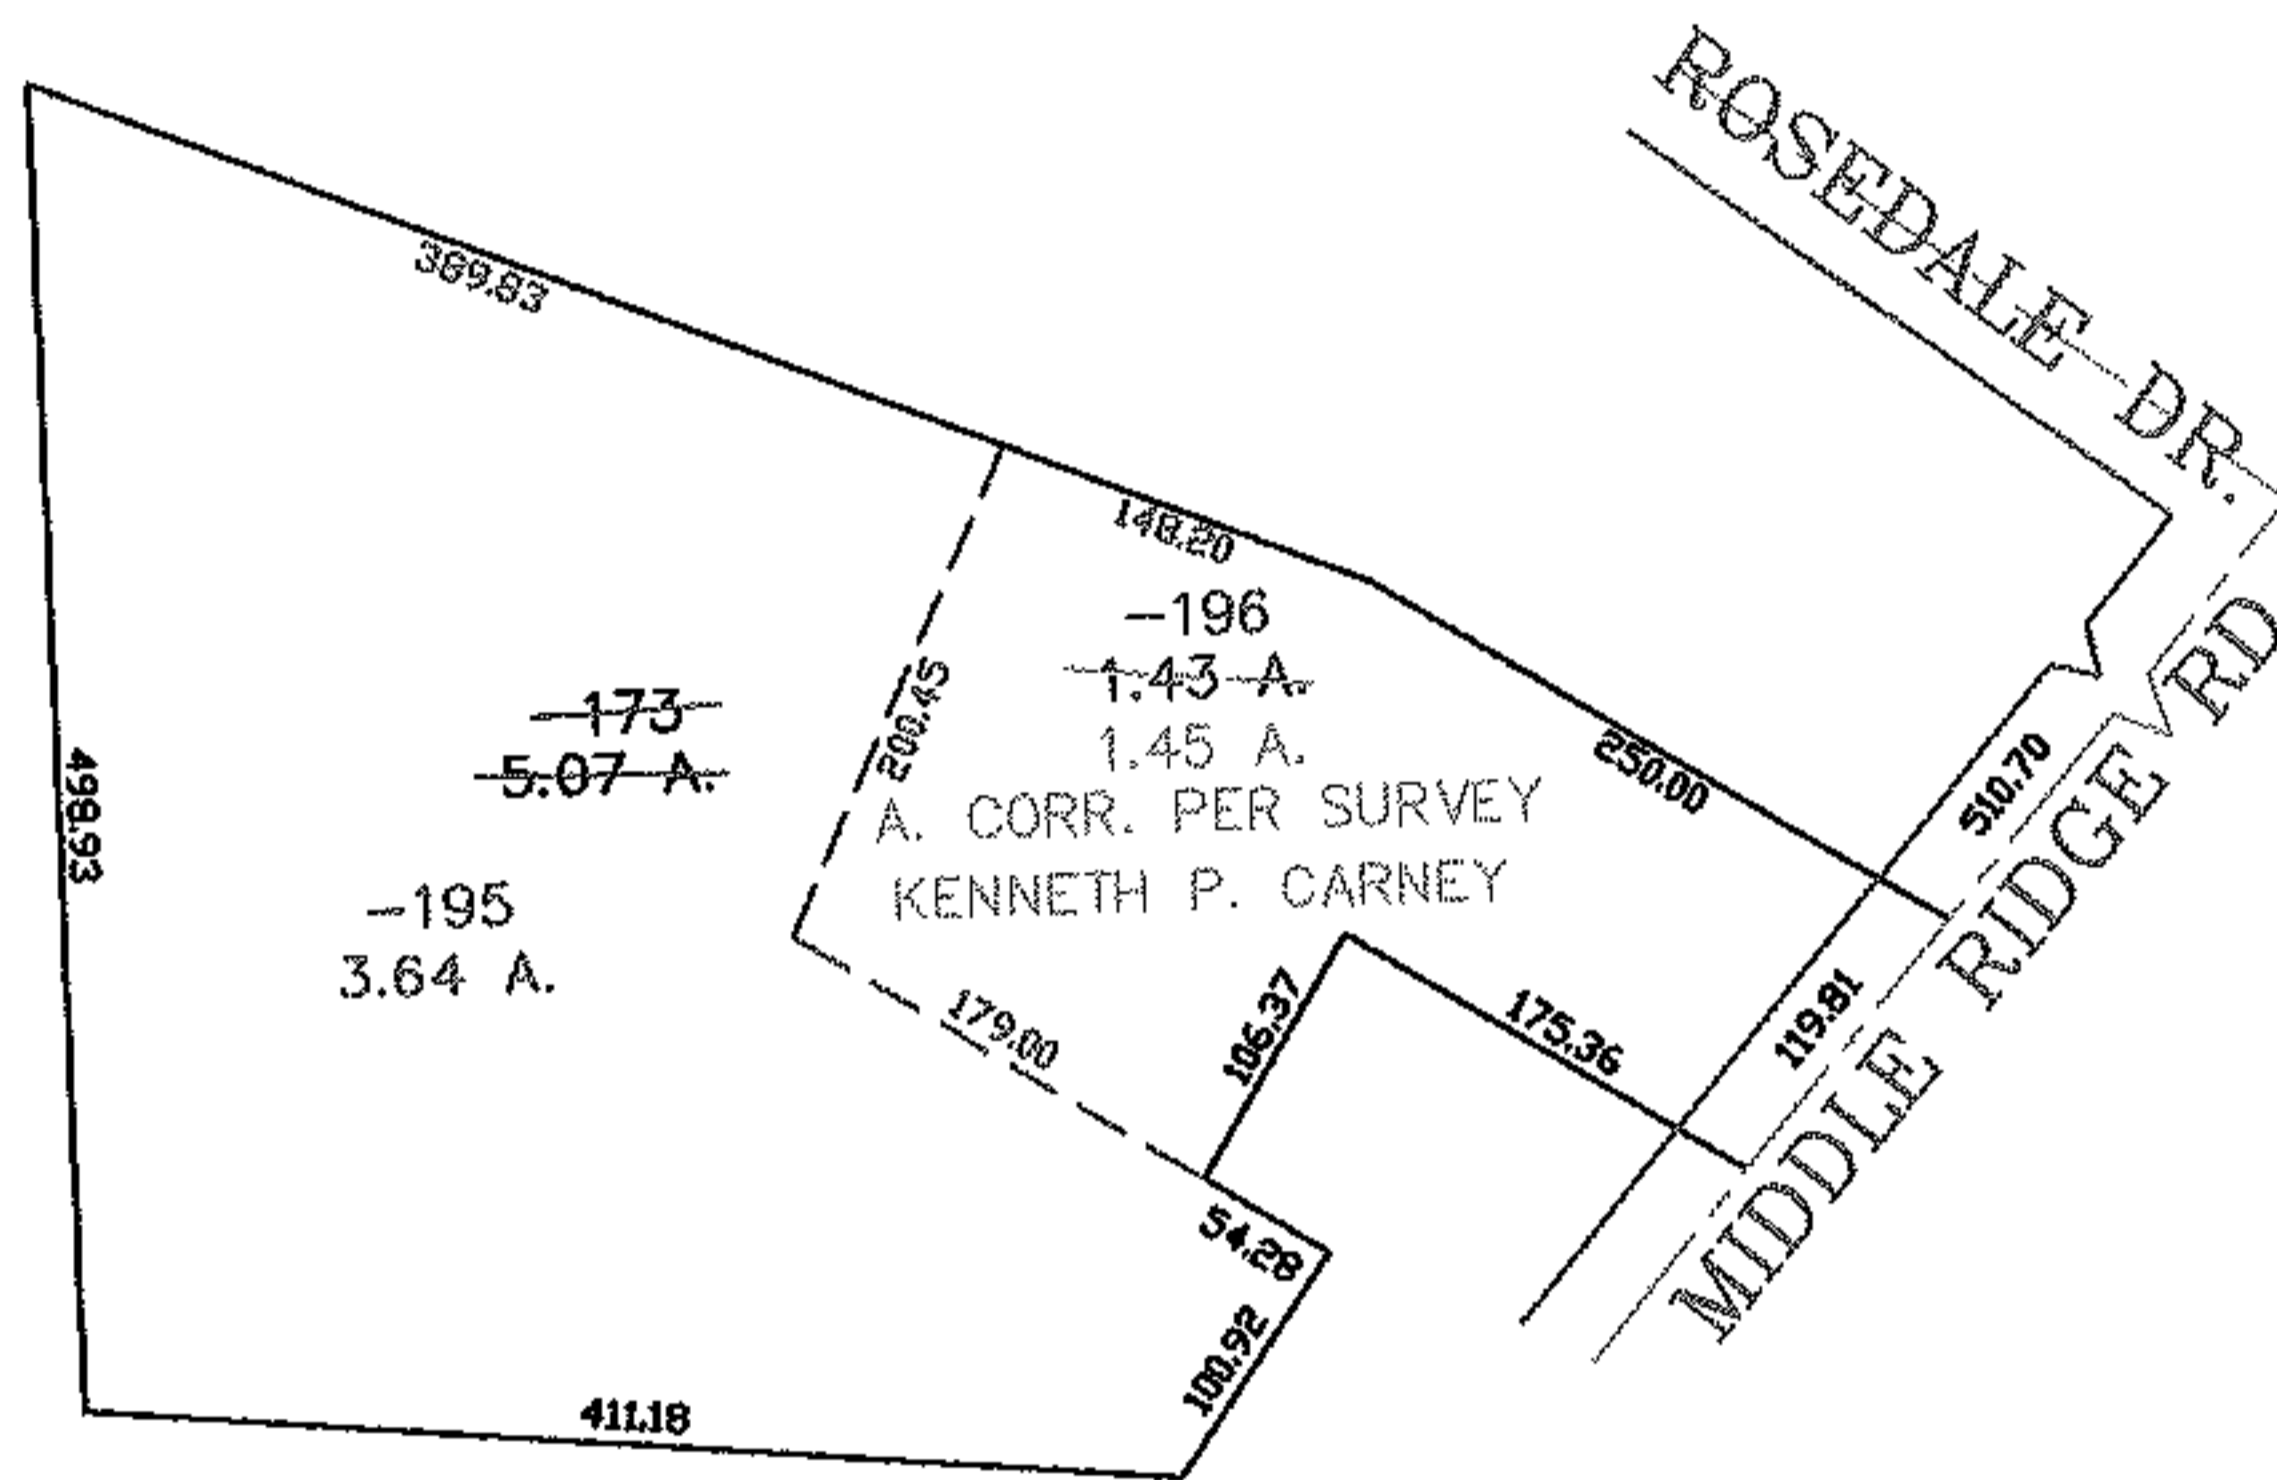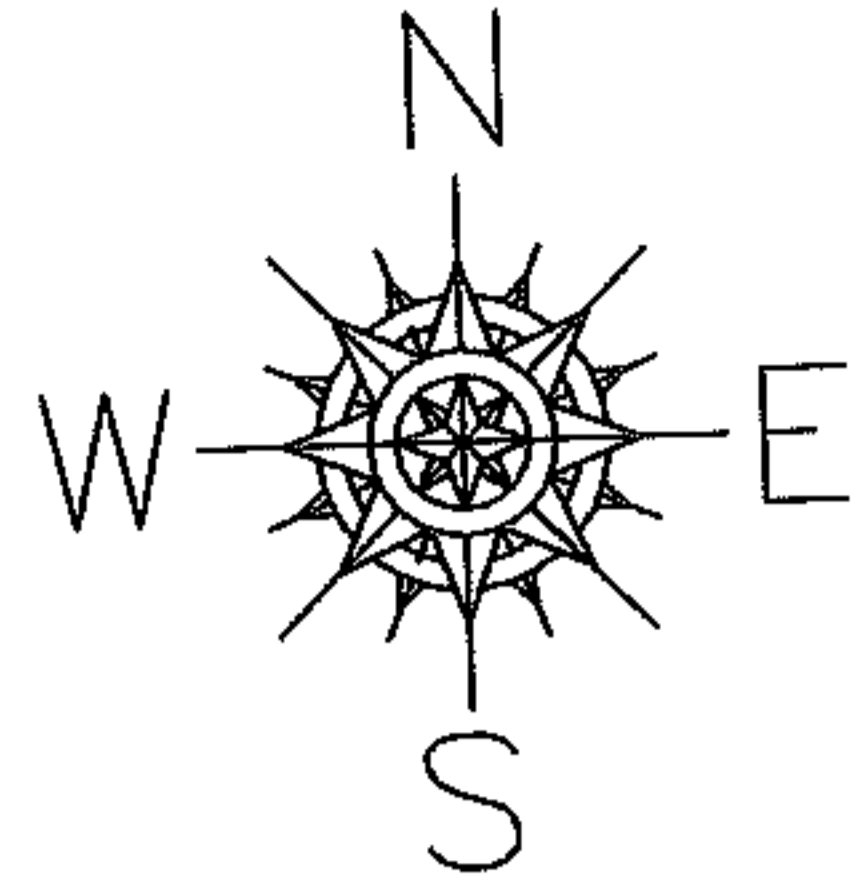

**SPLITS/DEEDS PROCESSED**  
LORAIN COUNTY TAX MAP DEPARTMENT  
226 MIDDLE AVE. ELYRIA, OHIO

SURVEYED BY: KENNETH P. CARNEY  
CLOSURE: 0.00 : 10.000  
MAP PAGE(S): 05-00-063-A  
APPROVED BY: JAH DATE: 6-22-05  
SCALE: 1" = 200 PRIOR INSTRUMENT: DV 1269/849