


PARENT PARCEL: 02-01-003-117-003
 CHILD PARCEL: ADD TO DUP. 02-00-052-000-009
 STARTING POINT: I.P. FD. AT THE N.E. CORNER OF O.L.52

NO. 10-01945-C

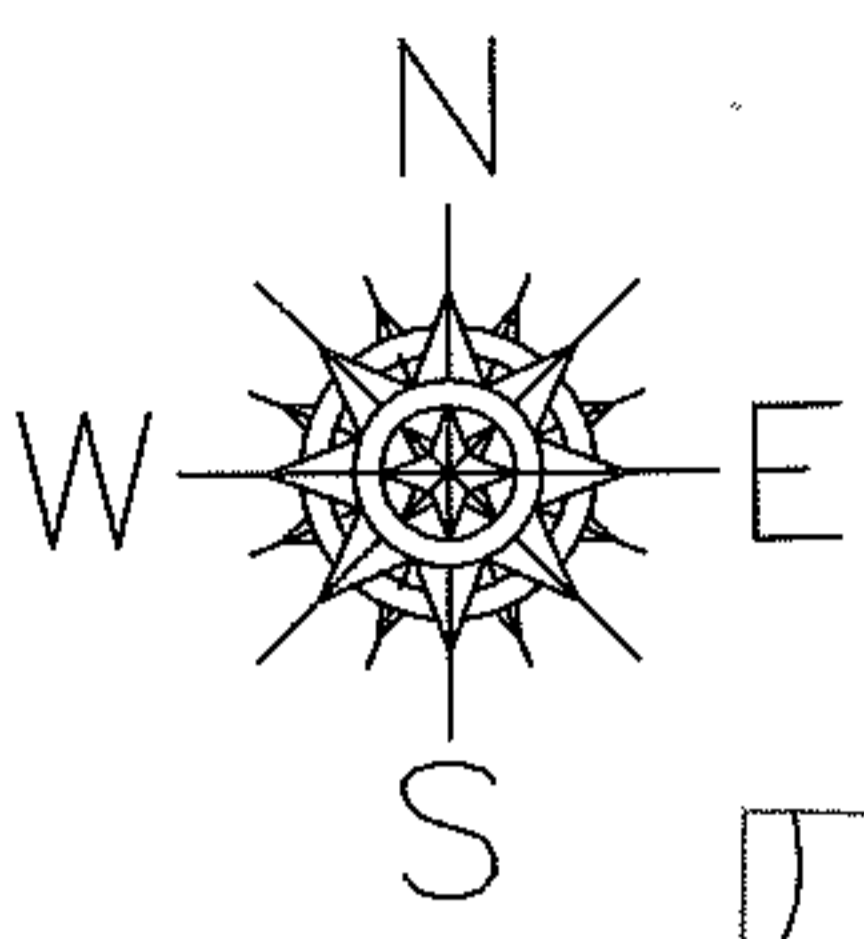



ACREAGE CORRECTION

02-01-003-117-003
~~1.84 A.~~
 2.28 A.
 CALC.

ADD TO DUPLICATE

02-00-052-000-009
 2.36 A.
 CALC.

P.B. I.P.
 N.E. CORNER
 O.L. 52

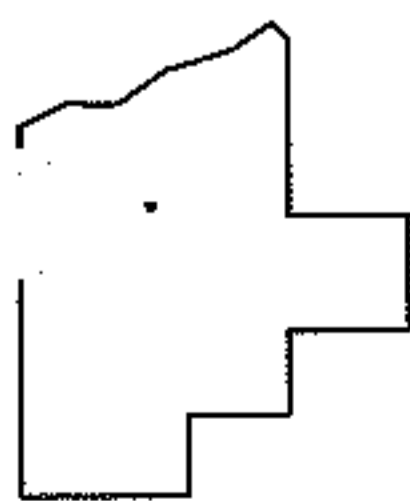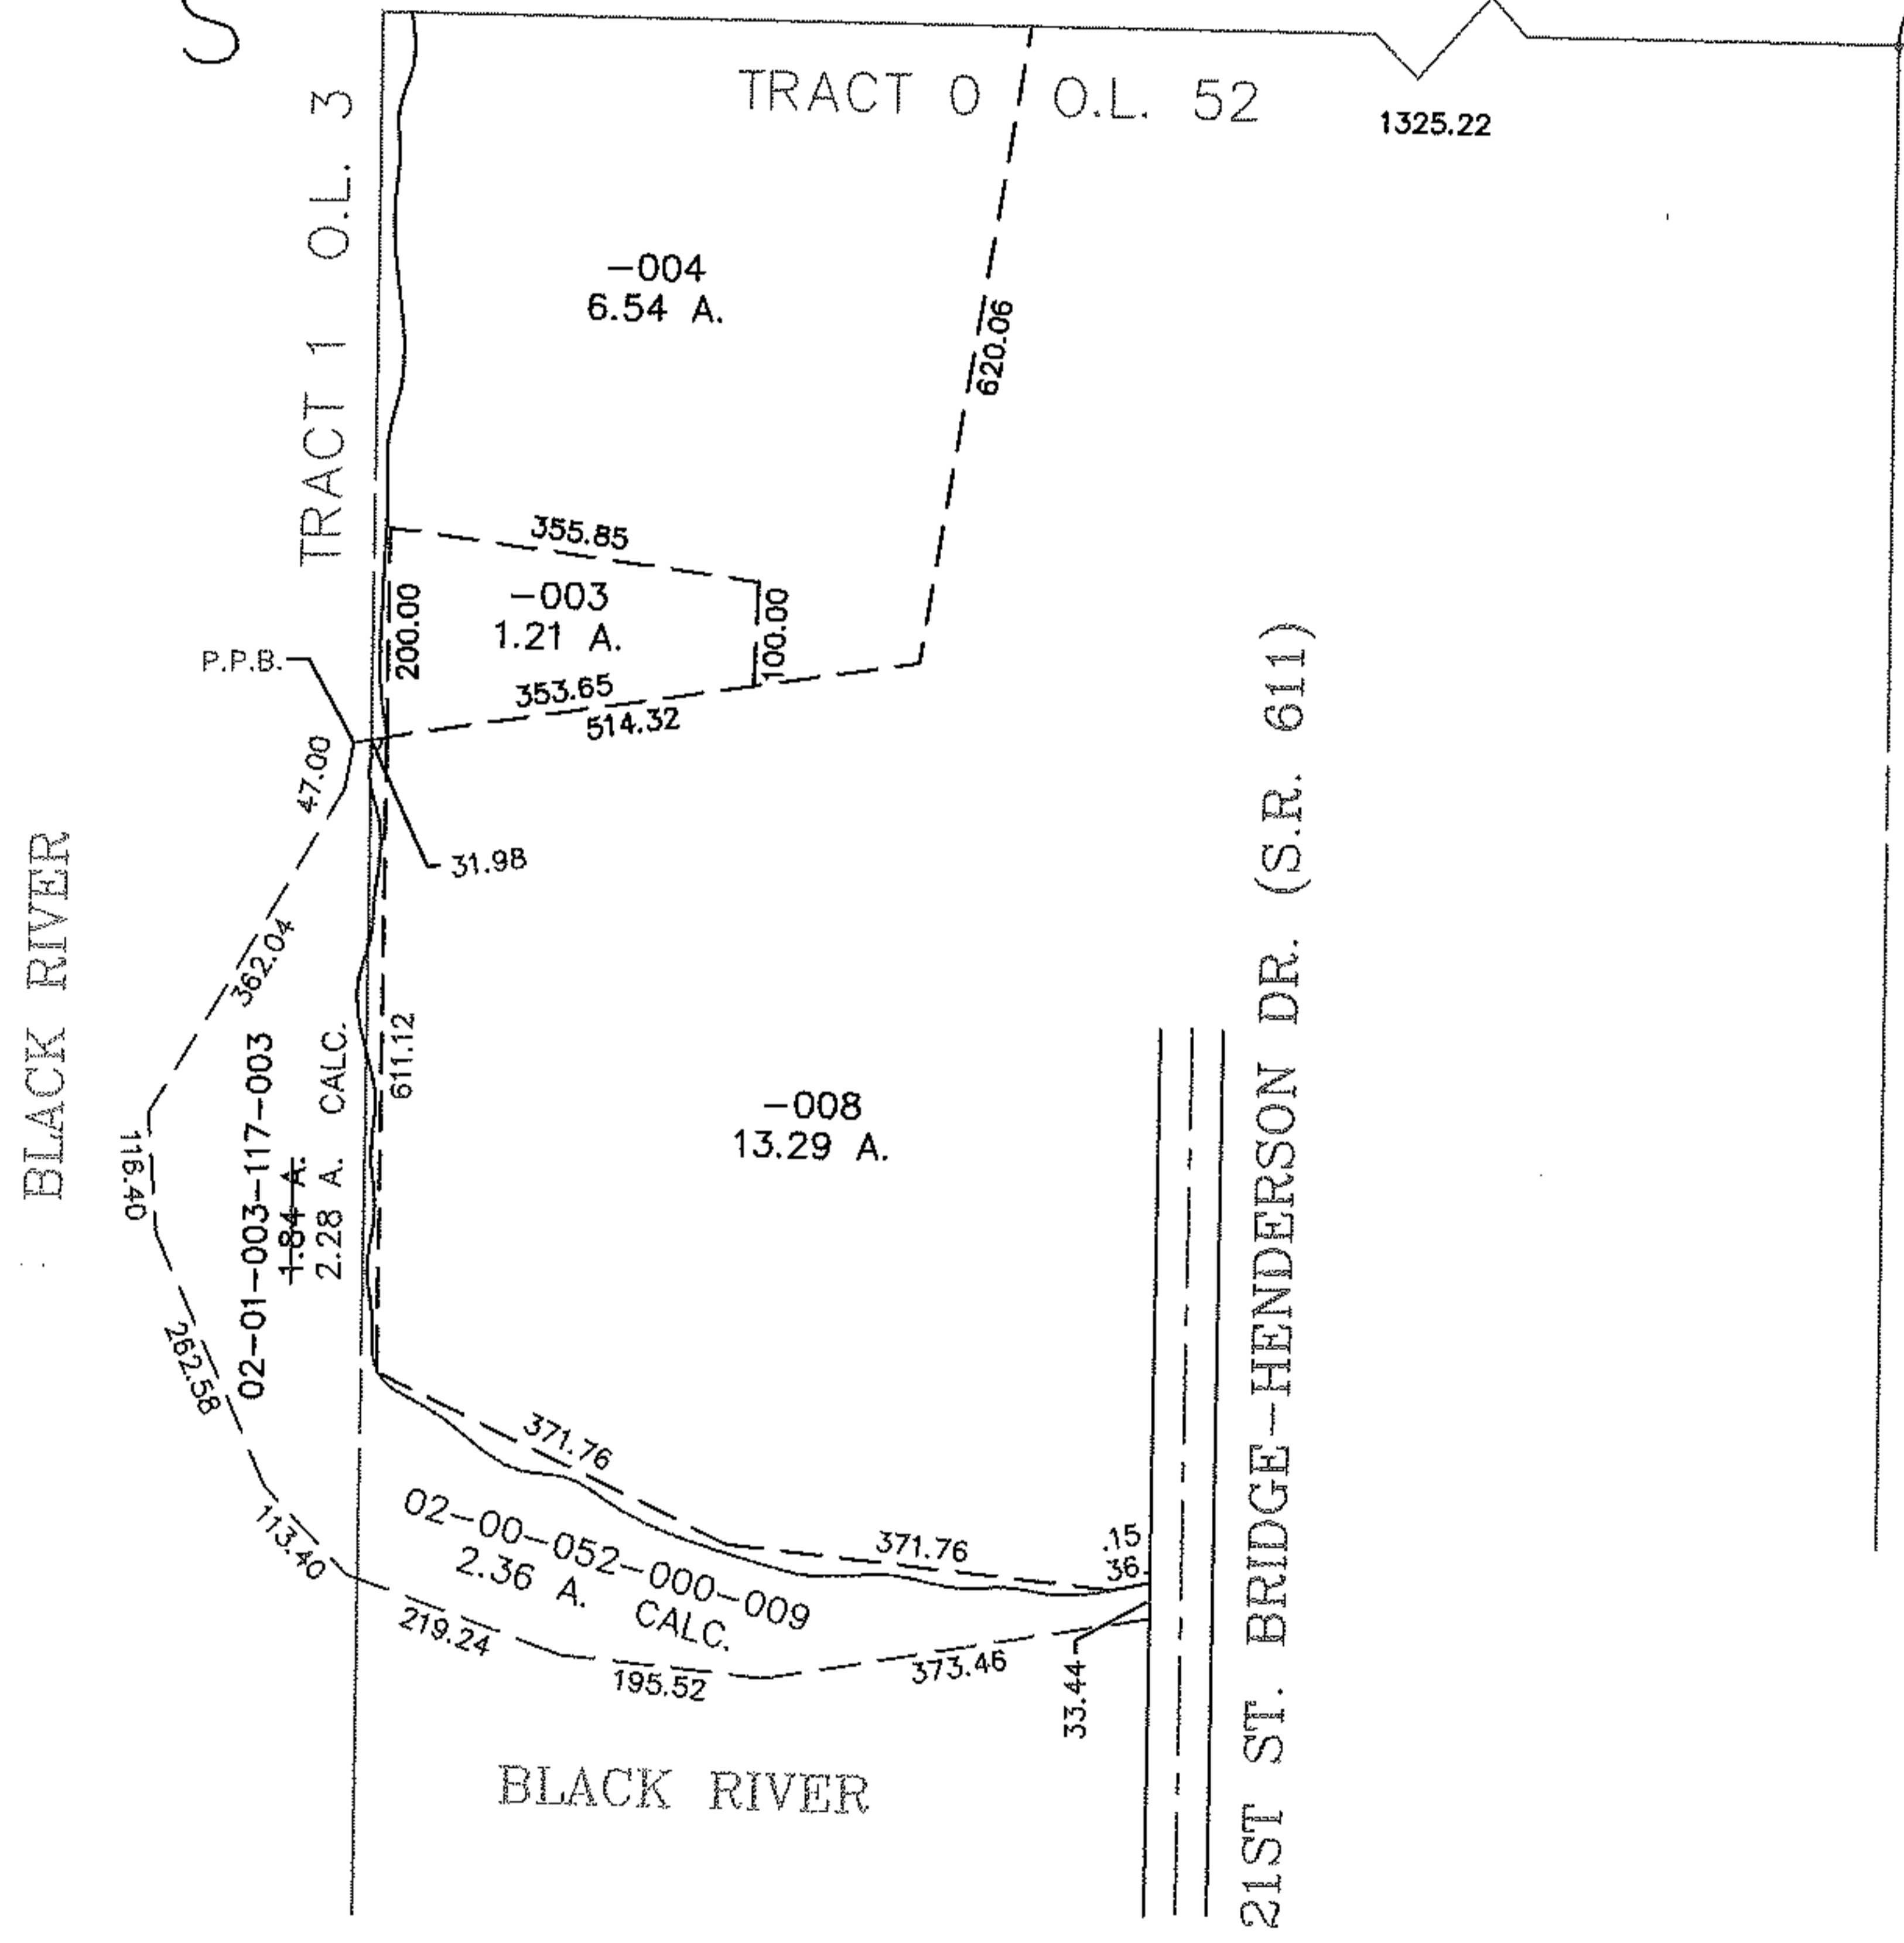

SPLITS/DEEDS PROCESSED
 LORAIN COUNTY TAX MAP DEPARTMENT
 226 MIDDLE AVE. ELYRIA, OHIO

SURVEYED BY: PER DEED
 CLOSURE: OK
 MAP PAGE(S): 2-00-052 & 2-01-003-D
 APPROVED BY: TJS DATE: 1/19/10
 SCALE: 1" = 300 PRIOR INSTRUMENT: DV 841/233