


PARENT PARCEL: 05-00-001-000-237


CHILD PARCEL: _____

STARTING POINT: _____

10-01946-C

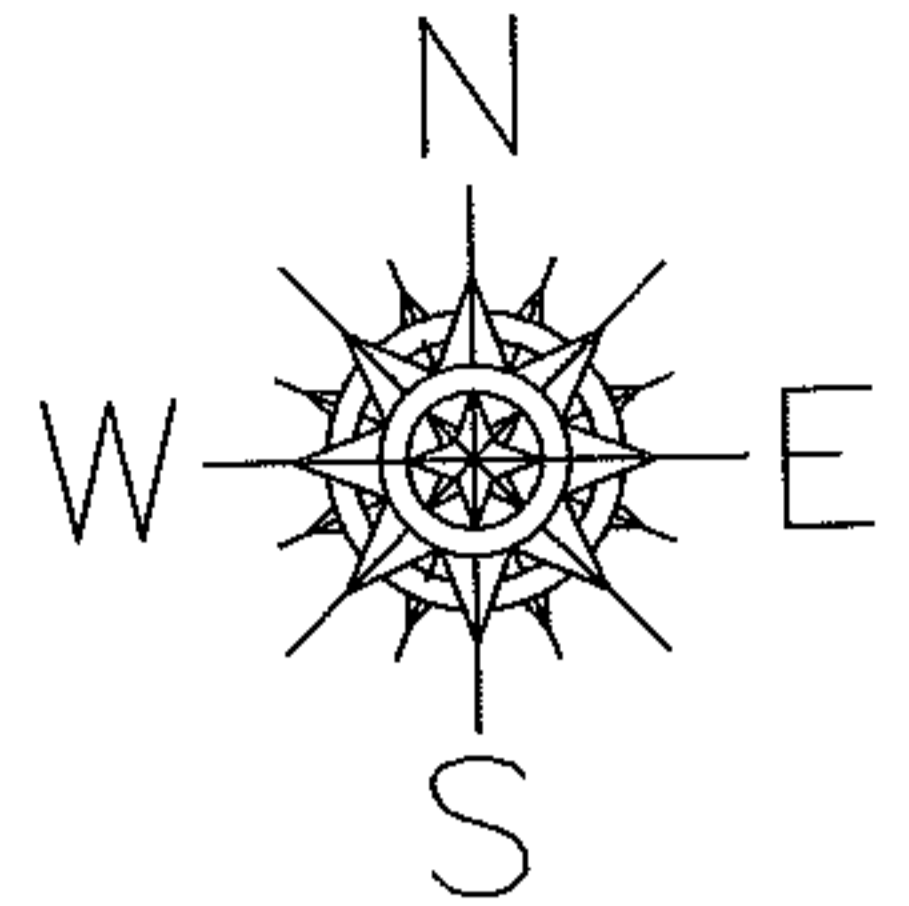

CERTIFICATE OF CORRECTION
DEERFIELD ESTATES SUB. NO.4
VOL.95 PGS.23-25

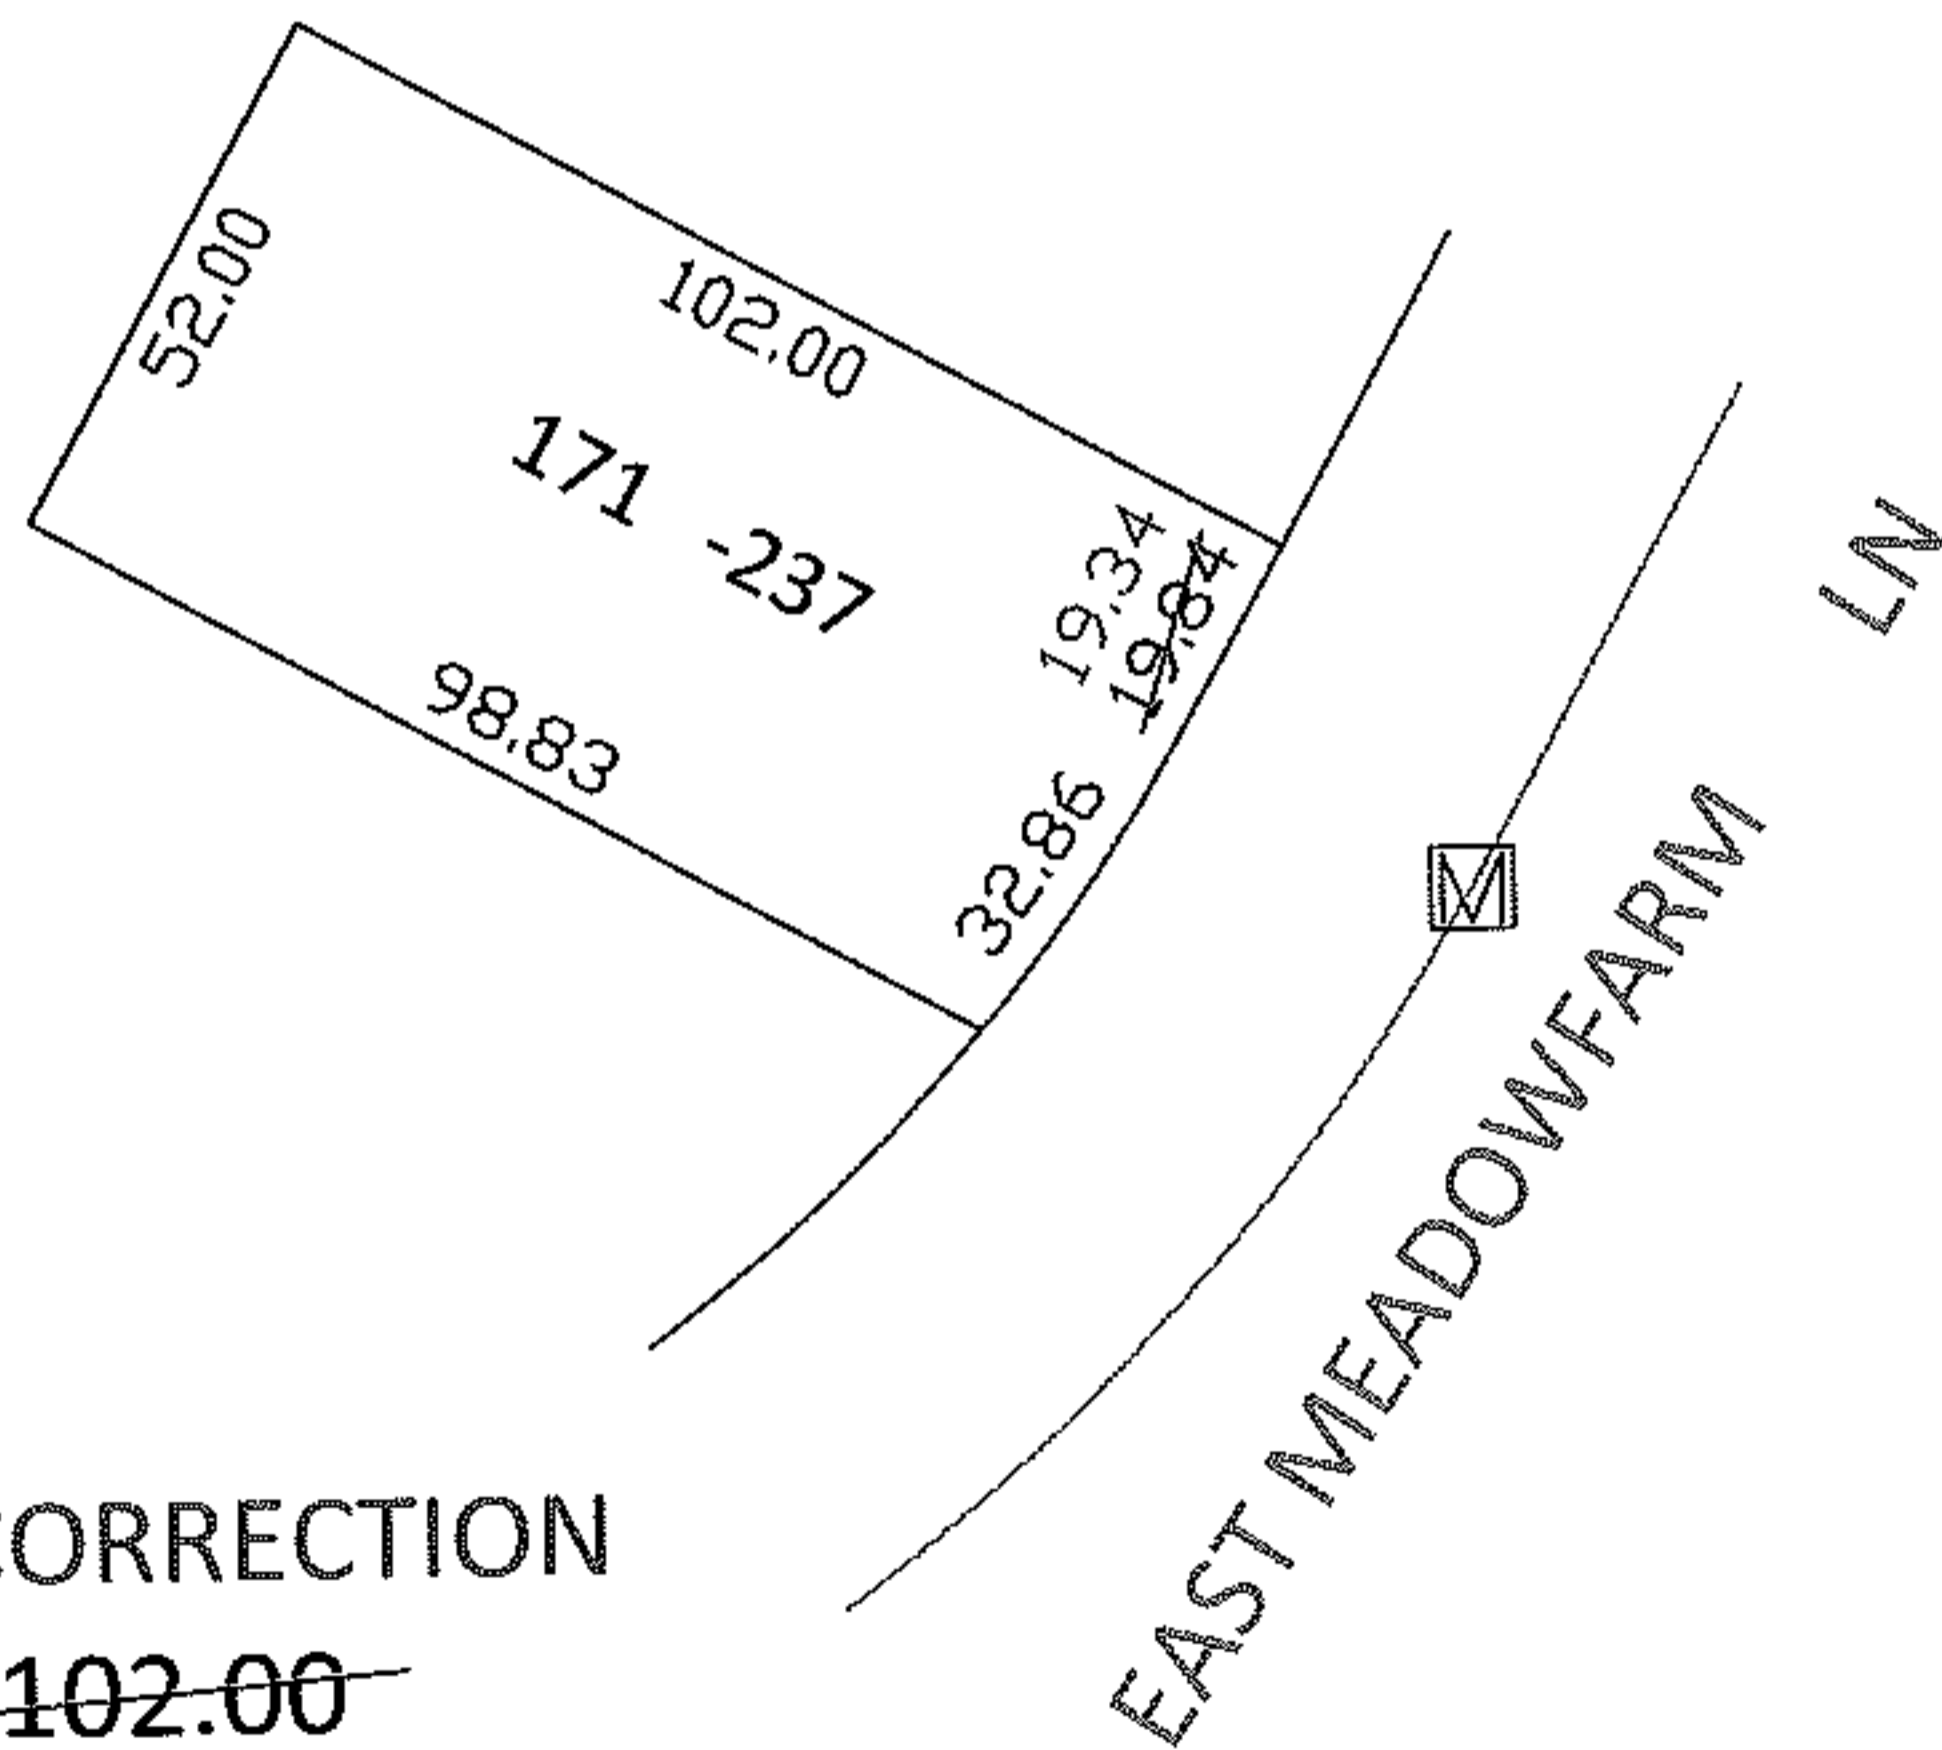


FRONTAGE CORRECTION

~~52.70 X 102.00~~

52.20 X 102.00

EAST MEADOWFARM LN.

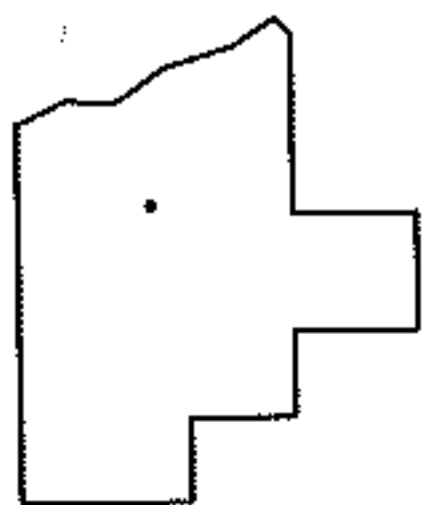

SPLITS/DEEDS PROCESSED

LORAIN COUNTY TAX MAP DEPARTMENT
226 MIDDLE AVE. ELYRIA, OHIO

SURVEYED BY: DAVID L. ELWELL

CLOSURE: N/A

MAP PAGE(S): 05-00-001-A

APPROVED BY: RRM DATE: 1-21-10

SCALE: 1"= 50 PRIOR INST.: V.95 PG.23-25