
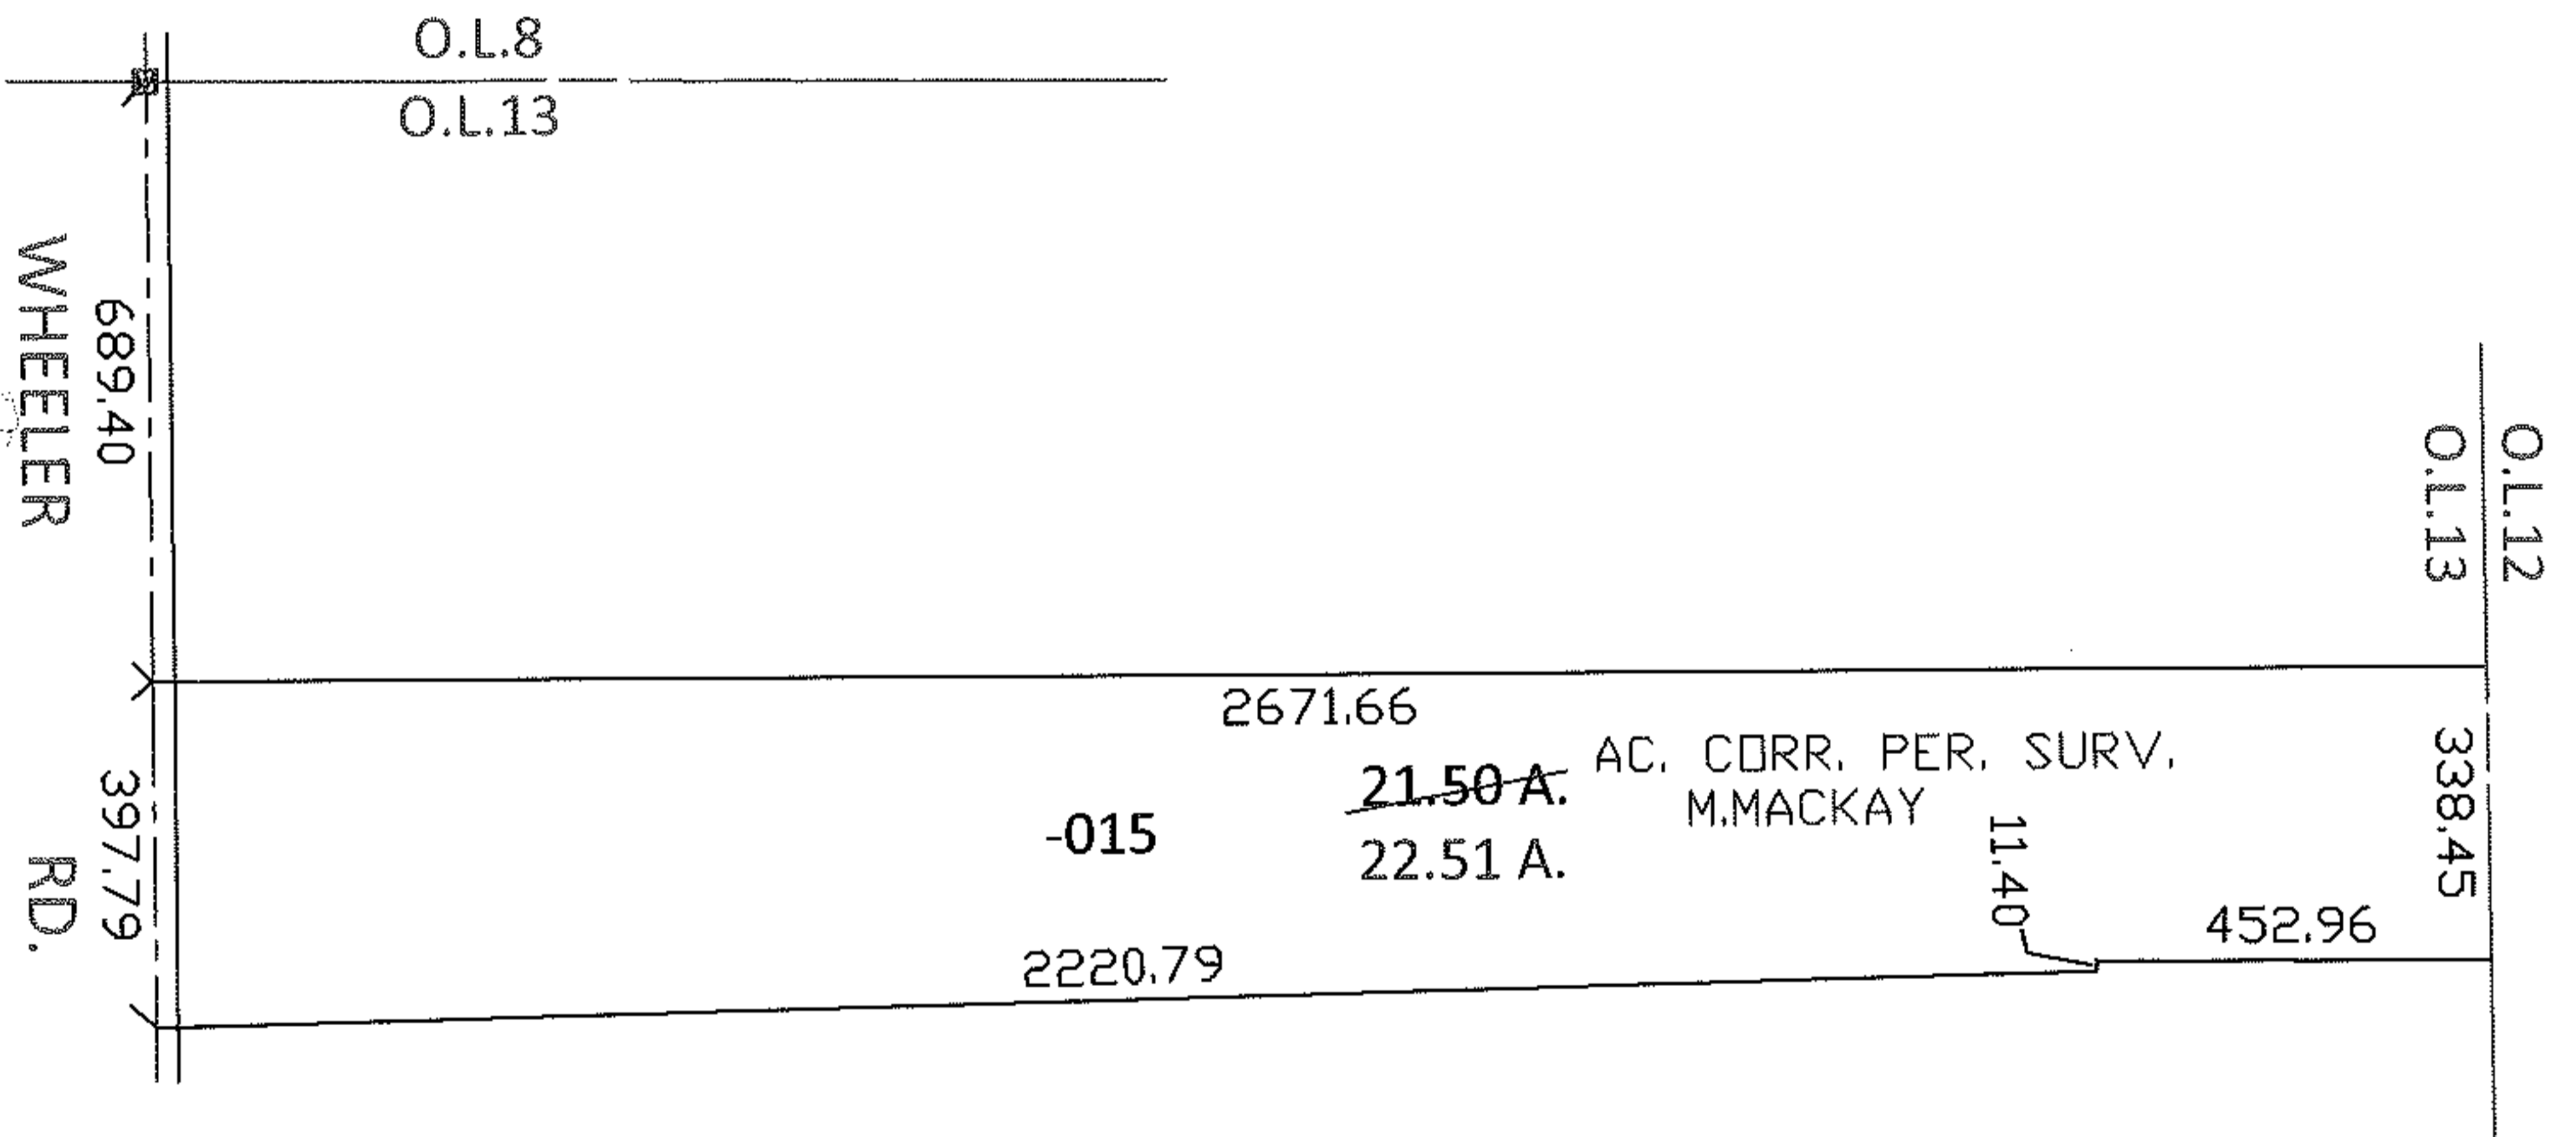


PARENT PARCEL: 15-00-013-000-015


CHILD PARCEL: _____

STARTING POINT: INTERSECTION OF C/L OF WHEELER RD. AND NORTHWEST CORNER OF O/L 13

10-01947-C

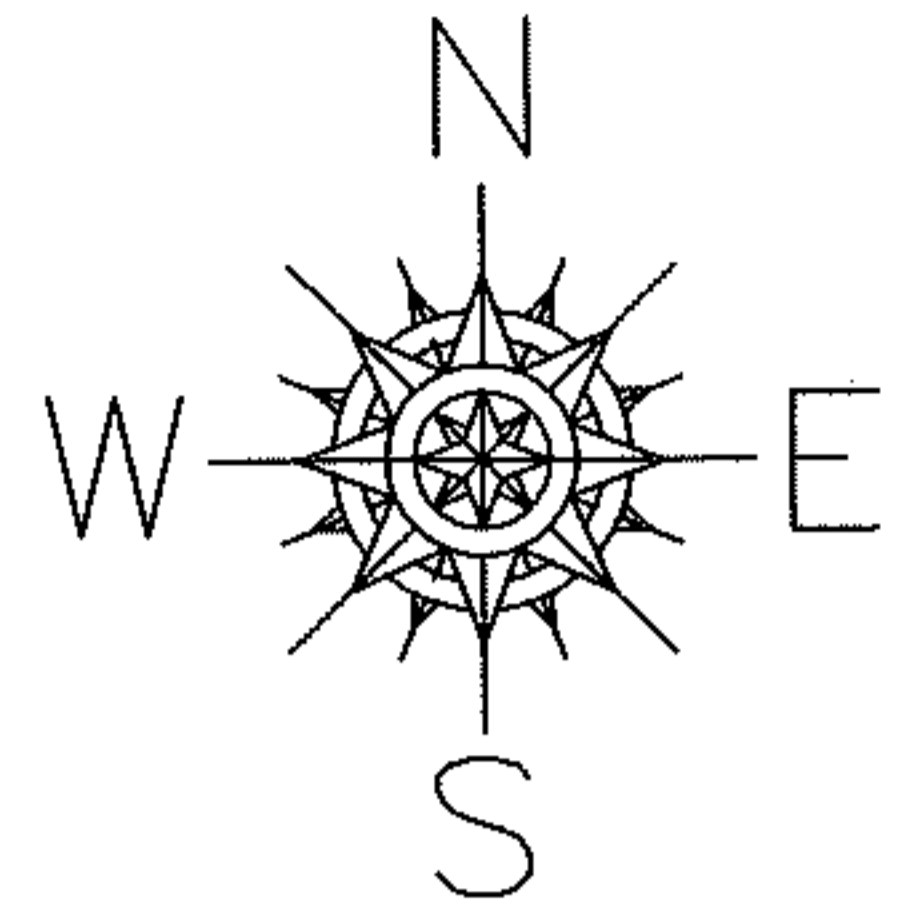

* DV 587/563
* DV 436/110

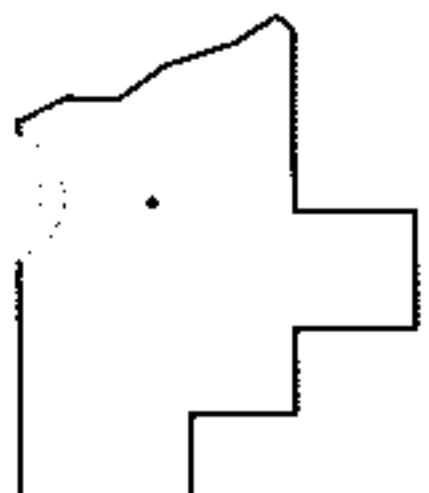

SPLITS/DEEDS PROCESSED

LORAIN COUNTY TAX MAP DEPARTMENT
226 MIDDLE AVE. ELYRIA, OHIO

SURVEYED BY: MICHAEL MACKAY

CLOSURE: .01:10,000

MAP PAGE(S): 15-D

APPROVED BY: RRM DATE: 1-21-10

SCALE: 1"= 400 PRIOR INST.: * SEE ABOVE