
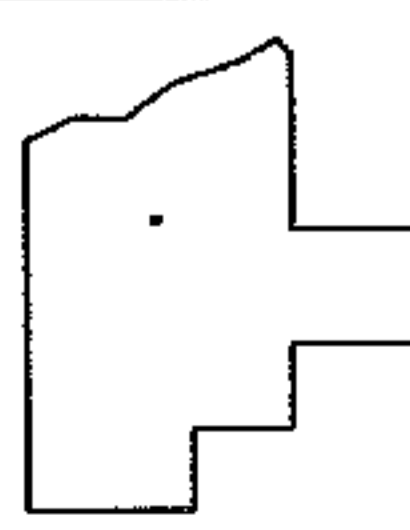
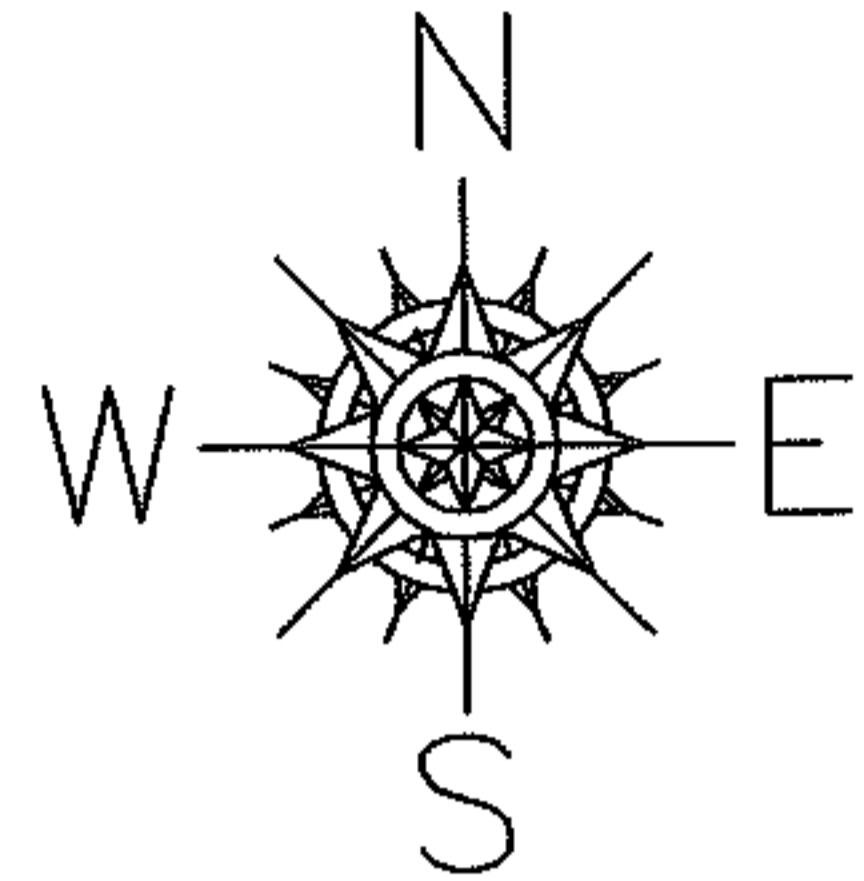


PARENT PARCEL: 18-00-032-000-008, -007

CHILD PARCEL: 18-00-032-000-021 THRU -024

STARTING POINT: CENTERLINE OF PECK-WADSWORTH RD. & PITTS RD.

NO. 01948

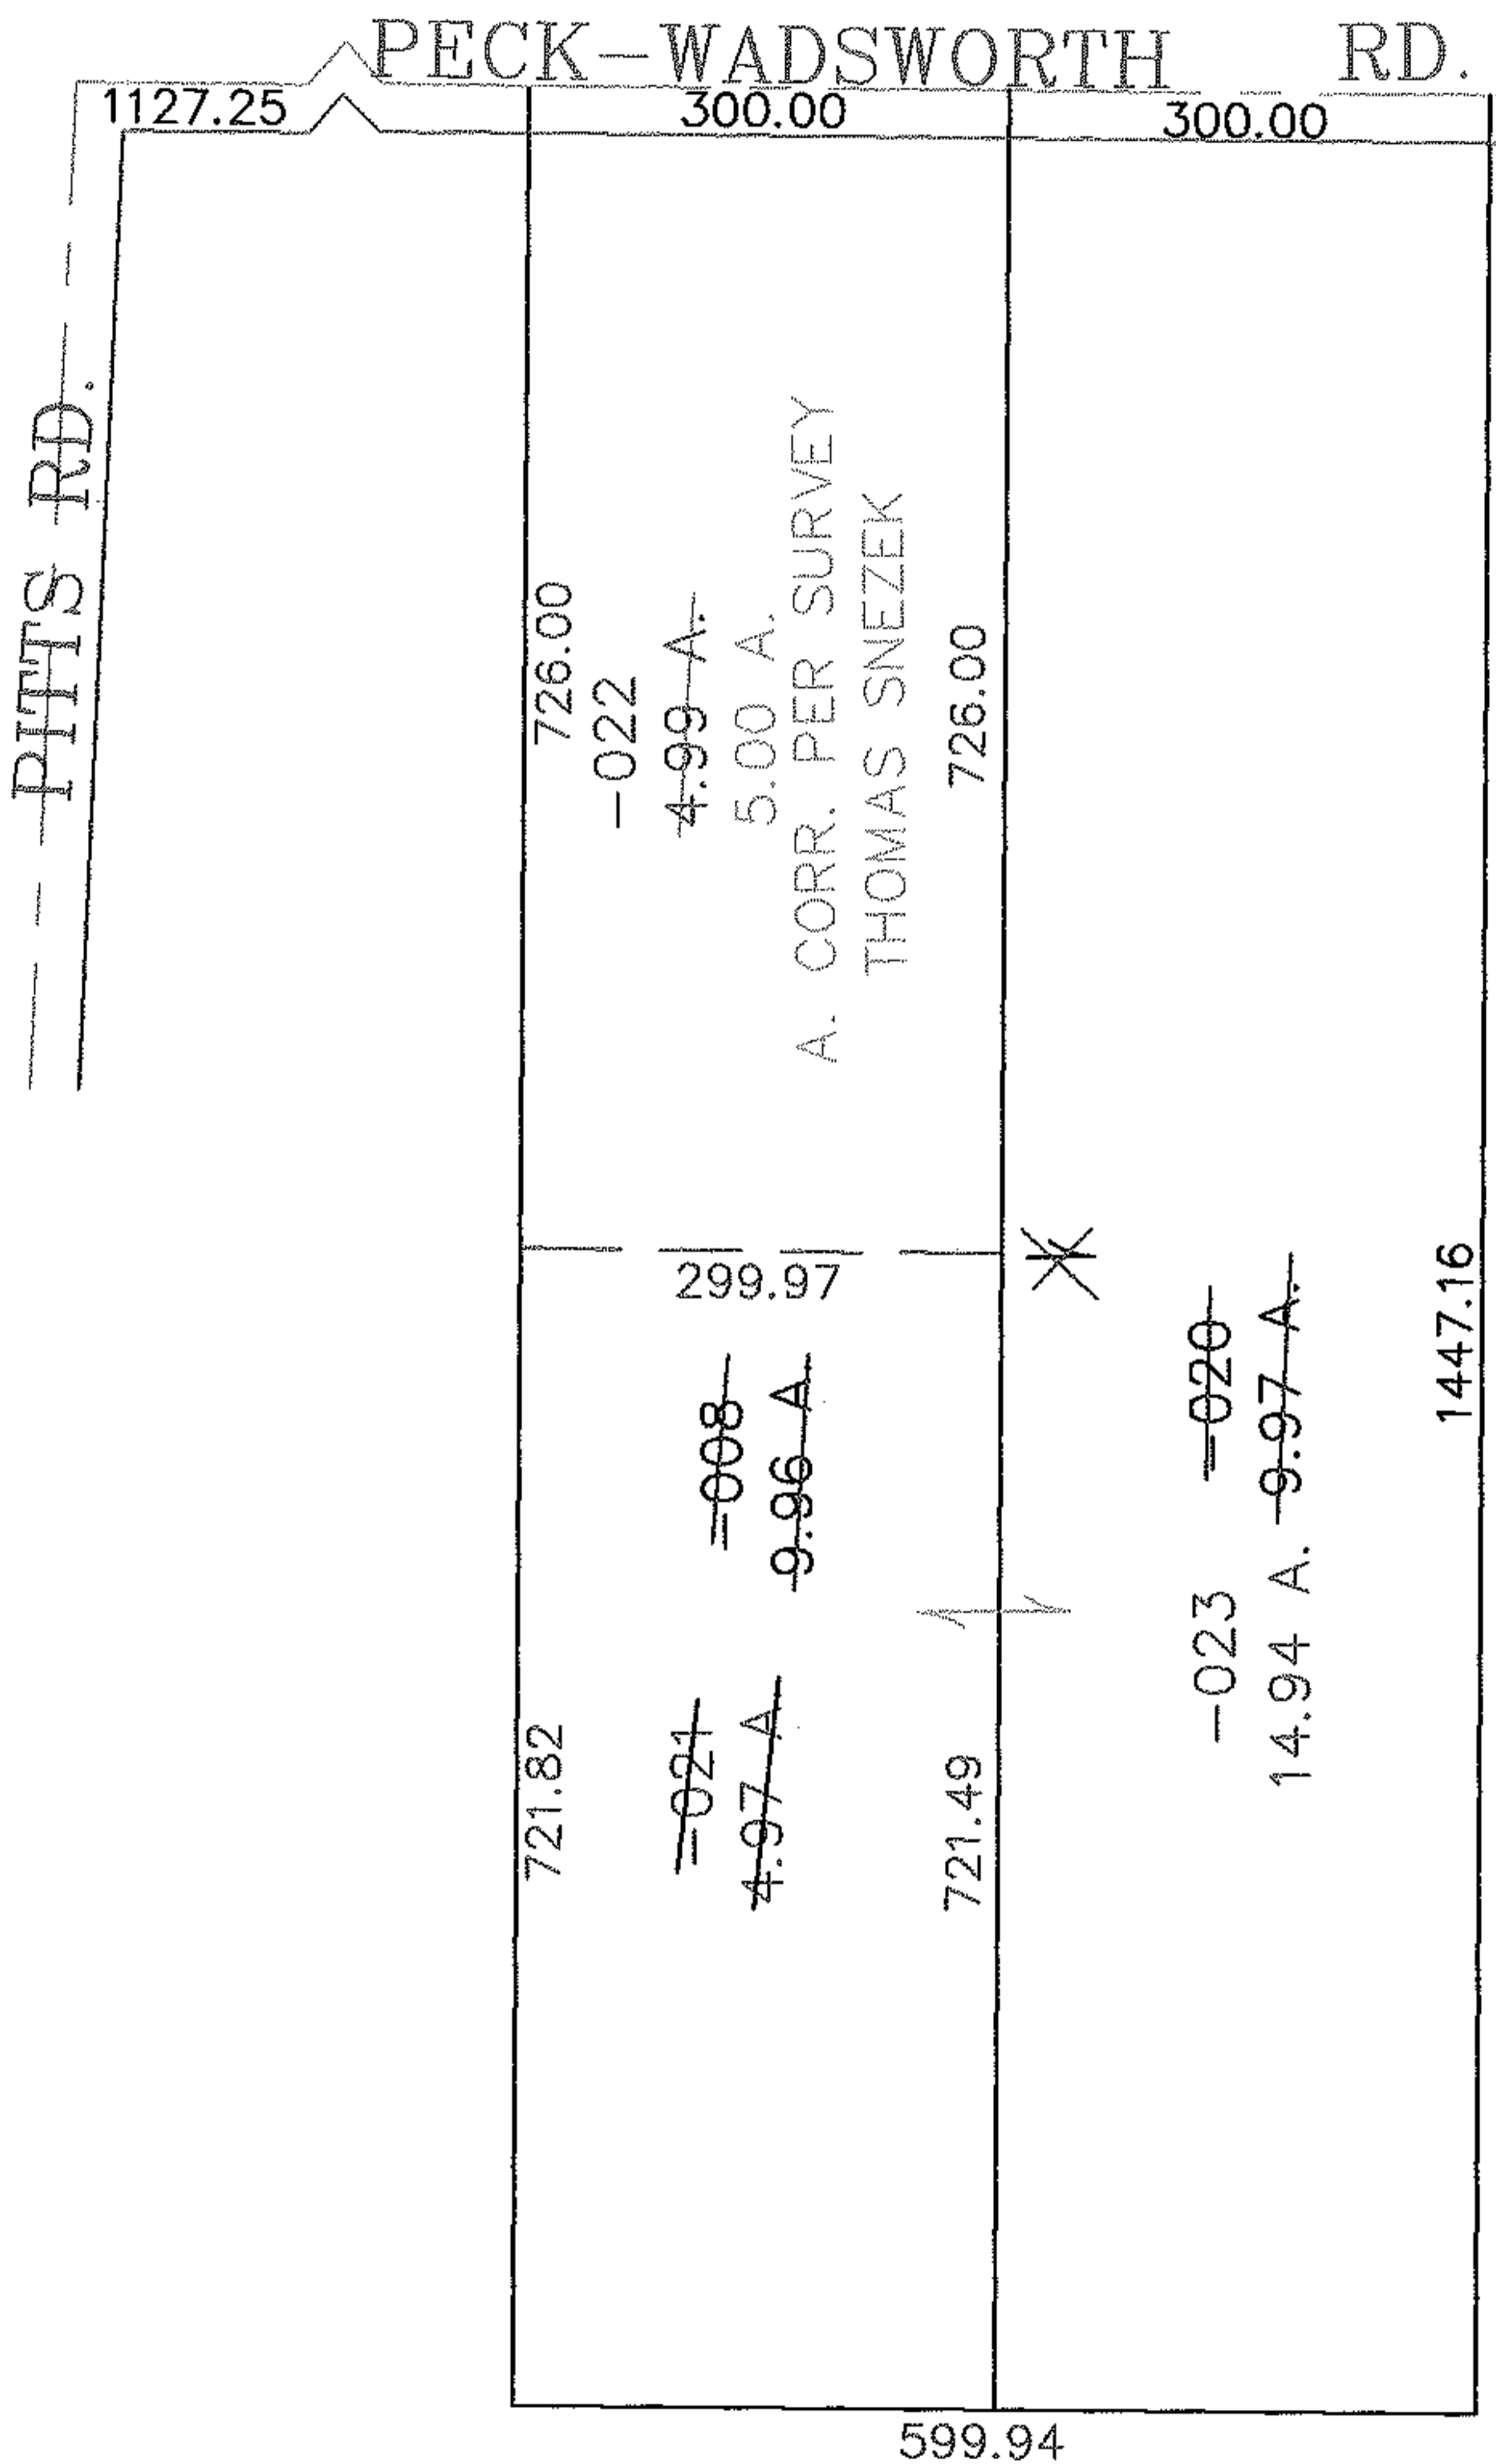

SPLITS/DEEDS PROCESSED
 LORAIN COUNTY TAX MAP DEPARTMENT
 226 MIDDLE AVE. ELYRIA, OHIO

SURVEYED BY: THOMAS SNEZEK
 CLOSURE: 0.00 : 10,000
 MAP PAGE(S): 18-B
 APPROVED BY: JAH DATE: 6-29-05
 SCALE: 1" = 200 PRIOR INSTRUMENT: 980529631