


PARENT PARCEL: 15-00-033-000-003, -004

CHILD PARCEL: 15-00-033-000-025


10-01955-D

STARTING POINT: INTERSECTION OF C/L OF BIGGS RD. AND NORTHEAST CORNER OF O.L.33

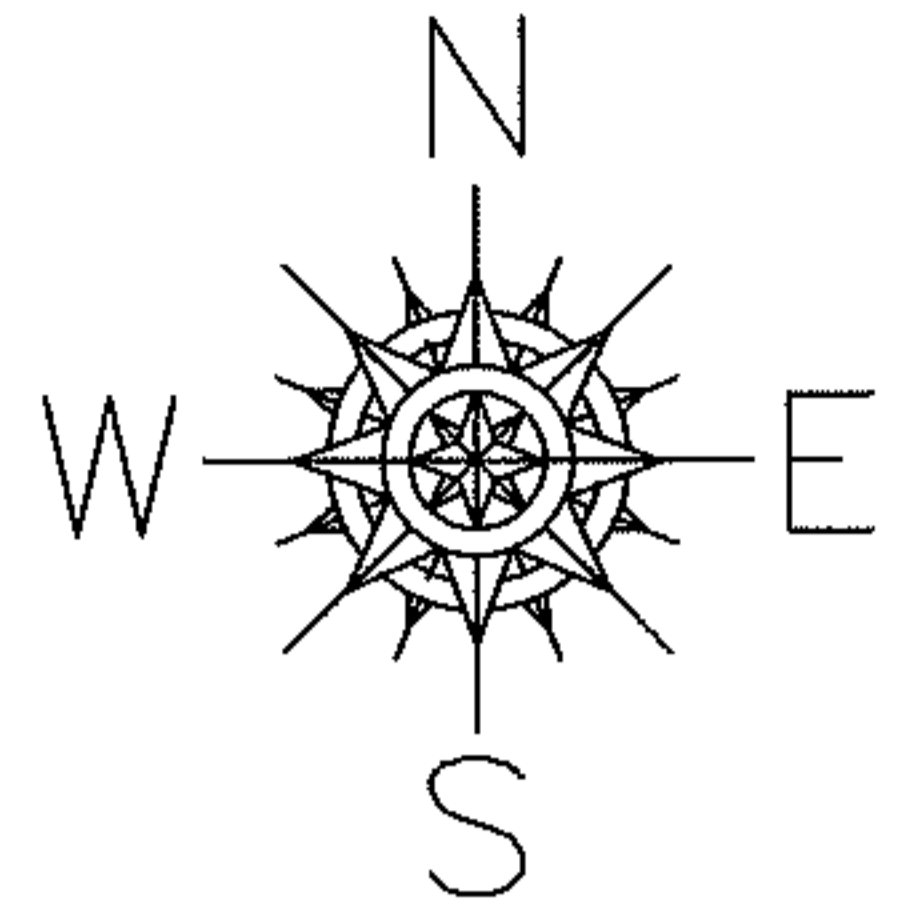


COMBINATION

PER PRIOR DEED O.R. 1221/776

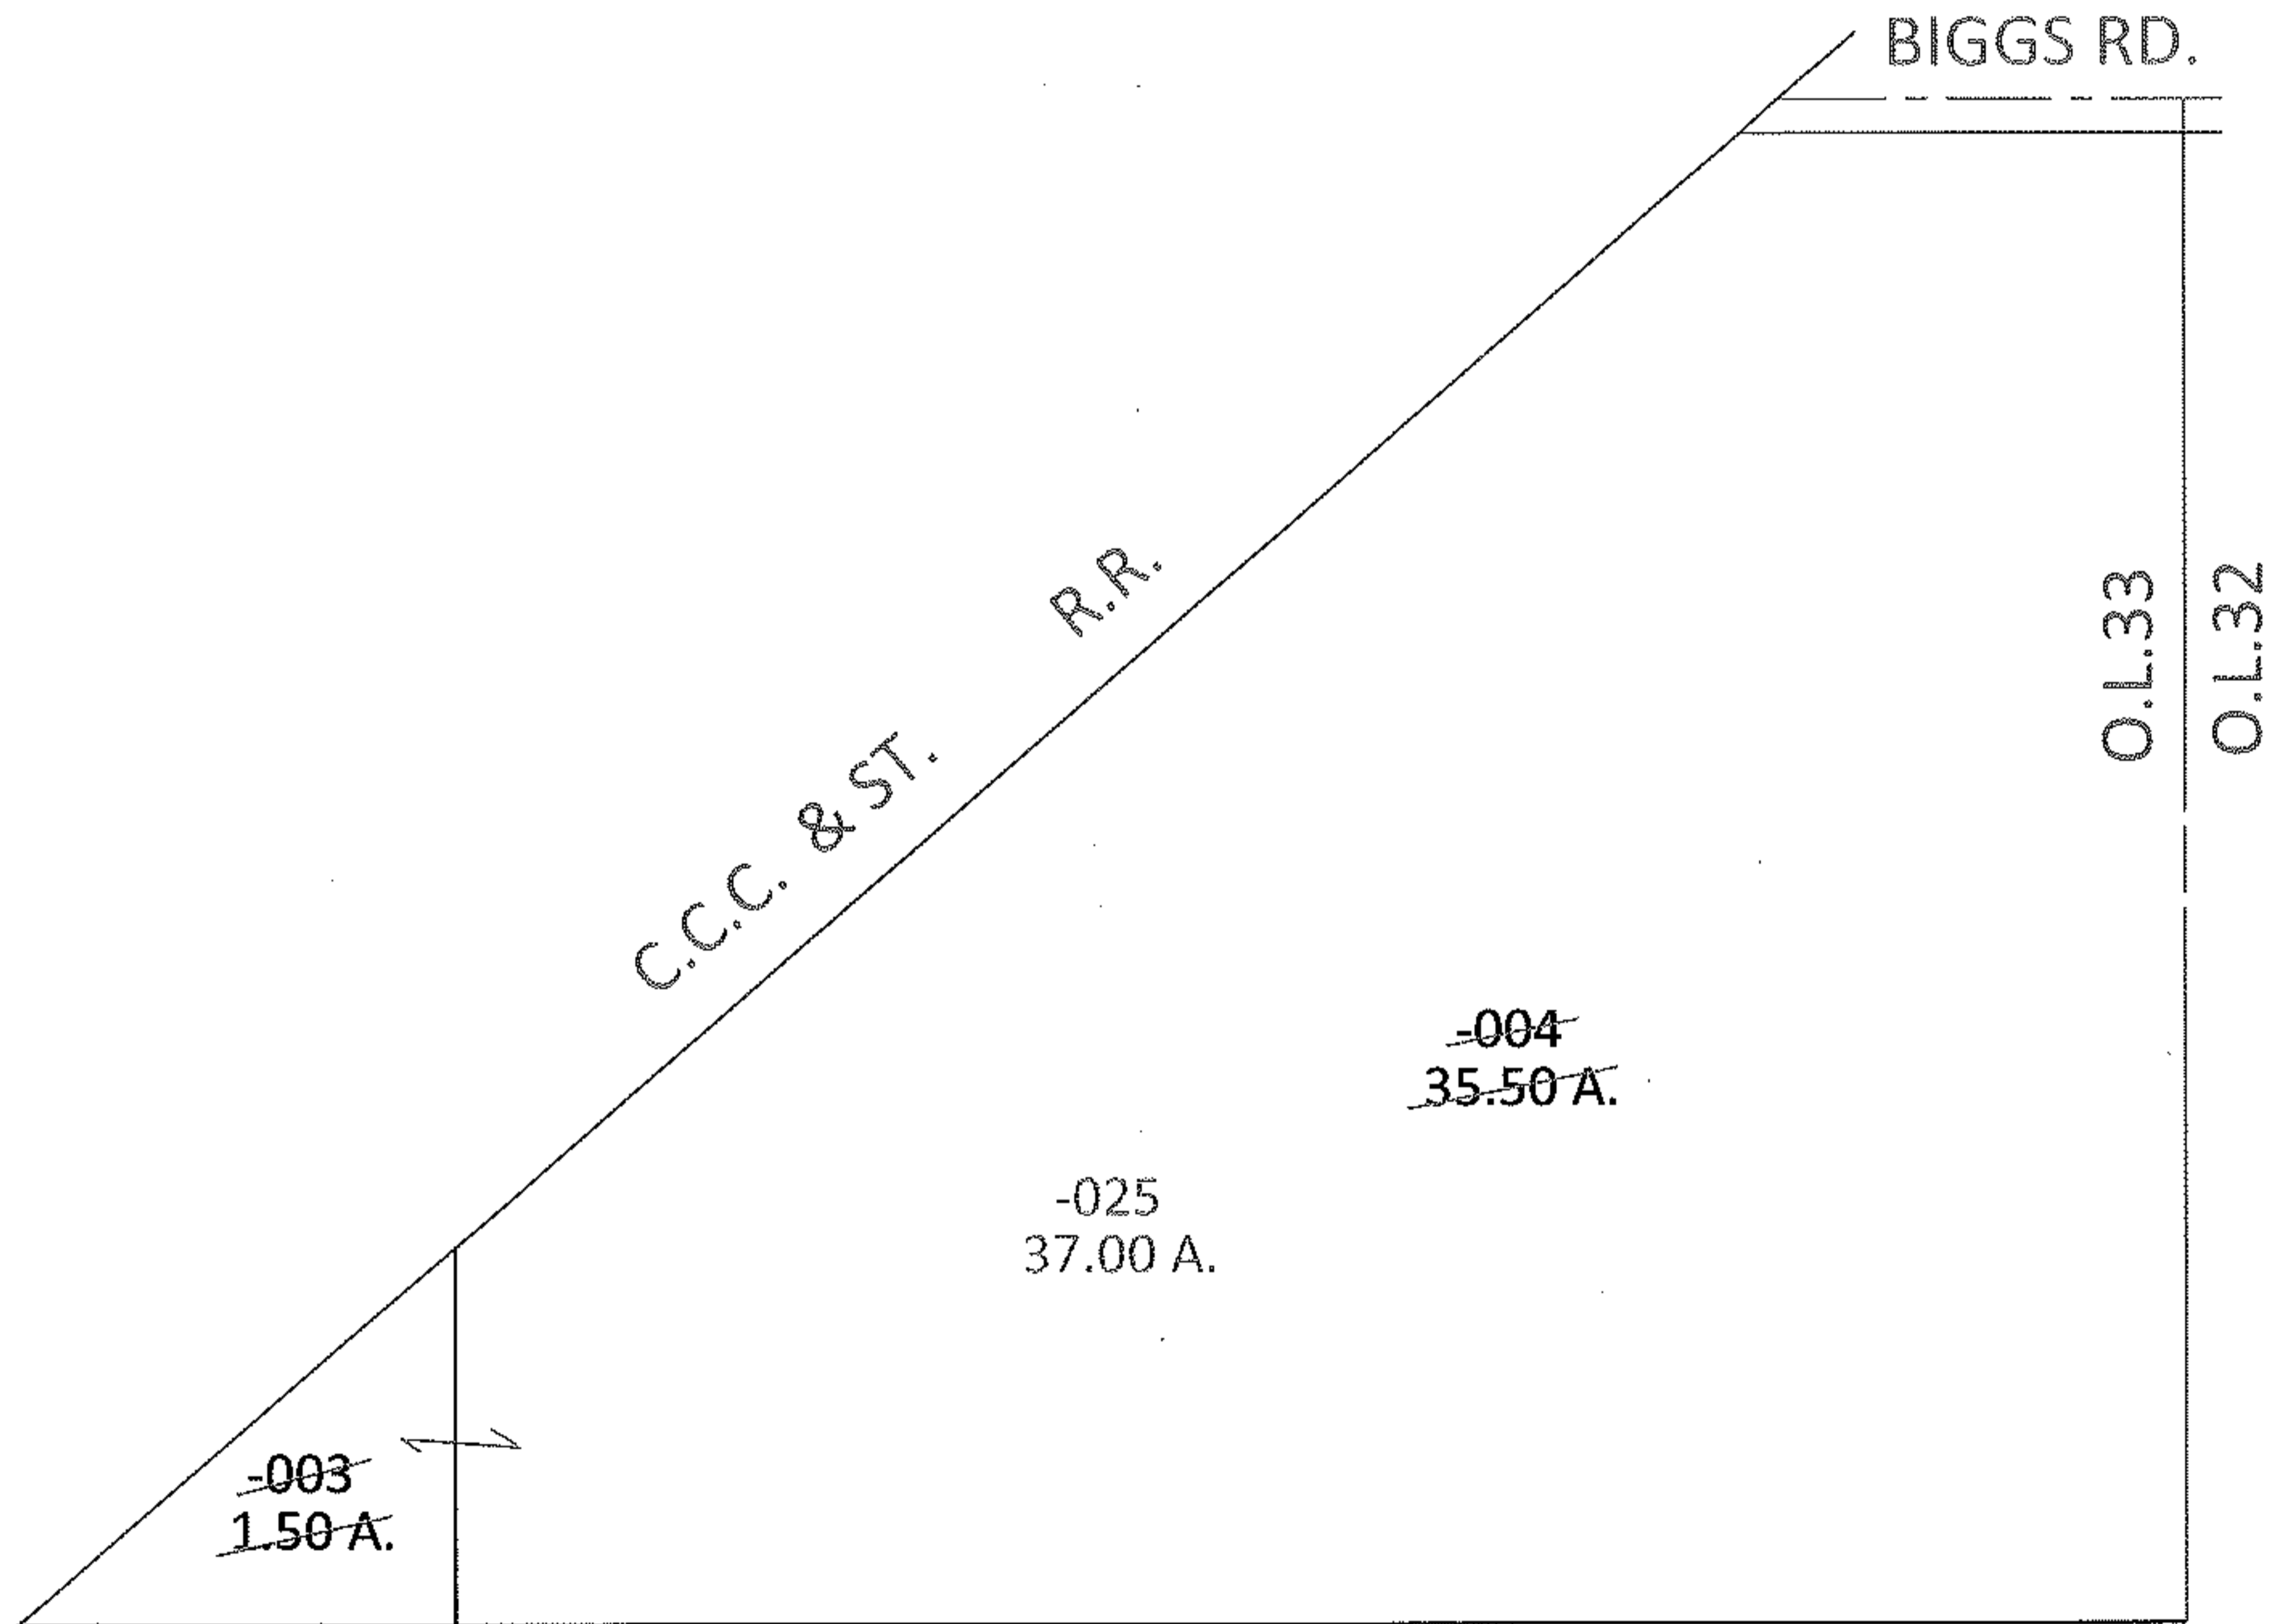

MAP 1 OF 3

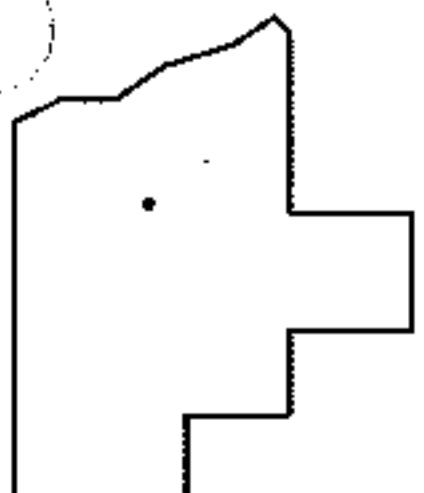

SPLITS/DEEDS PROCESSED

LORAIN COUNTY TAX MAP DEPARTMENT  
226 MIDDLE AVE. ELYRIA, OHIO

SURVEYED BY: N/A

CLOSURE: N/A

MAP PAGE(S): 15-D

APPROVED BY: RRM DATE: 2-8-10

SCALE: 1"= 300 PRIOR INST.: OR 1221/776