



KASTER

PARENT PARCEL: 01-00-025-000-022, 01-00-040-000-002 THRU -004, 009, 021

CHILD PARCEL: 01-00-025-000-026 THRU -028, 01-00-040-000-027


STARTING POINT: NORTHEAST CONER OF O.L. 25 & O.L. 40

NO. 01955

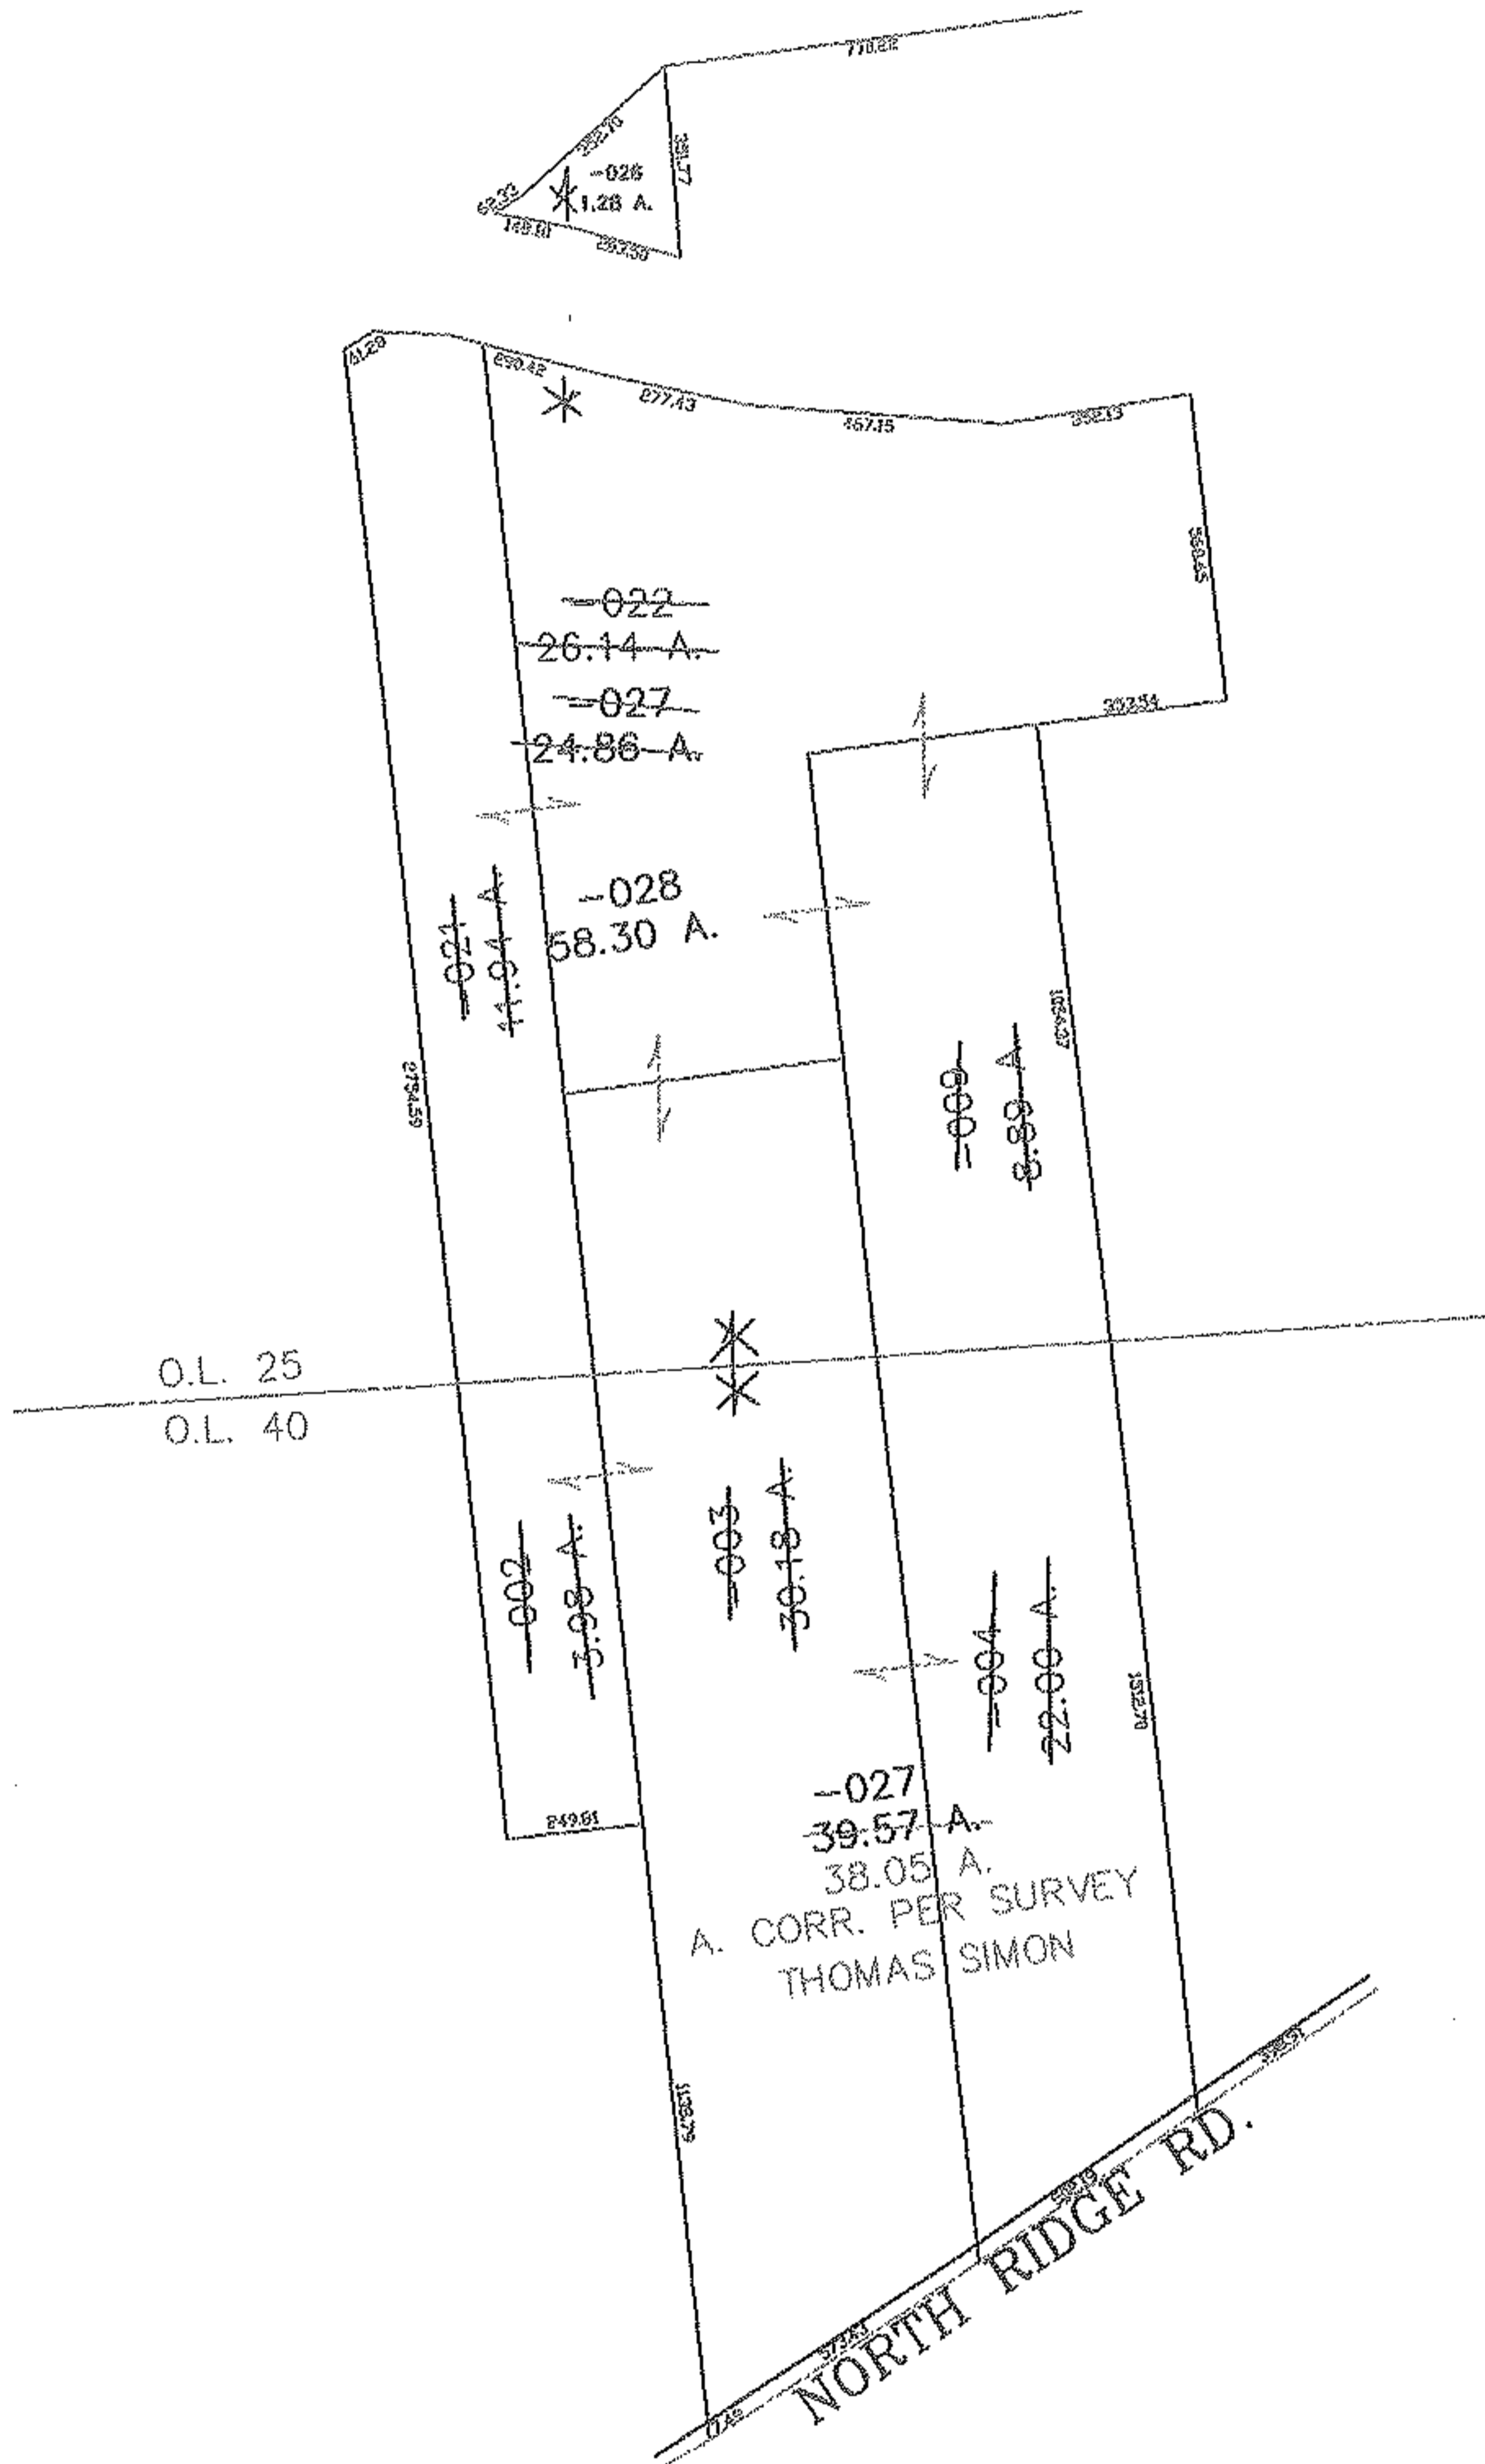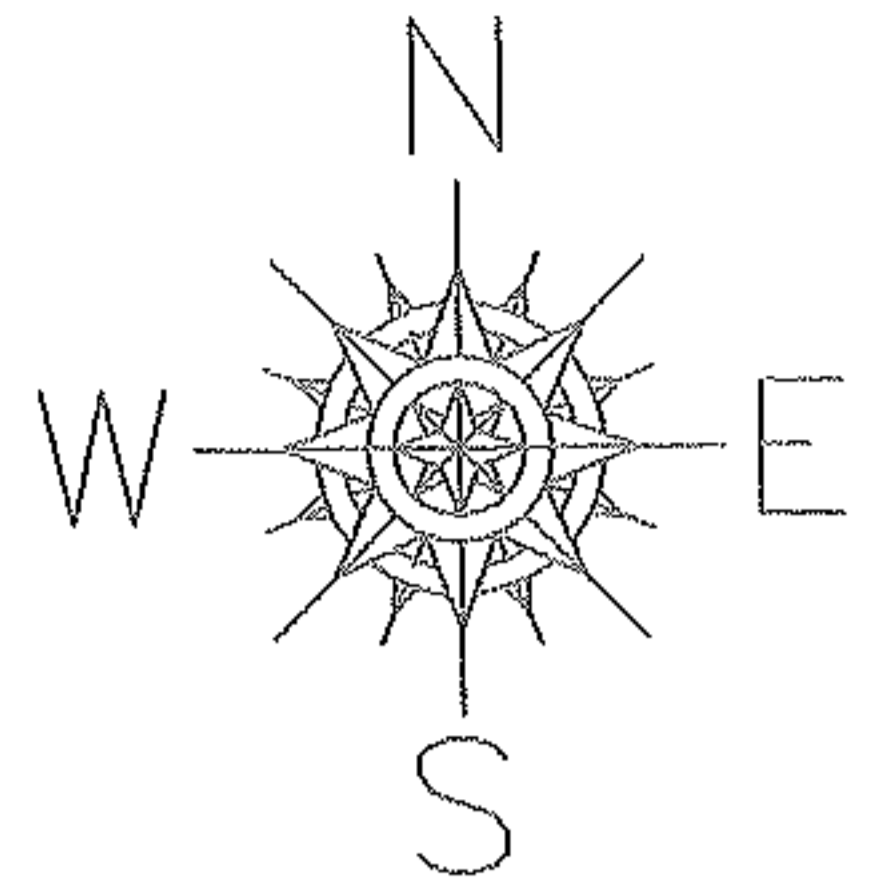

-027
39.57 A.
38.05 A.
A. CORR. PER SURVEY
THOMAS SIMON

NORTH RIDGE RD.

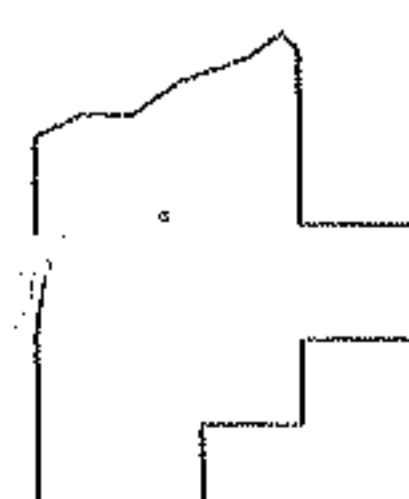

SPLITS/DEEDS PROCESSED

LORAIN COUNTY TAX MAP DEPARTMENT
226 MIDDLE AVE. ELYRIA, OHIO

SURVEYED BY: THOMAS SIMON

CLOSURE: 0.00 : 10.000

MAP PAGE(S): 01-00-025-B, 01-00-040-A

APPROVED BY: JAH DATE: 7-18-05

SCALE: 1" = 600 PRIOR INSTRUMENT: DV 686/455