
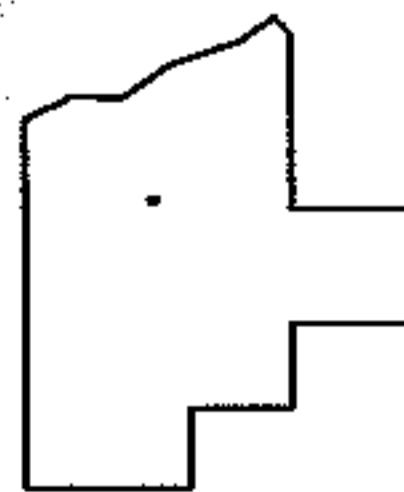
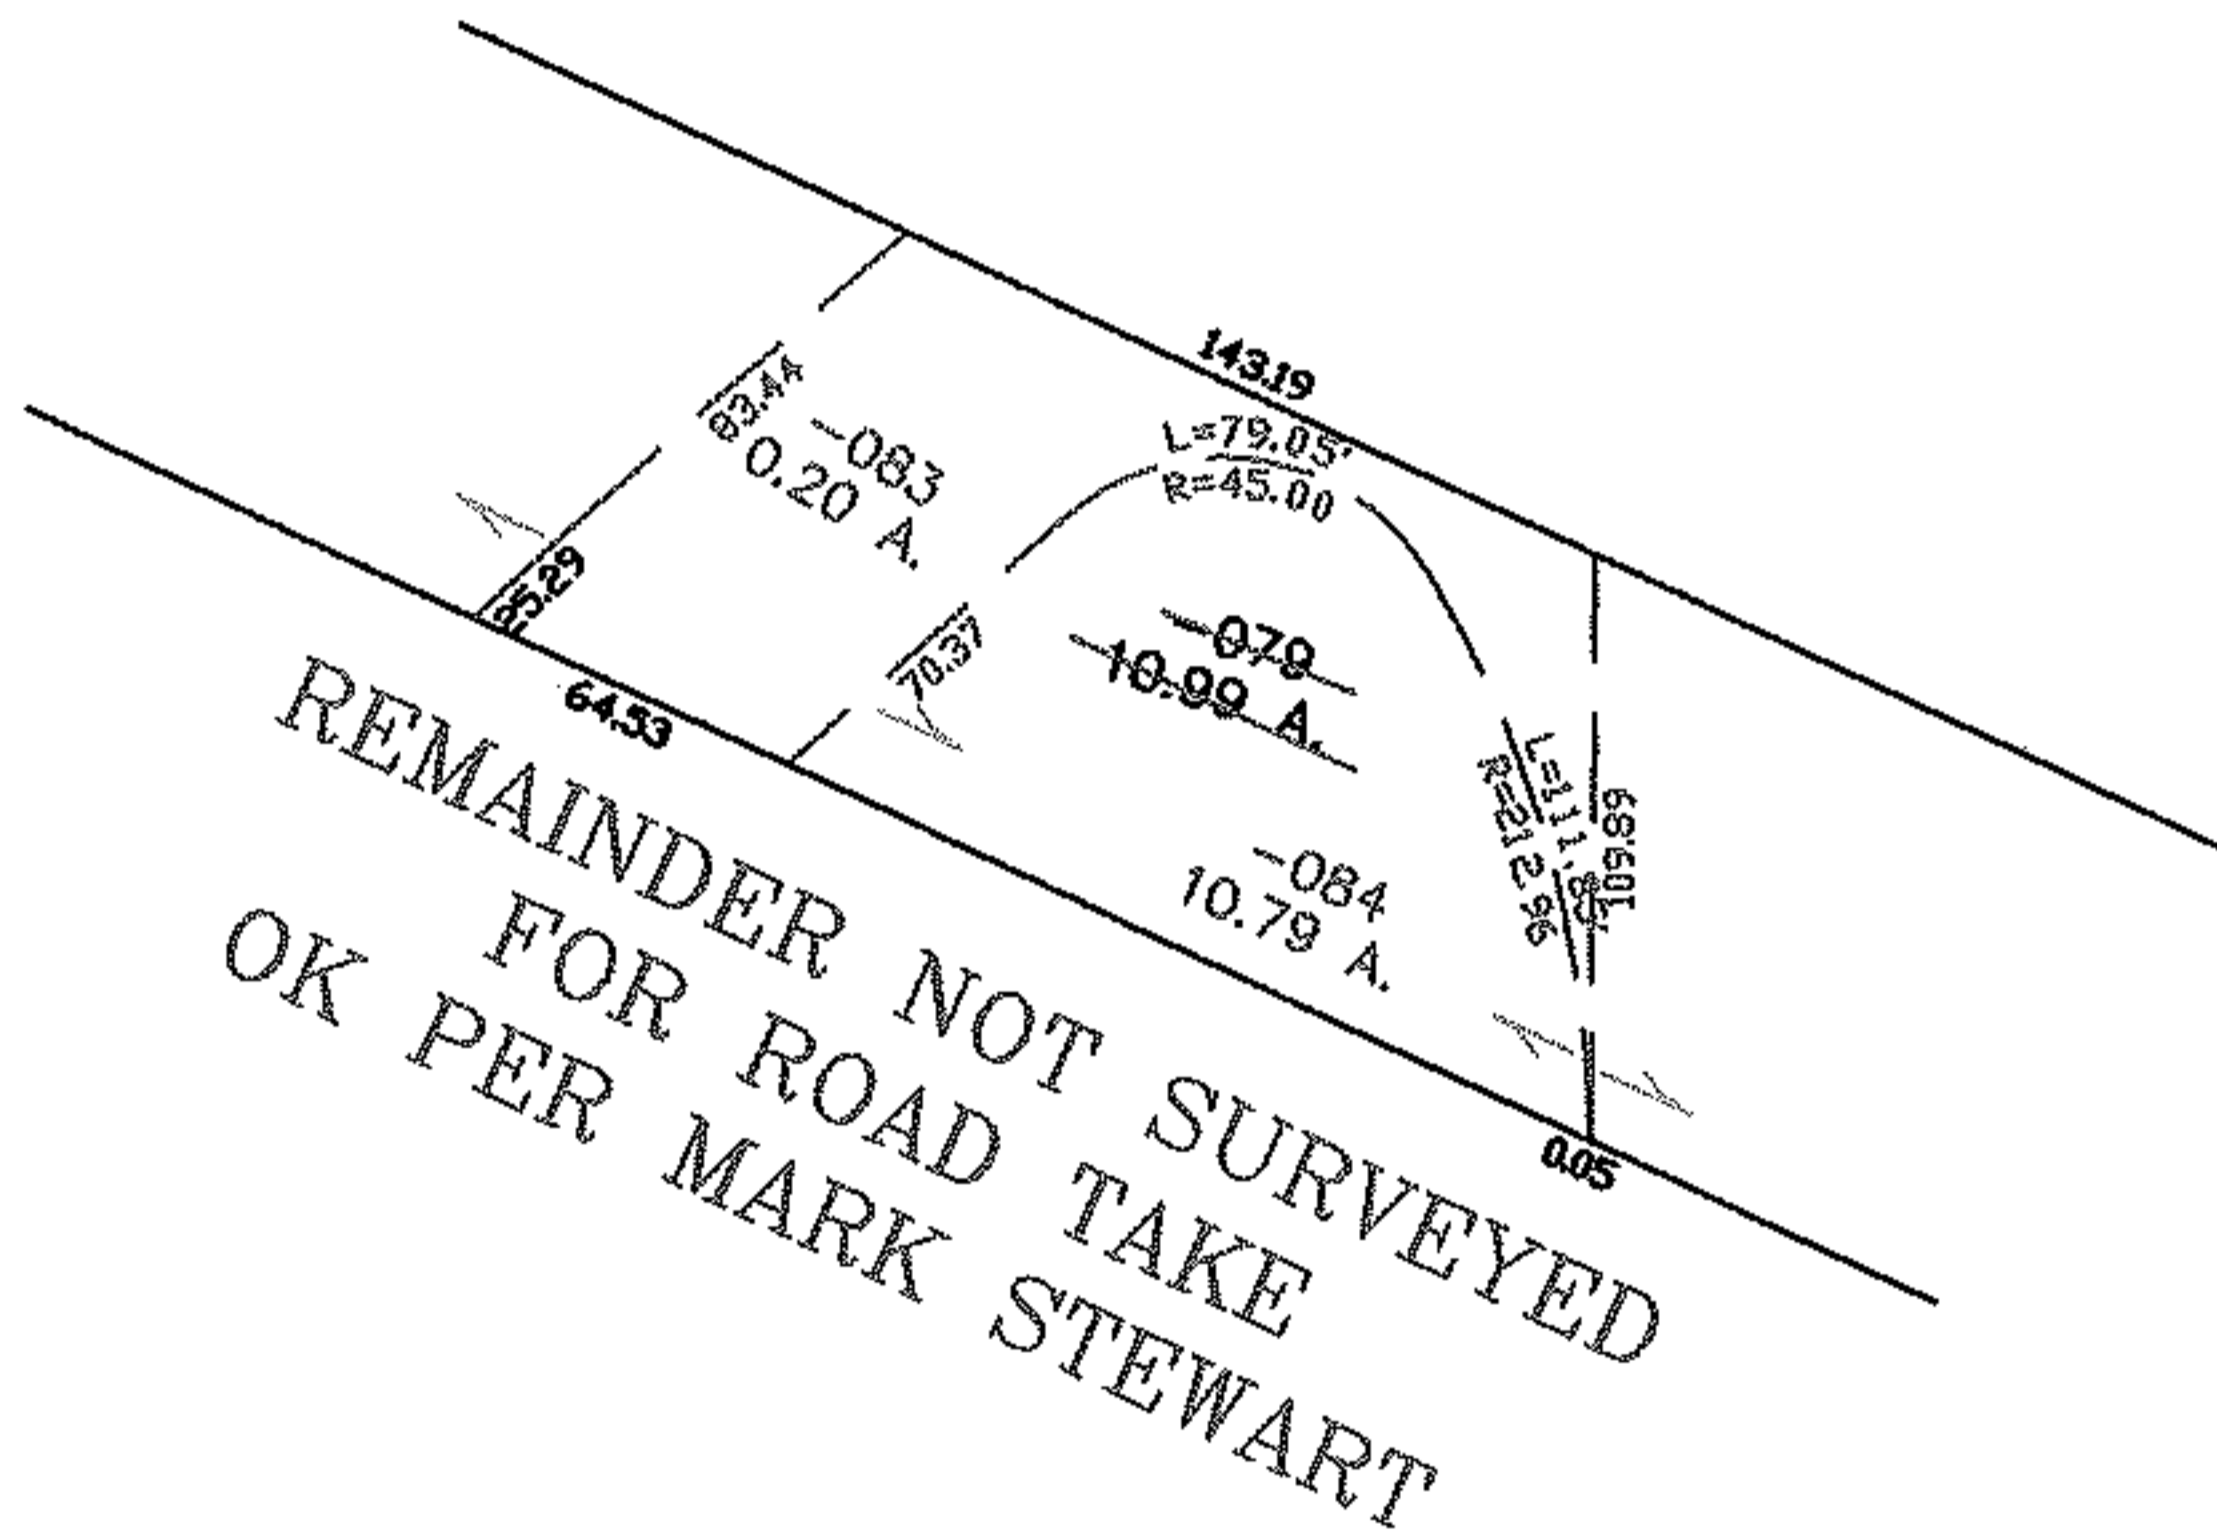


PARENT PARCEL: 07-00-008-115-079

CHILD PARCEL: 07-00-008-115-083, -084

STARTING POINT: OR 246/82

NO. 01957

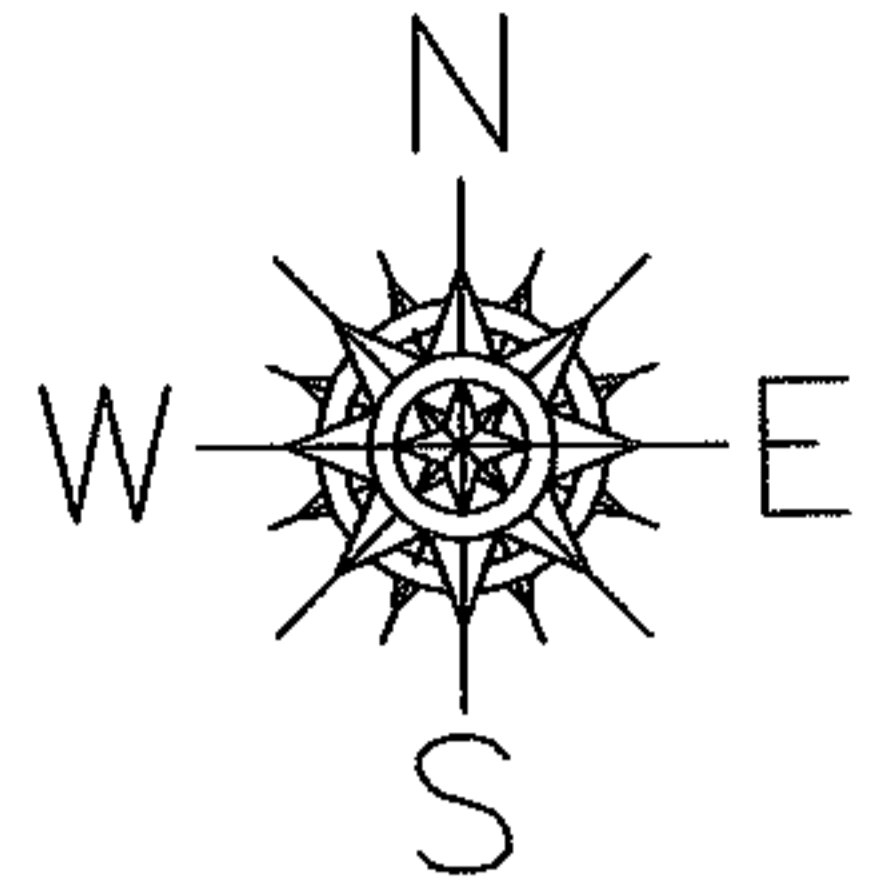

**SPLITS/DEEDS PROCESSED**

LORAIN COUNTY TAX MAP DEPARTMENT  
226 MIDDLE AVE. ELYRIA, OHIO

SURVEYED BY: MARK A. YEAGER

CLOSURE: 0.00 : 10,000

MAP PAGE(S): 07-00-008-D

APPROVED BY: JAH DATE: 8-2-05

SCALE: 1" = 100 PRIOR INSTRUMENT: OR 246/82