


PARENT PARCEL: 03-00-103-111-044

CHILD PARCEL: _____


STARTING POINT: _____

10-01959-C

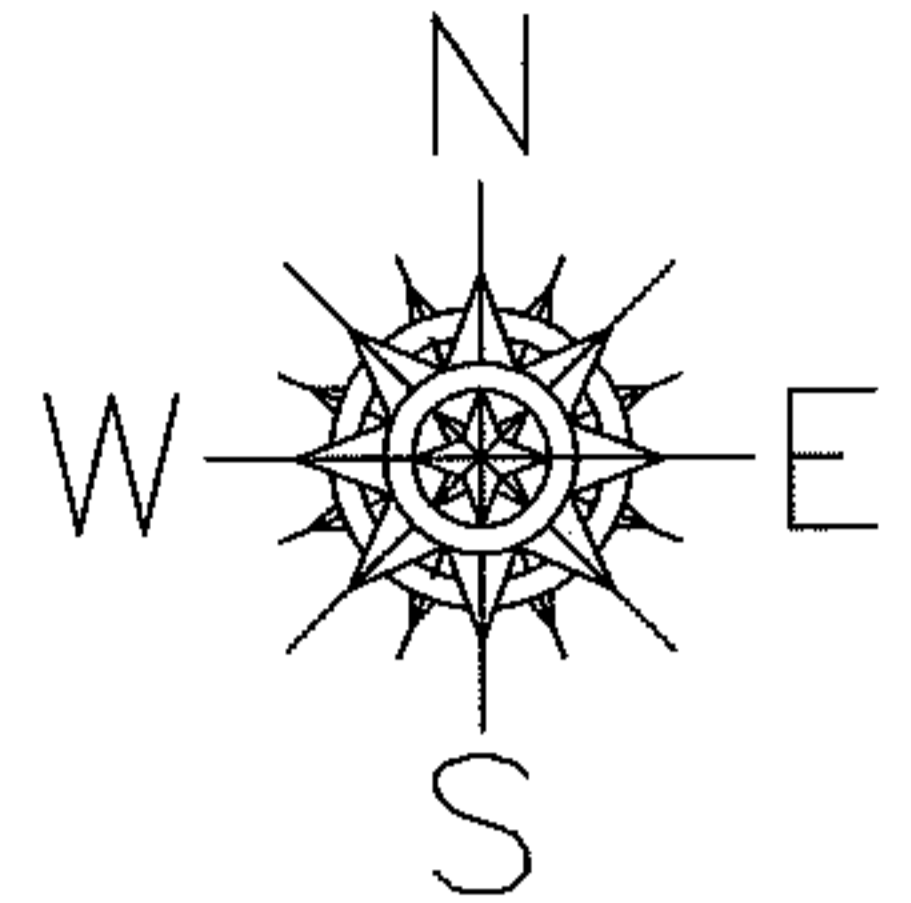

DEPTH CORRECTION

03-00-103-111-044
40.00 X 177.83
~~40.00 X 117.00~~
CITY VIEW ALLOT
PER PLAT VOL.7 PG.13

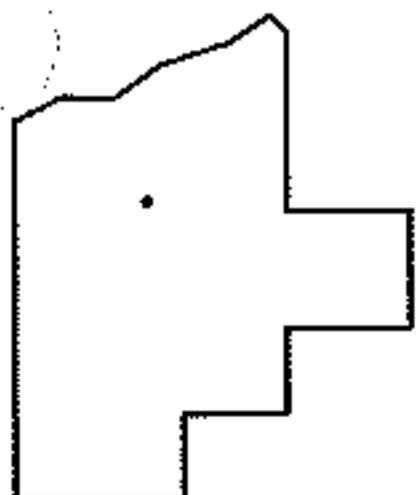

SPLITS/DEEDS PROCESSED

LORAIN COUNTY TAX MAP DEPARTMENT
226 MIDDLE AVE. ELYRIA, OHIO

SURVEYED BY: J.B. NICHOLS

CLOSURE: _____

MAP PAGE(S): 3-00-103-A

APPROVED BY: RRM DATE: 1-29-10

SCALE: 1"= 100 PRIOR INST.: DV 1160/175