


RASTER

PARENT PARCEL: 05-00-006-000-062

CHILD PARCEL: 05-00-006-000-223 THRU -225

STARTING POINT: SOUTHWESTERLY CORNER OF S/2 IN RICHARD SCHNIEDER'S MIDDLE RIDGE SUBD

NO. 01960

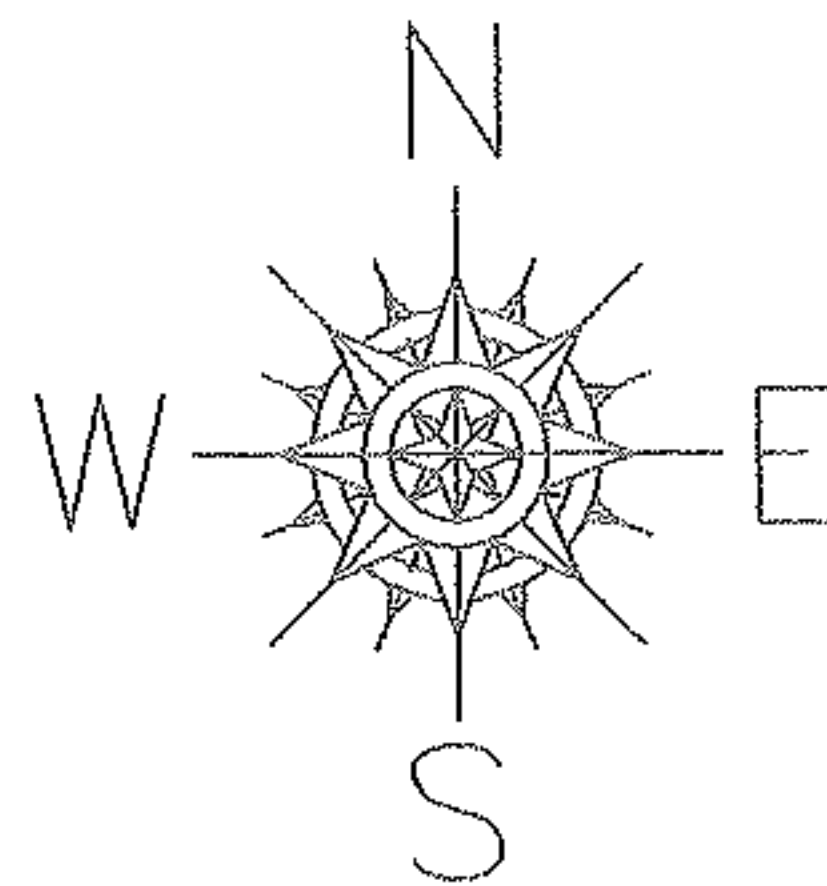

MIDDLE RIDGE RD.
200.00

RICHARD P. SCHNEIDER
MIDDLE RIDGE SUBD.
VOL 47 / 47

1

2
~~=062~~
~~2.79 A.~~
-225
1.83 A.

370.78

451.46

97.35

97.35
-223
0.43 A.

-224
0.53 A.


218.48

263.82

173.14

100.00

100.00

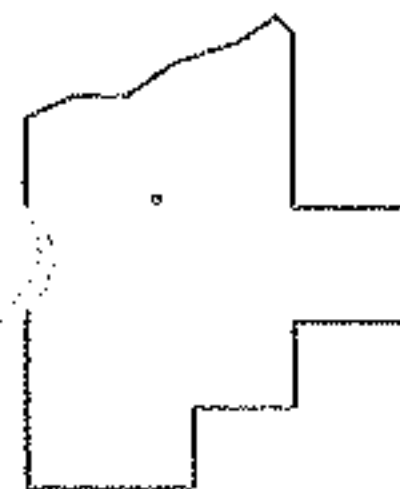

SPLITS/DEEDS PROCESSED

LORAIN COUNTY TAX MAP DEPARTMENT
226 MIDDLE AVE. ELYRIA, OHIO

SURVEYED BY: PHILLIP A. ROSEBECK

CLOSURE: 0.00 : 10.000

MAP PAGE(S): VOL 47/47

APPROVED BY: JAH DATE: 7-20-05

SCALE: 1" = 100 PRIOR INSTRUMENT: VOL 47/47