
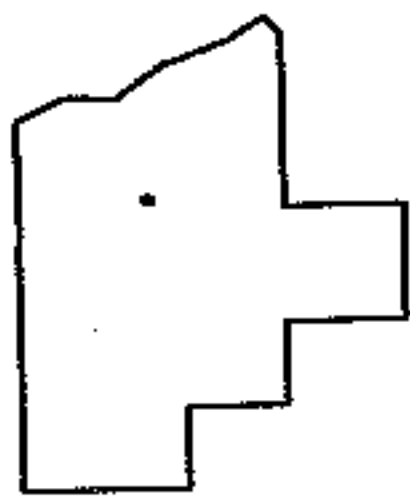
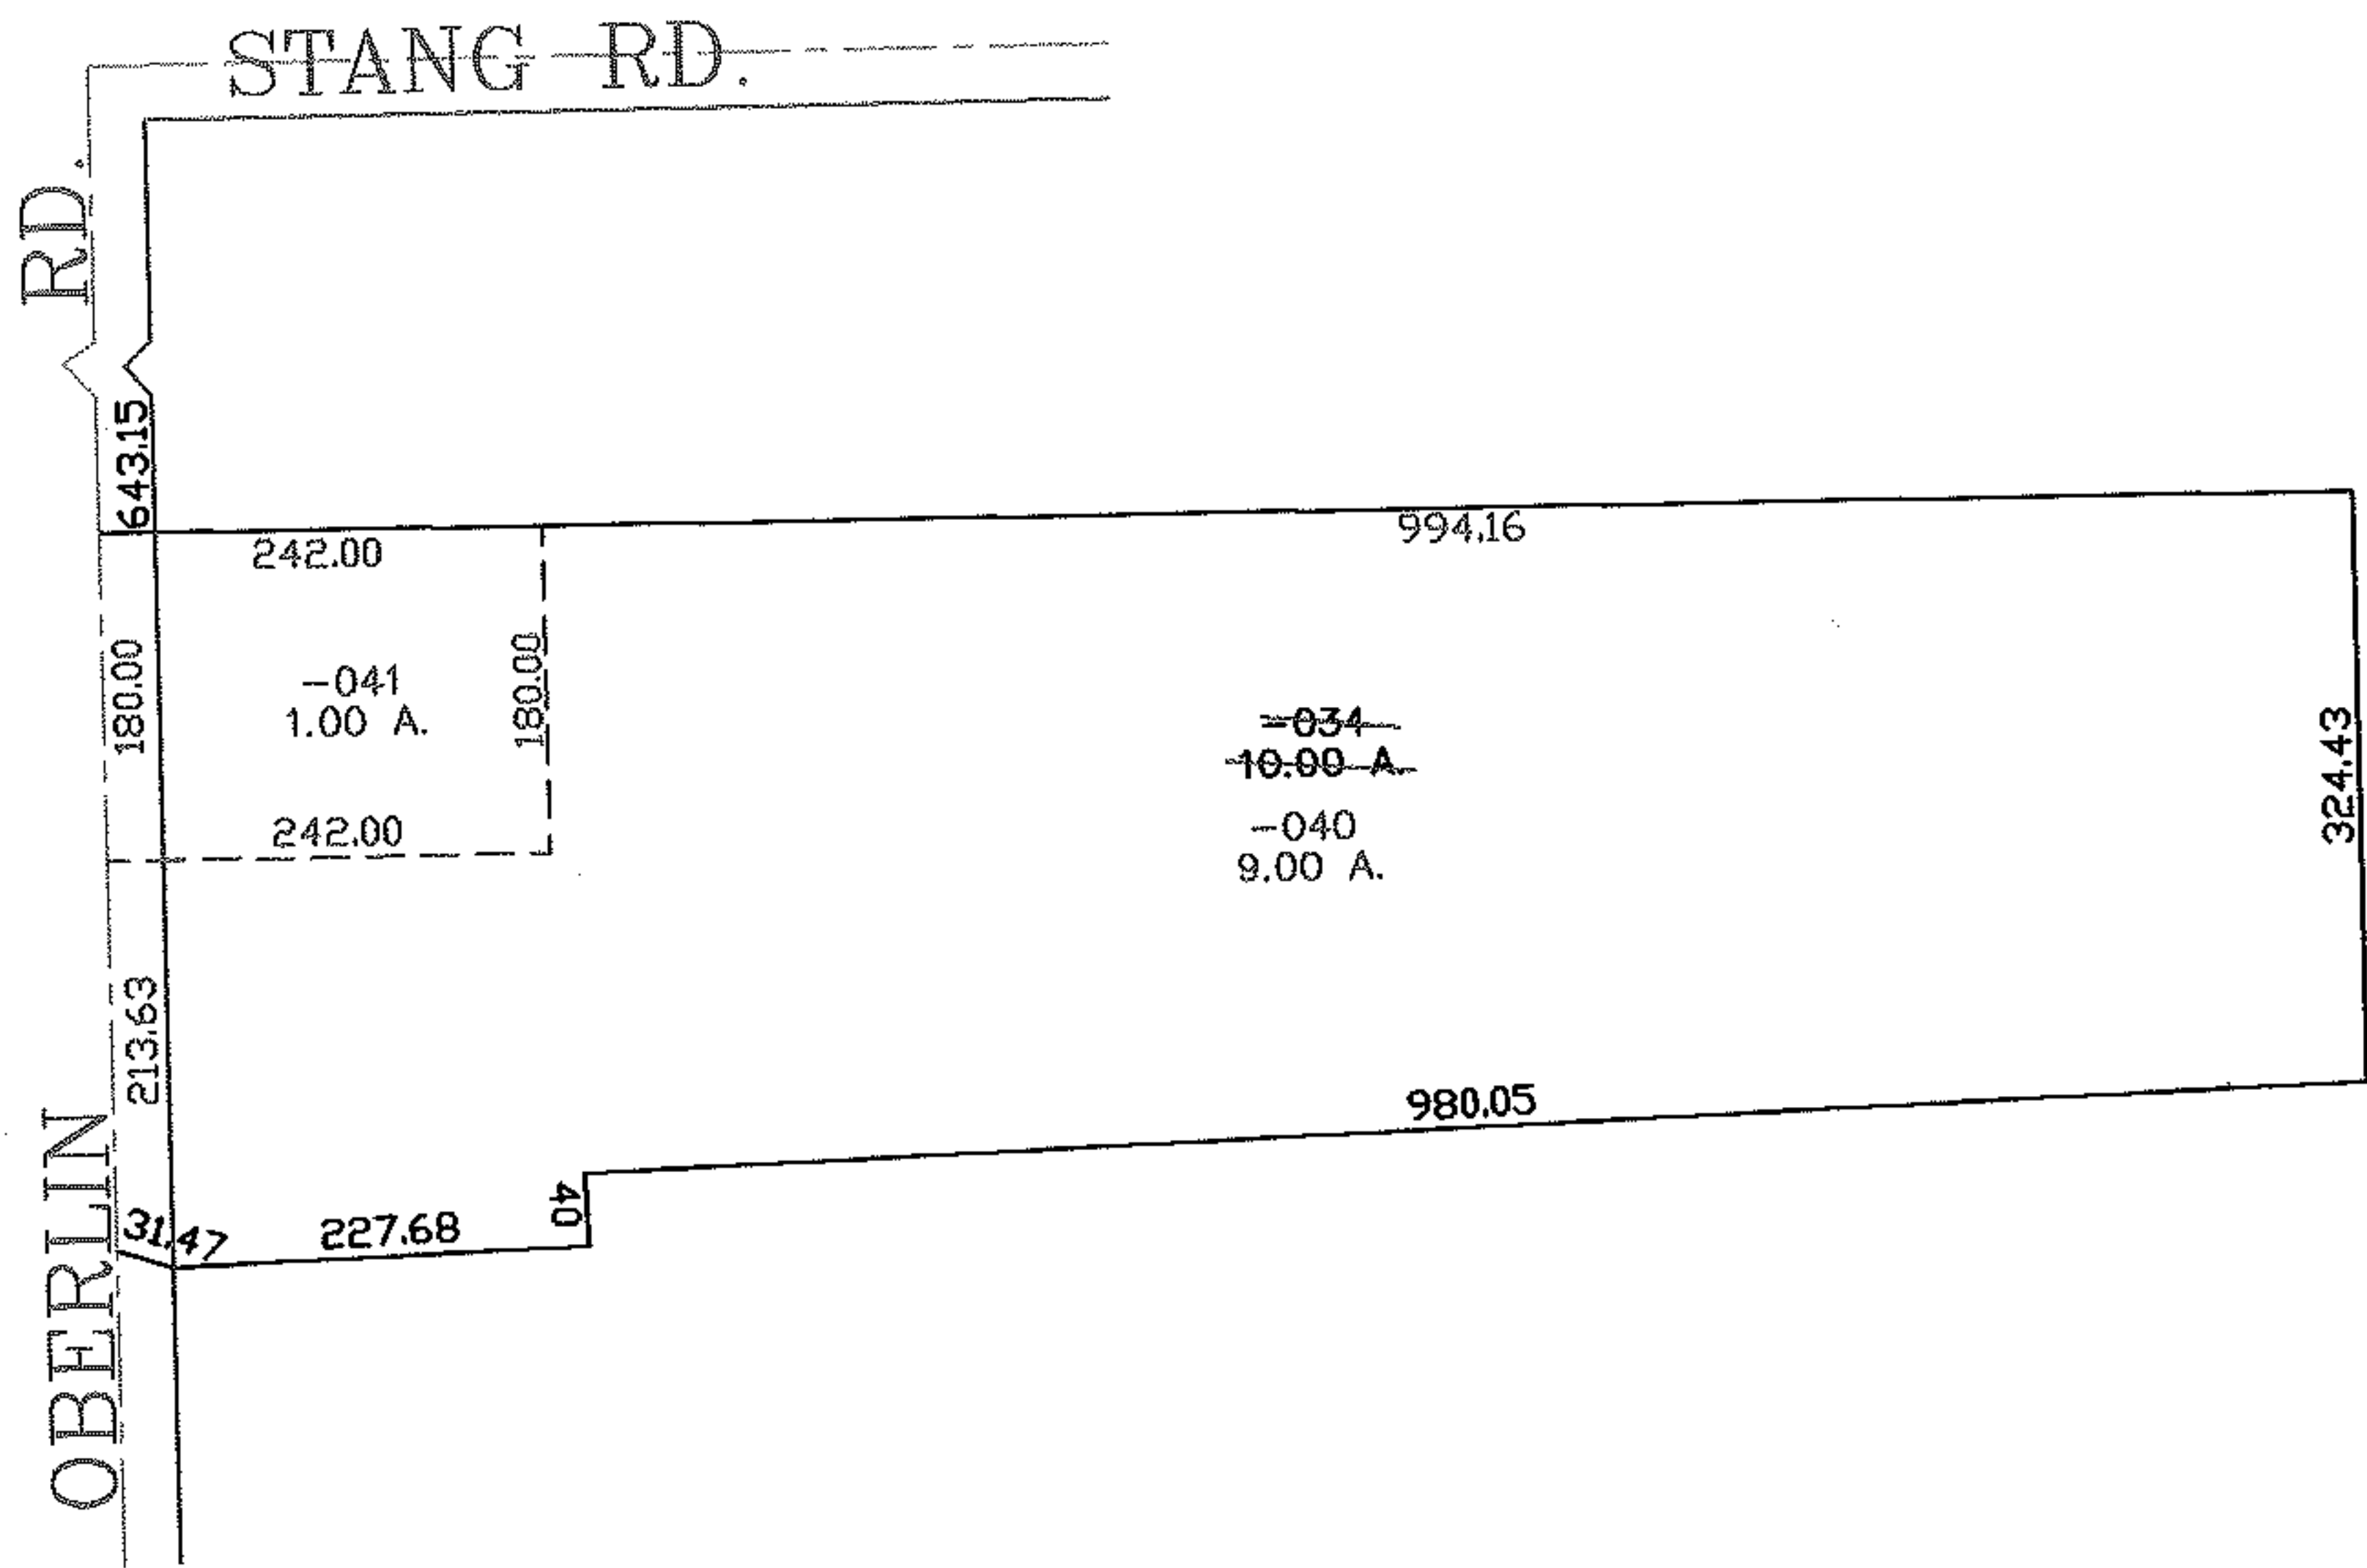


RASTER

PARENT PARCEL: 05-00-065-000-034
CHILD PARCEL: 05-00-065-000-040, -041
STARTING POINT: CENTERLINE OF STANG RD. & OBERLIN RD.

NO. 01963

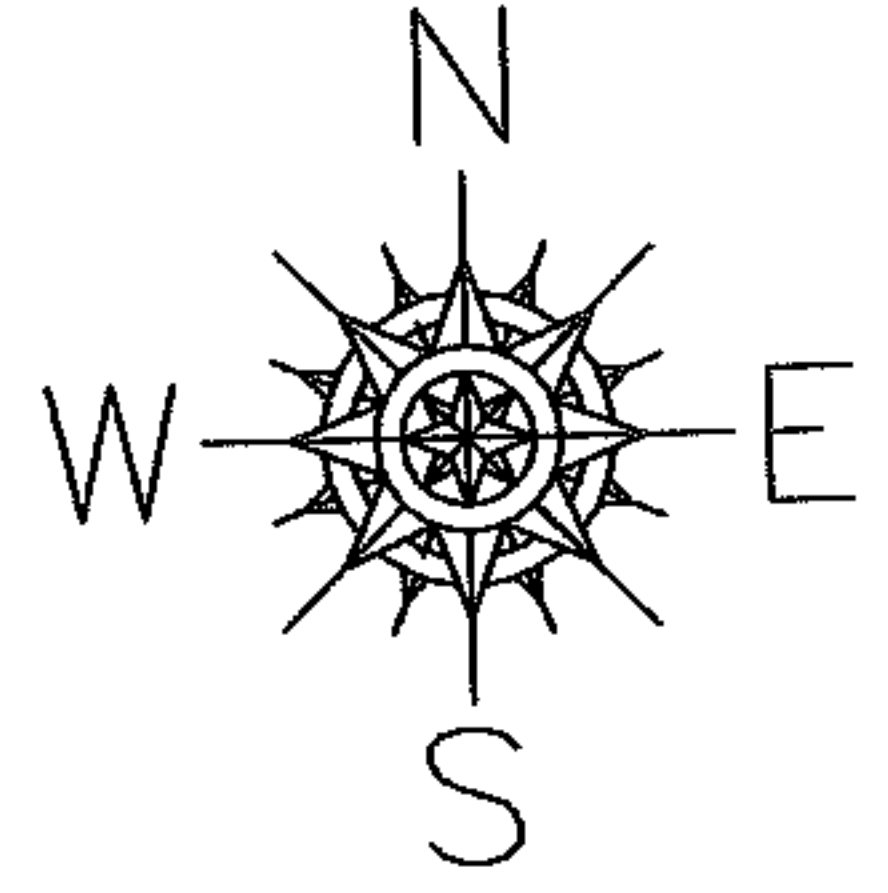

SPLITS/DEEDS PROCESSED
LORAIN COUNTY TAX MAP DEPARTMENT
226 MIDDLE AVE. ELYRIA, OHIO

SURVEYED BY: EHTESHAM SUHAIL
CLOSURE: 0.00 : 10.000
MAP PAGE(S): 05-00-065-A
APPROVED BY: JAH DATE: 8-1-05
SCALE: 1" = 200 PRIOR INSTRUMENT: 199800579785