


RASTER

NO. 01966


PARENT PARCEL: 15-00-030-000-021

CHILD PARCEL: 15-00-030-000-032, -033

STARTING POINT: CENTERLINE OF INDIAN HOLLOW RD. & BIGGS RD.

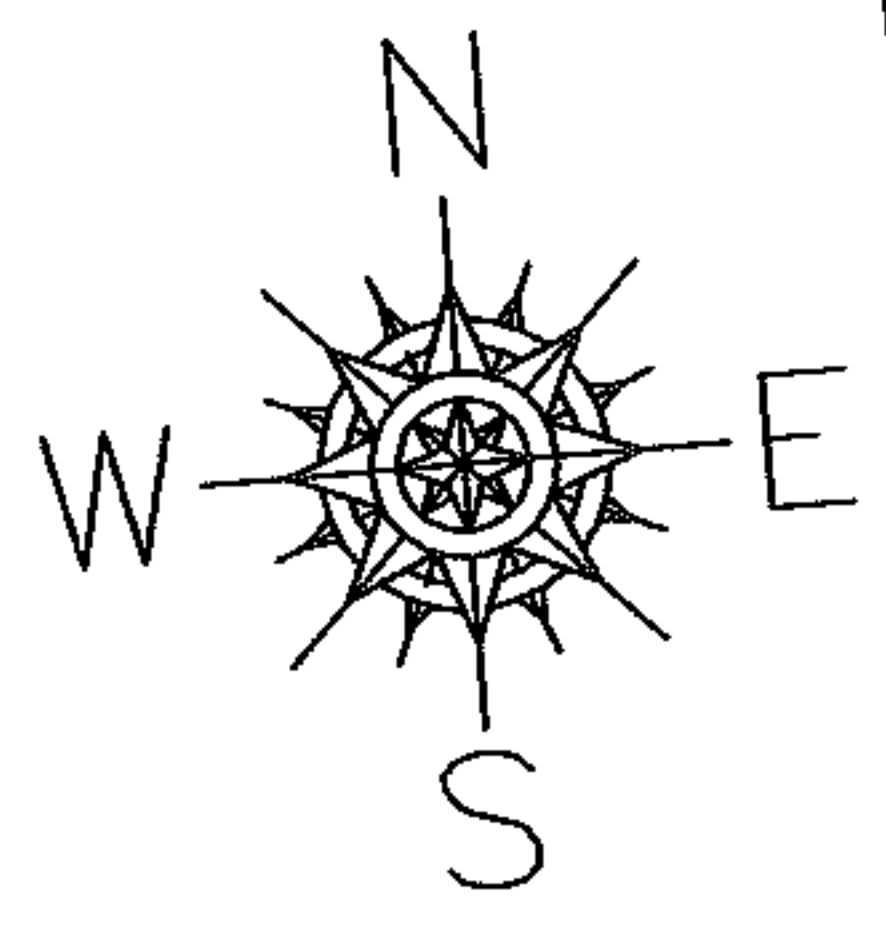

INDIAN HOLLOW RD.

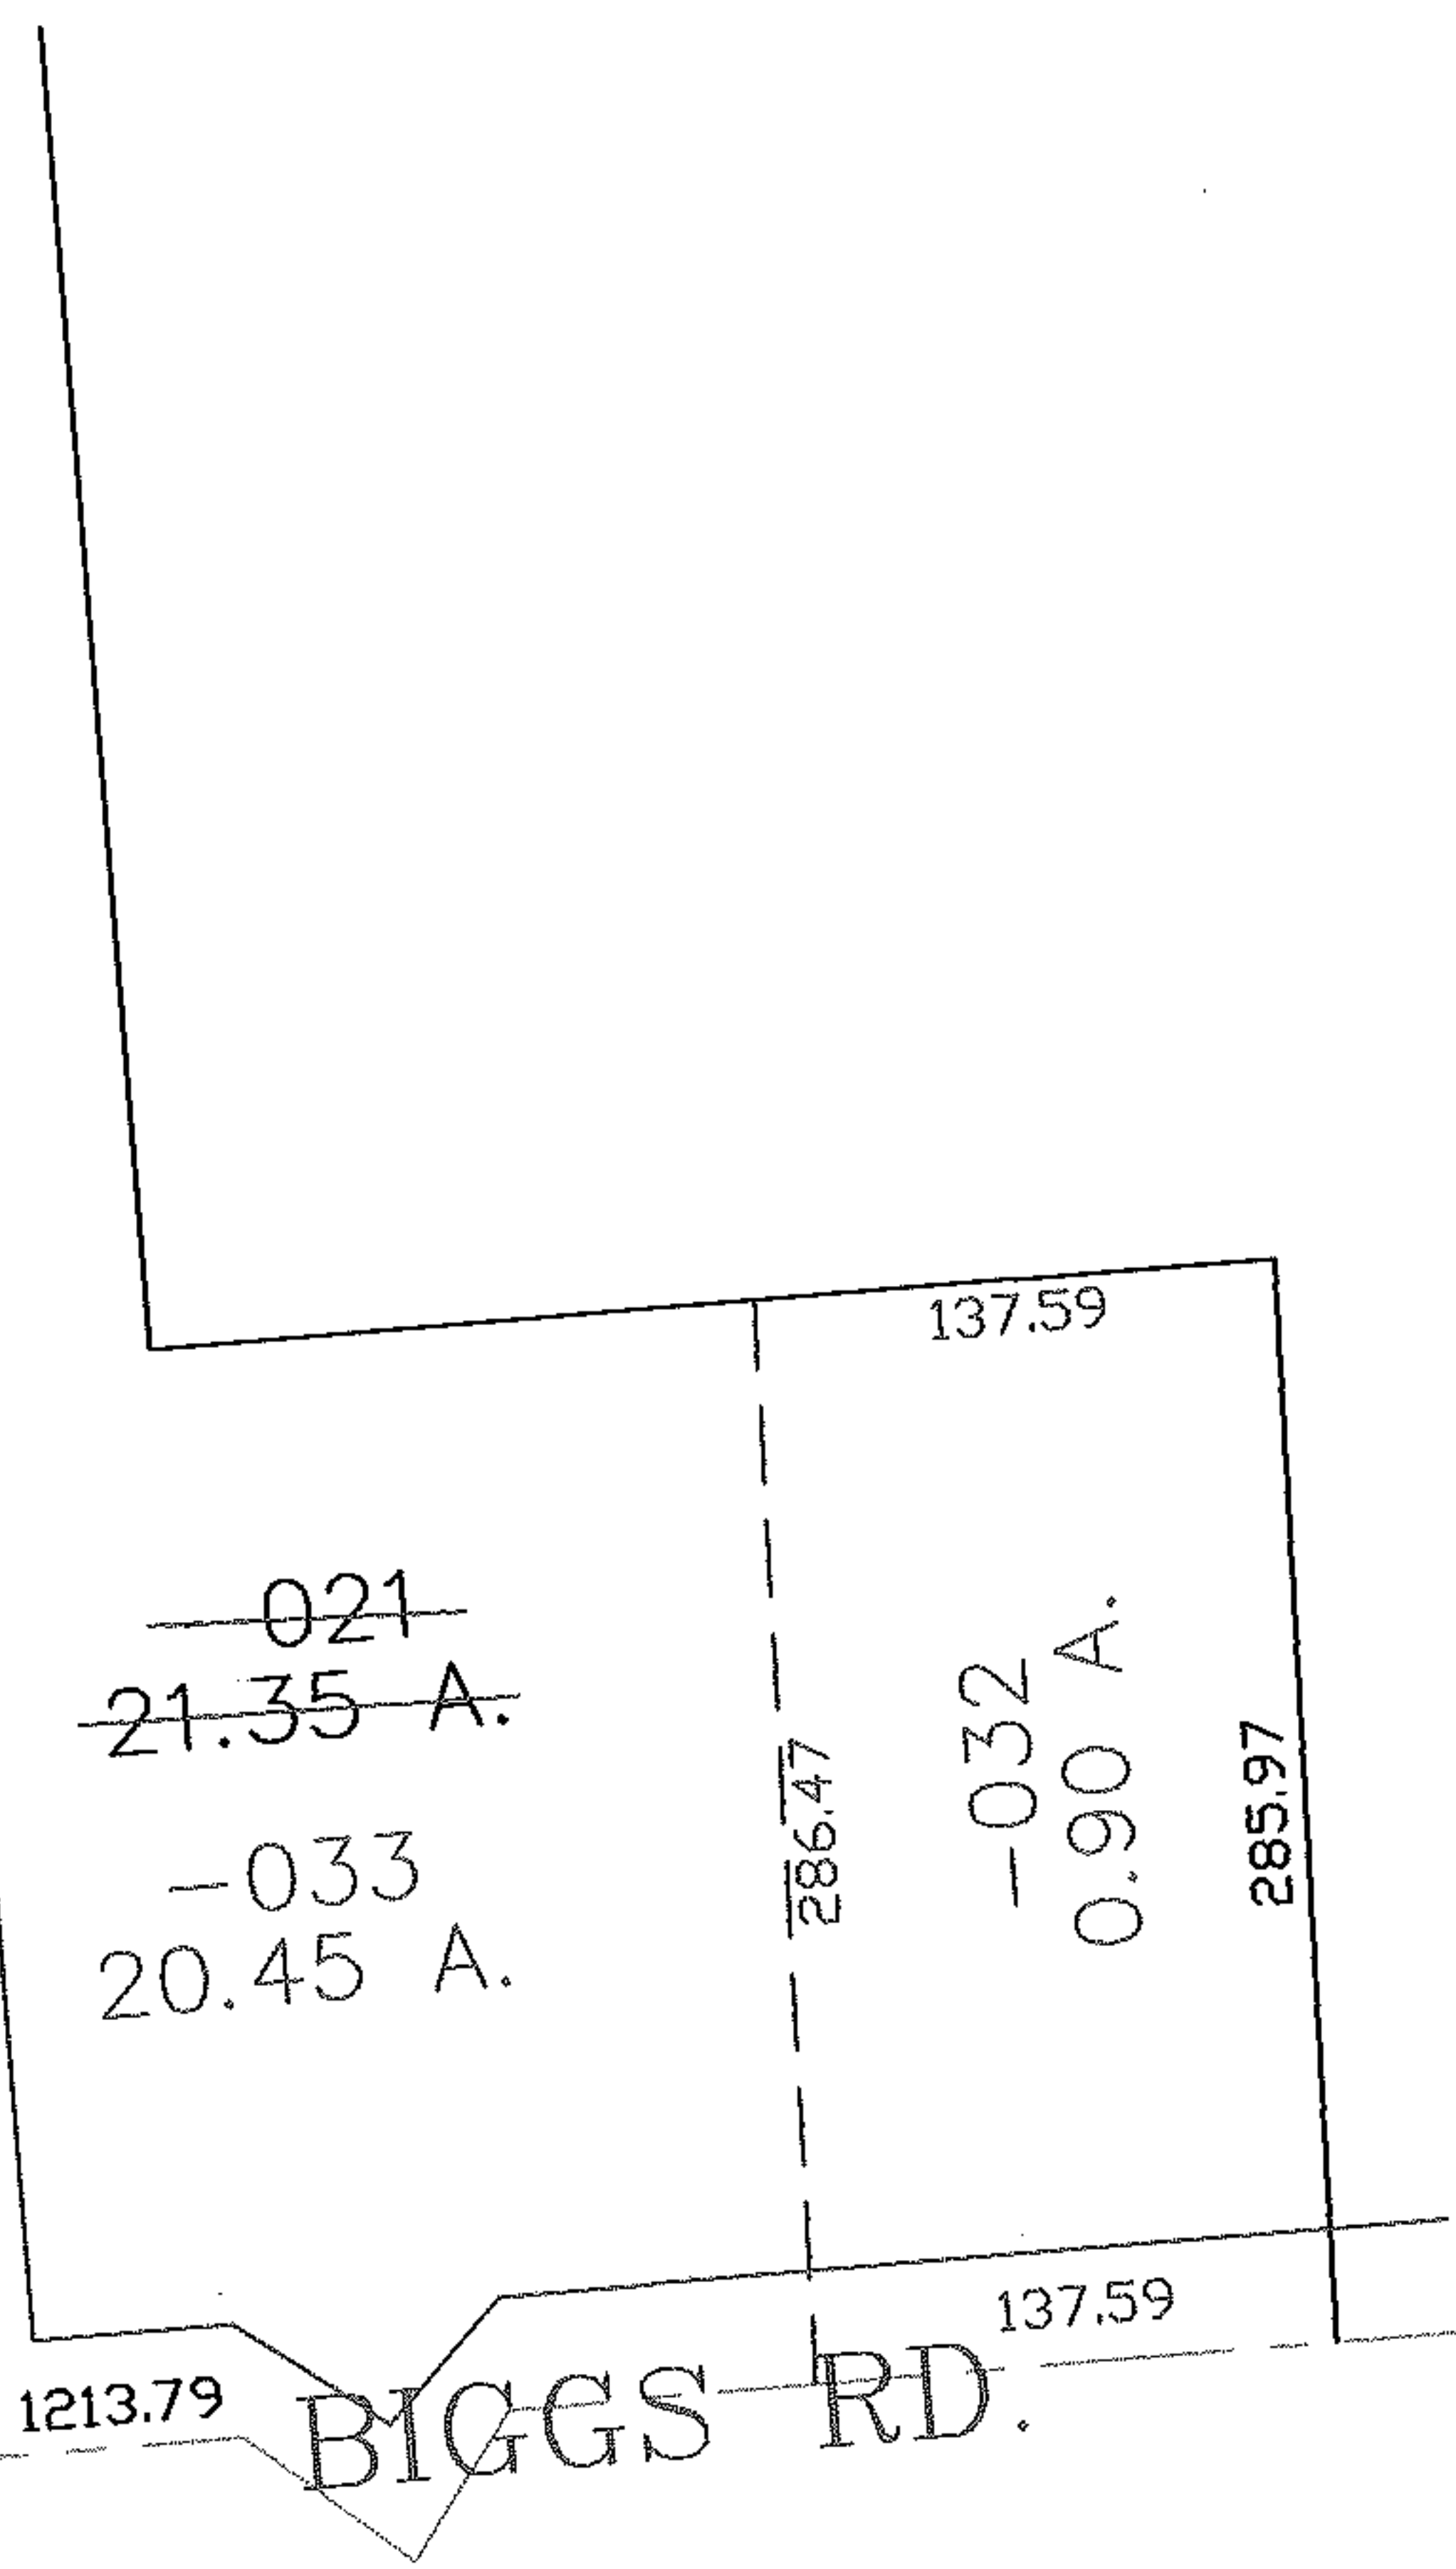

~~021~~  
21.35 A.

~~033~~  
20.45 A.

137.59

286.47

~~032~~  
0.90 A.

285.97

137.59

1213.79

BIGGS RD.

SPLITS/DEEDS PROCESSED

LRAIN COUNTY TAX MAP DEPARTMENT  
226 MIDDLE AVE. ELYRIA, OHIO

SURVEYED BY: RICHARD CARLSON  
CLOSURE: 0.00 : 10.000  
MAP PAGE(S): 15-00-030-A  
APPROVED BY: JAH DATE: 7-28-05  
SCALE: 1" = 100 PRIOR INSTRUMENT: 980578202