


PARENT PARCEL: 05-00-027-000-007

CHILD PARCEL: _____

10-01969-C

STARTING POINT: SOUTHWEST CORNER OF O.L.27

OHIO TURNPIKE

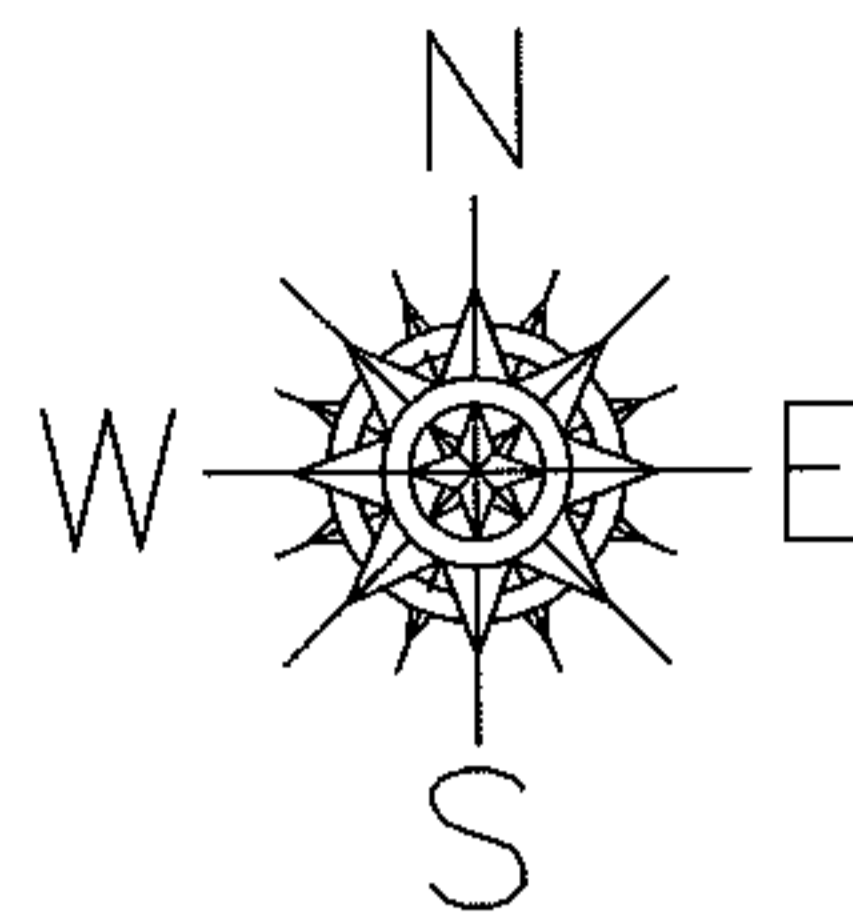

L=383.71
R=11674.16

1974.80

-007

~~16.73 A.~~

17.30 A. AC.CORR.PER.SURV.

P.ROSEBECK

2046.91

O.L.13 O.L.14

O.L.28 O.L.27

518.69

375.11

SPLITS/DEEDS PROCESSED

LORAIN COUNTY TAX MAP DEPARTMENT
226 MIDDLE AVE. ELYRIA, OHIO

SURVEYED BY: PHILLIP A. ROSEBECK

CLOSURE: .01:10,000

MAP PAGE(S): 5-F

APPROVED BY: RRM DATE: 2-16-10

SCALE: 1"= 300 PRIOR INST.: 20080247277