


PARENT PARCEL: 07-00-027-101-031

CHILD PARCEL: XX-XX-XXX-XXX-XXX

10-01974-A

STARTING POINT: INTERSECTION OF C/L OF S.R.83 AND NORTH LINE OF O.L.27

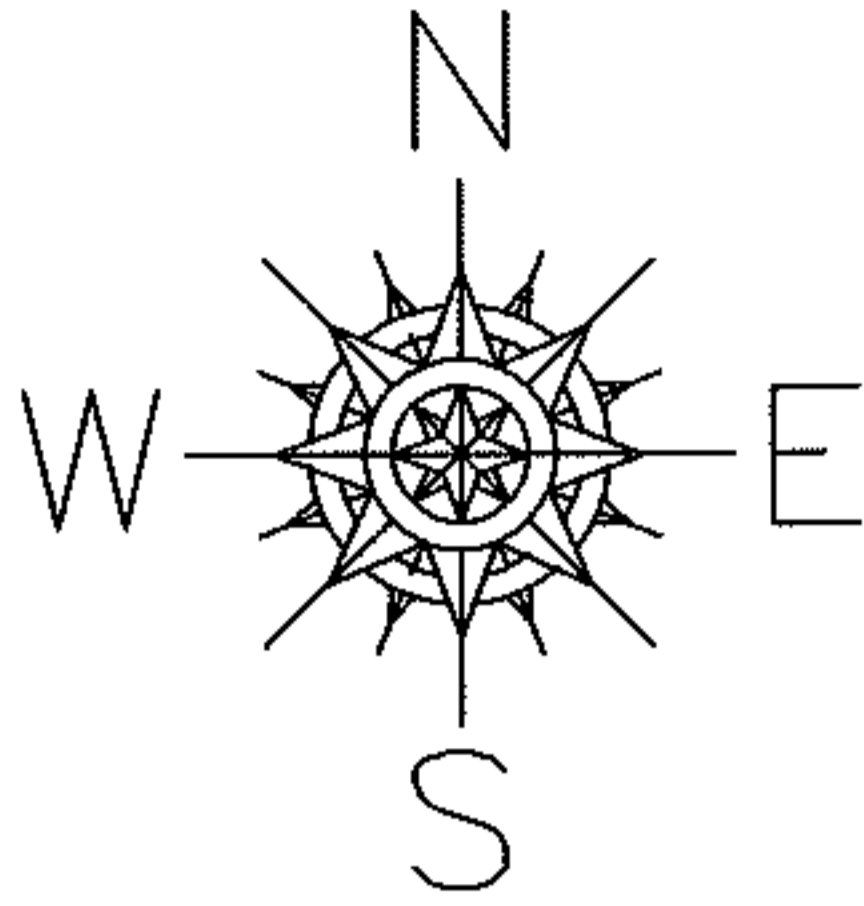

O.L.28

O.L.27

RD.

(S.R. 83)

1499.14

WOOSTER-AVON LAKE

110.09

185.08

2050.63

-031

~~7.13 A.~~
7.31 A.

1500.47

75.00


550.00

AC.CORR.PER.DEEDS

*19980510902

19960413824

19940308829

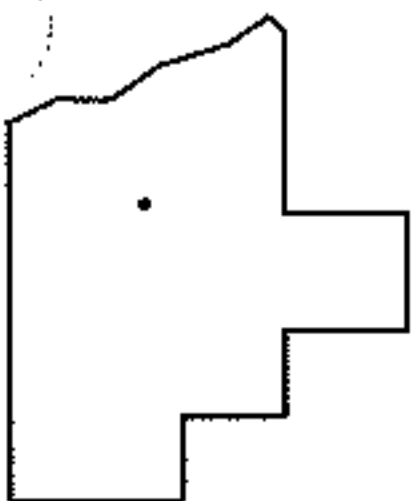

SPLITS/DEEDS PROCESSED

LORAIN COUNTY TAX MAP DEPARTMENT
226 MIDDLE AVE. ELYRIA, OHIO

SURVEYED BY: N/A

CLOSURE: N/A

MAP PAGE(S): 7-00-027-B

APPROVED BY: RRM DATE: 2-19-10

SCALE: 1" = 300 PRIOR INST.: SEE ABOVE *