




RASTER

PARENT PARCEL: 15-00-019-000-012

CHILD PARCEL: 15-00-019-000-013 THRU -016

STARTING POINT: CENTERLINE OF NICKEL PLATE DIAGONAL RD. & O.L. 19

NO. 01974

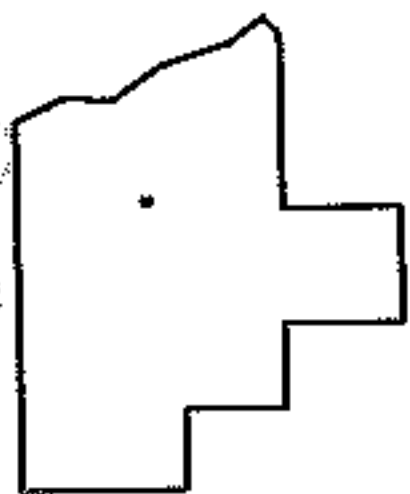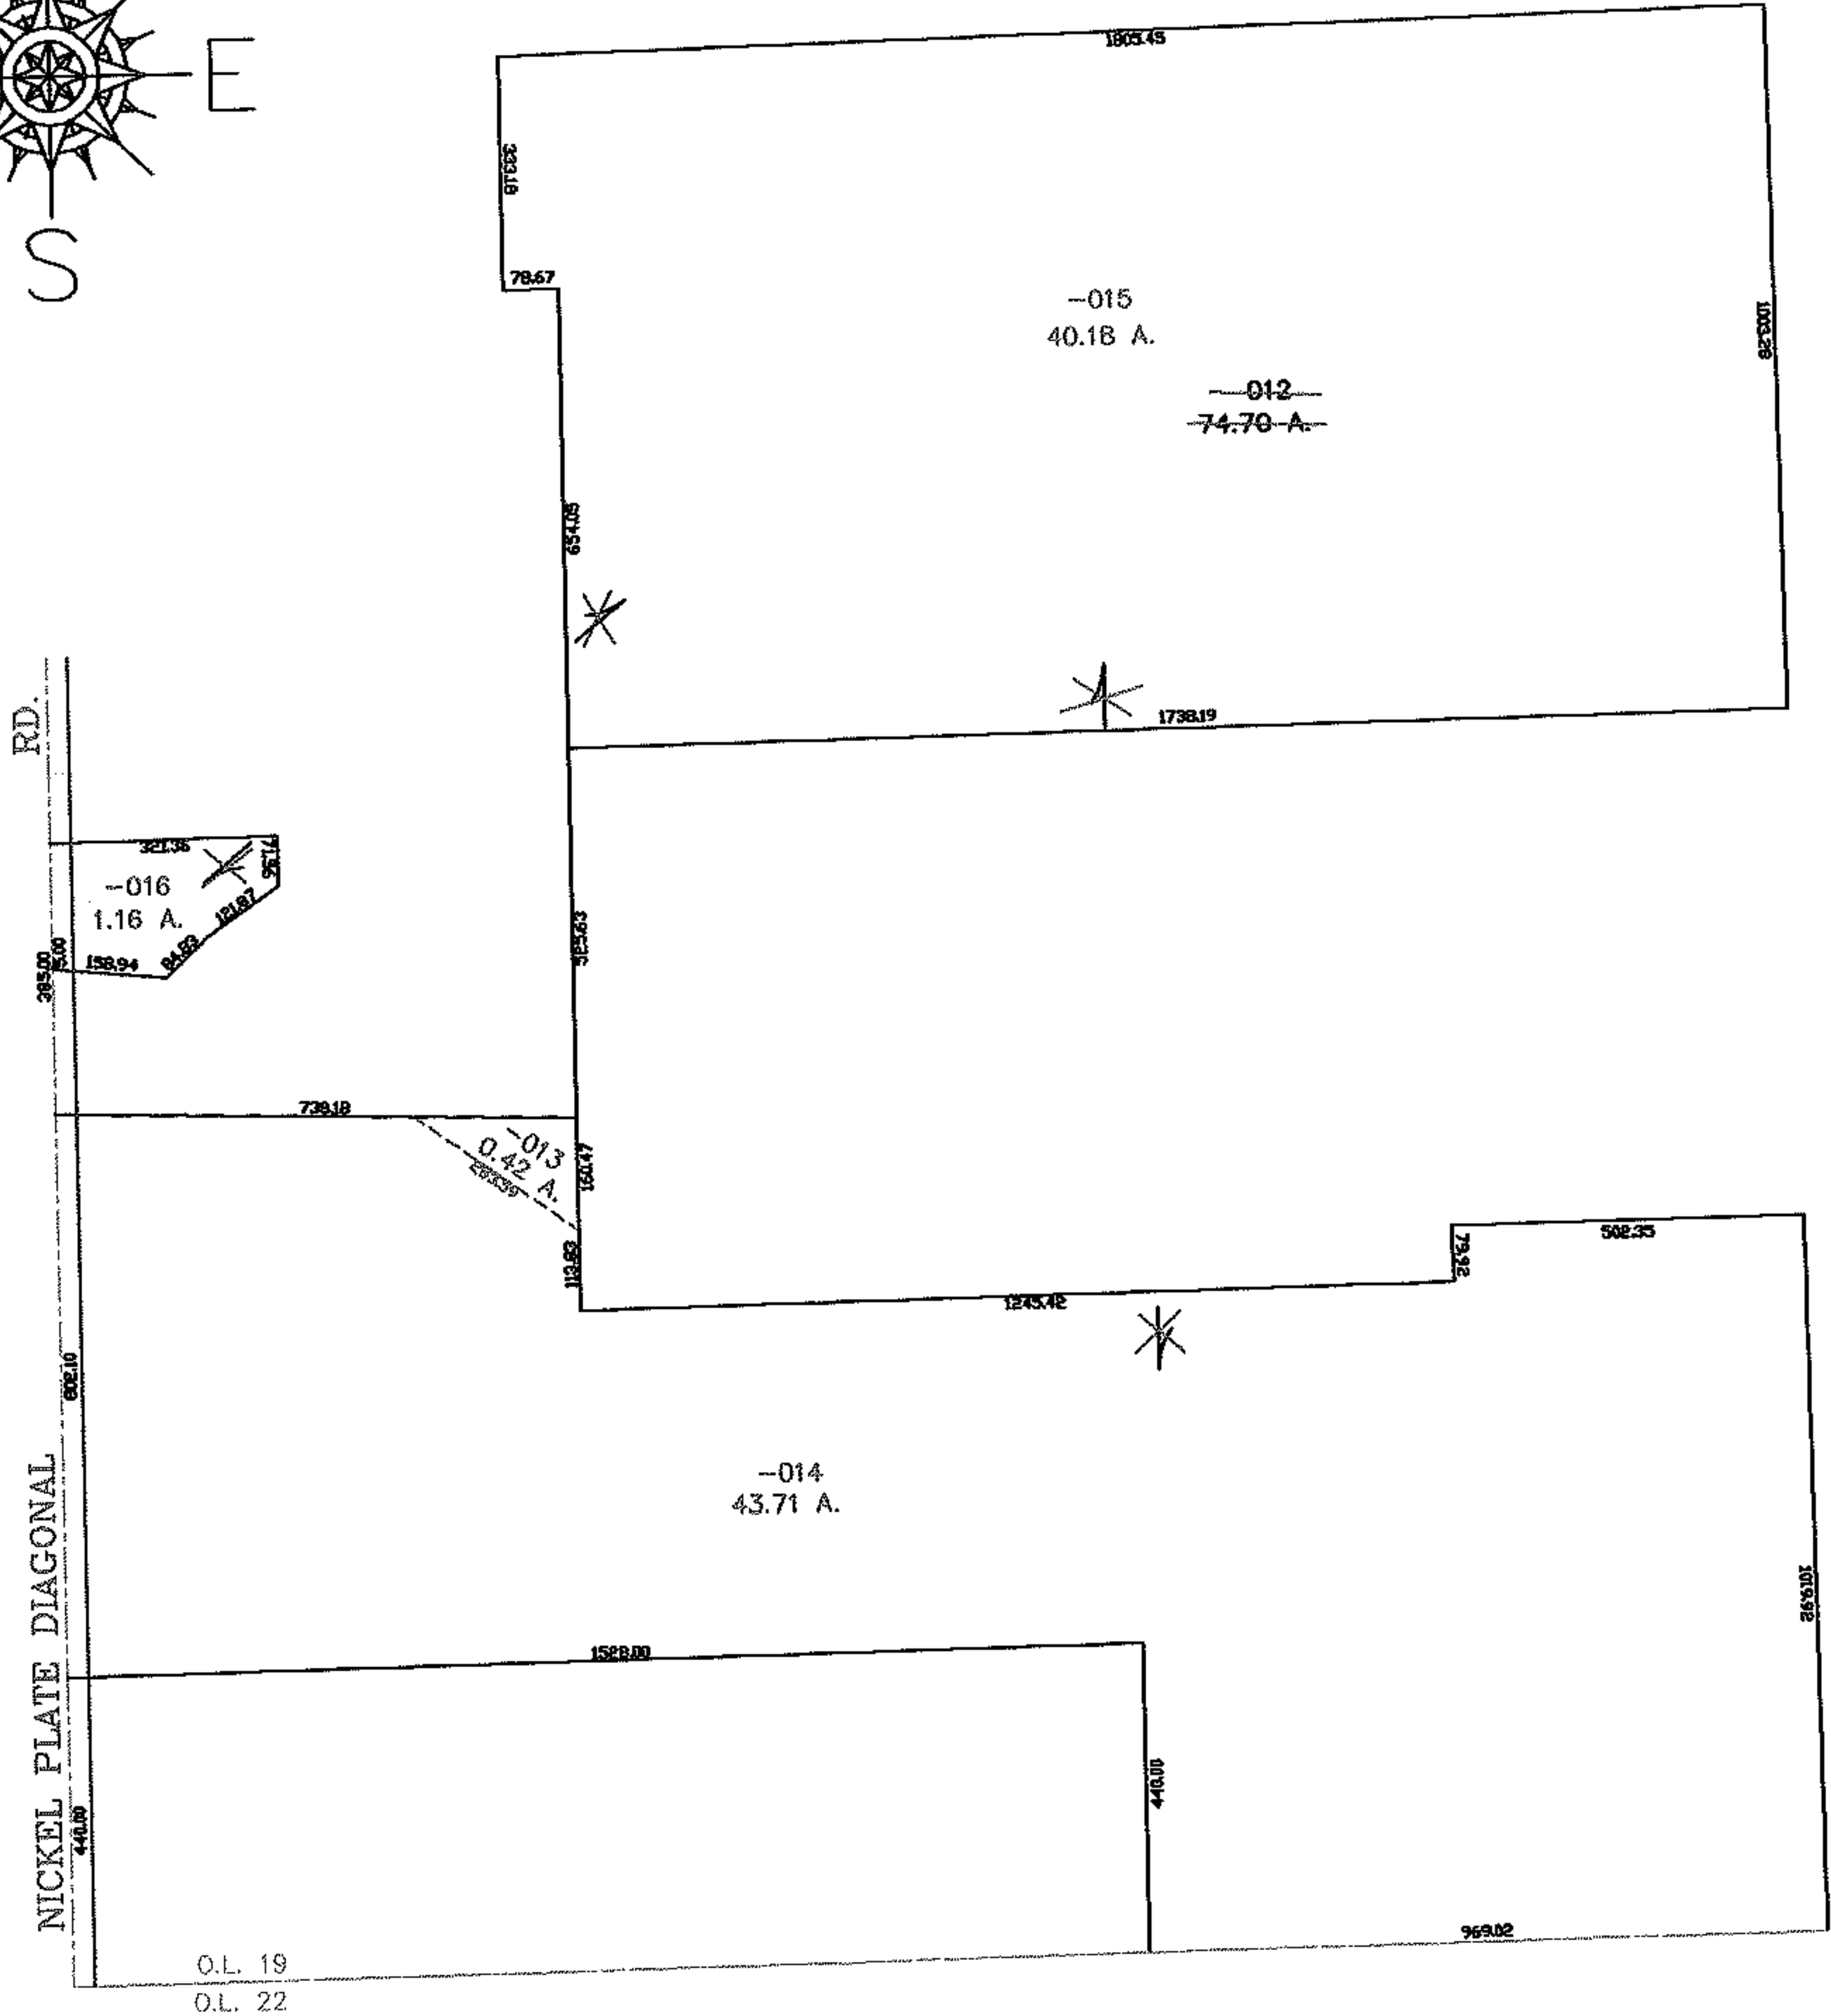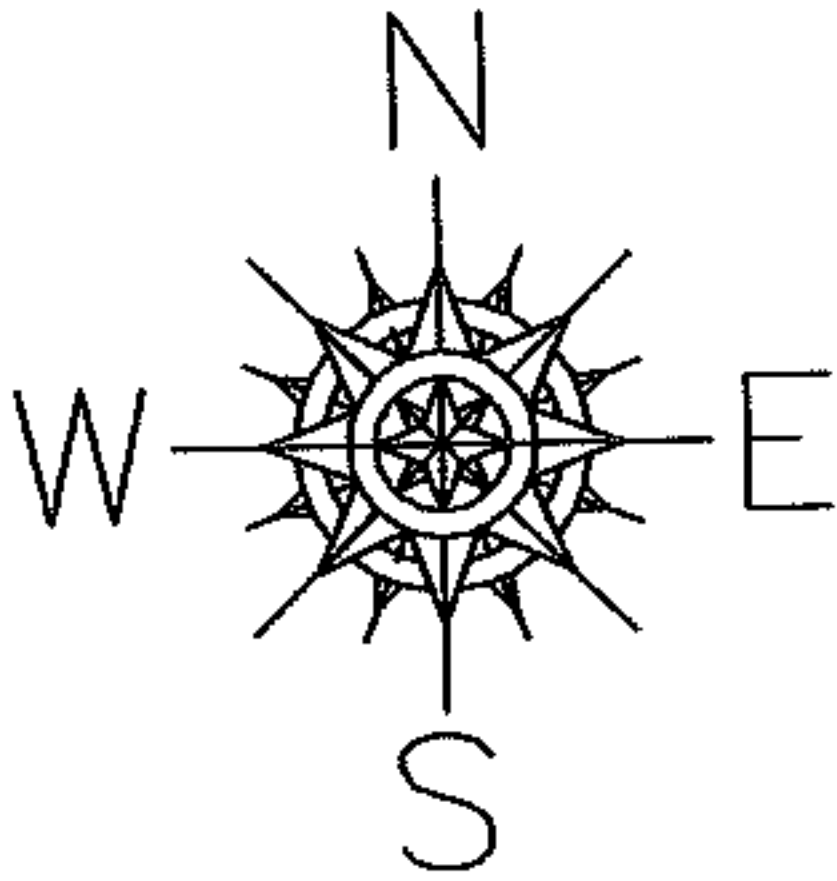

SPLITS/DEEDS PROCESSED
LORAIN COUNTY TAX MAP DEPARTMENT
 226 MIDDLE AVE. ELYRIA, OHIO

SURVEYED BY: PHILLIP A. ROSEBECK
 CLOSURE: 0.00 : 10.000
 MAP PAGE(S): 15-A
 APPROVED BY: JAH DATE: 8-9-05
 SCALE: 1" = 400 PRIOR INSTRUMENT: 20030914013