

PARENT PARCEL: 03-00-014-000-047

CHILD PARCEL: XX-XX-XXX-XXX-XXX

STARTING POINT: CL OF BENNETT RD. & S.LINE OF OLD AVON BEACH & SOUTHERN R.R.

10-01975-D

# ACREAGE CORRECTION

03-00-014-000-047

~~1.42 A.~~

1.45 A.




CORR. PER DEED

DV 956/544

UPDATE BEFORE NEXT TRANSFER

NEED TO ADD EXCEPTIONS FOR

03-00-014-000-026 & -027

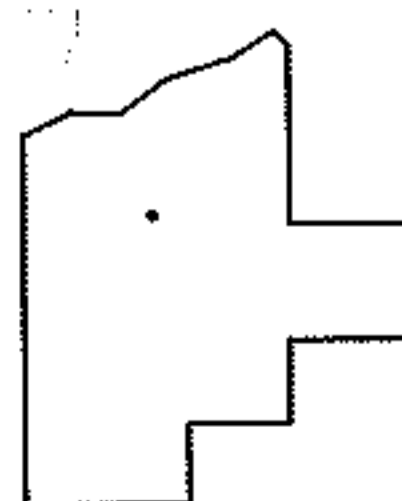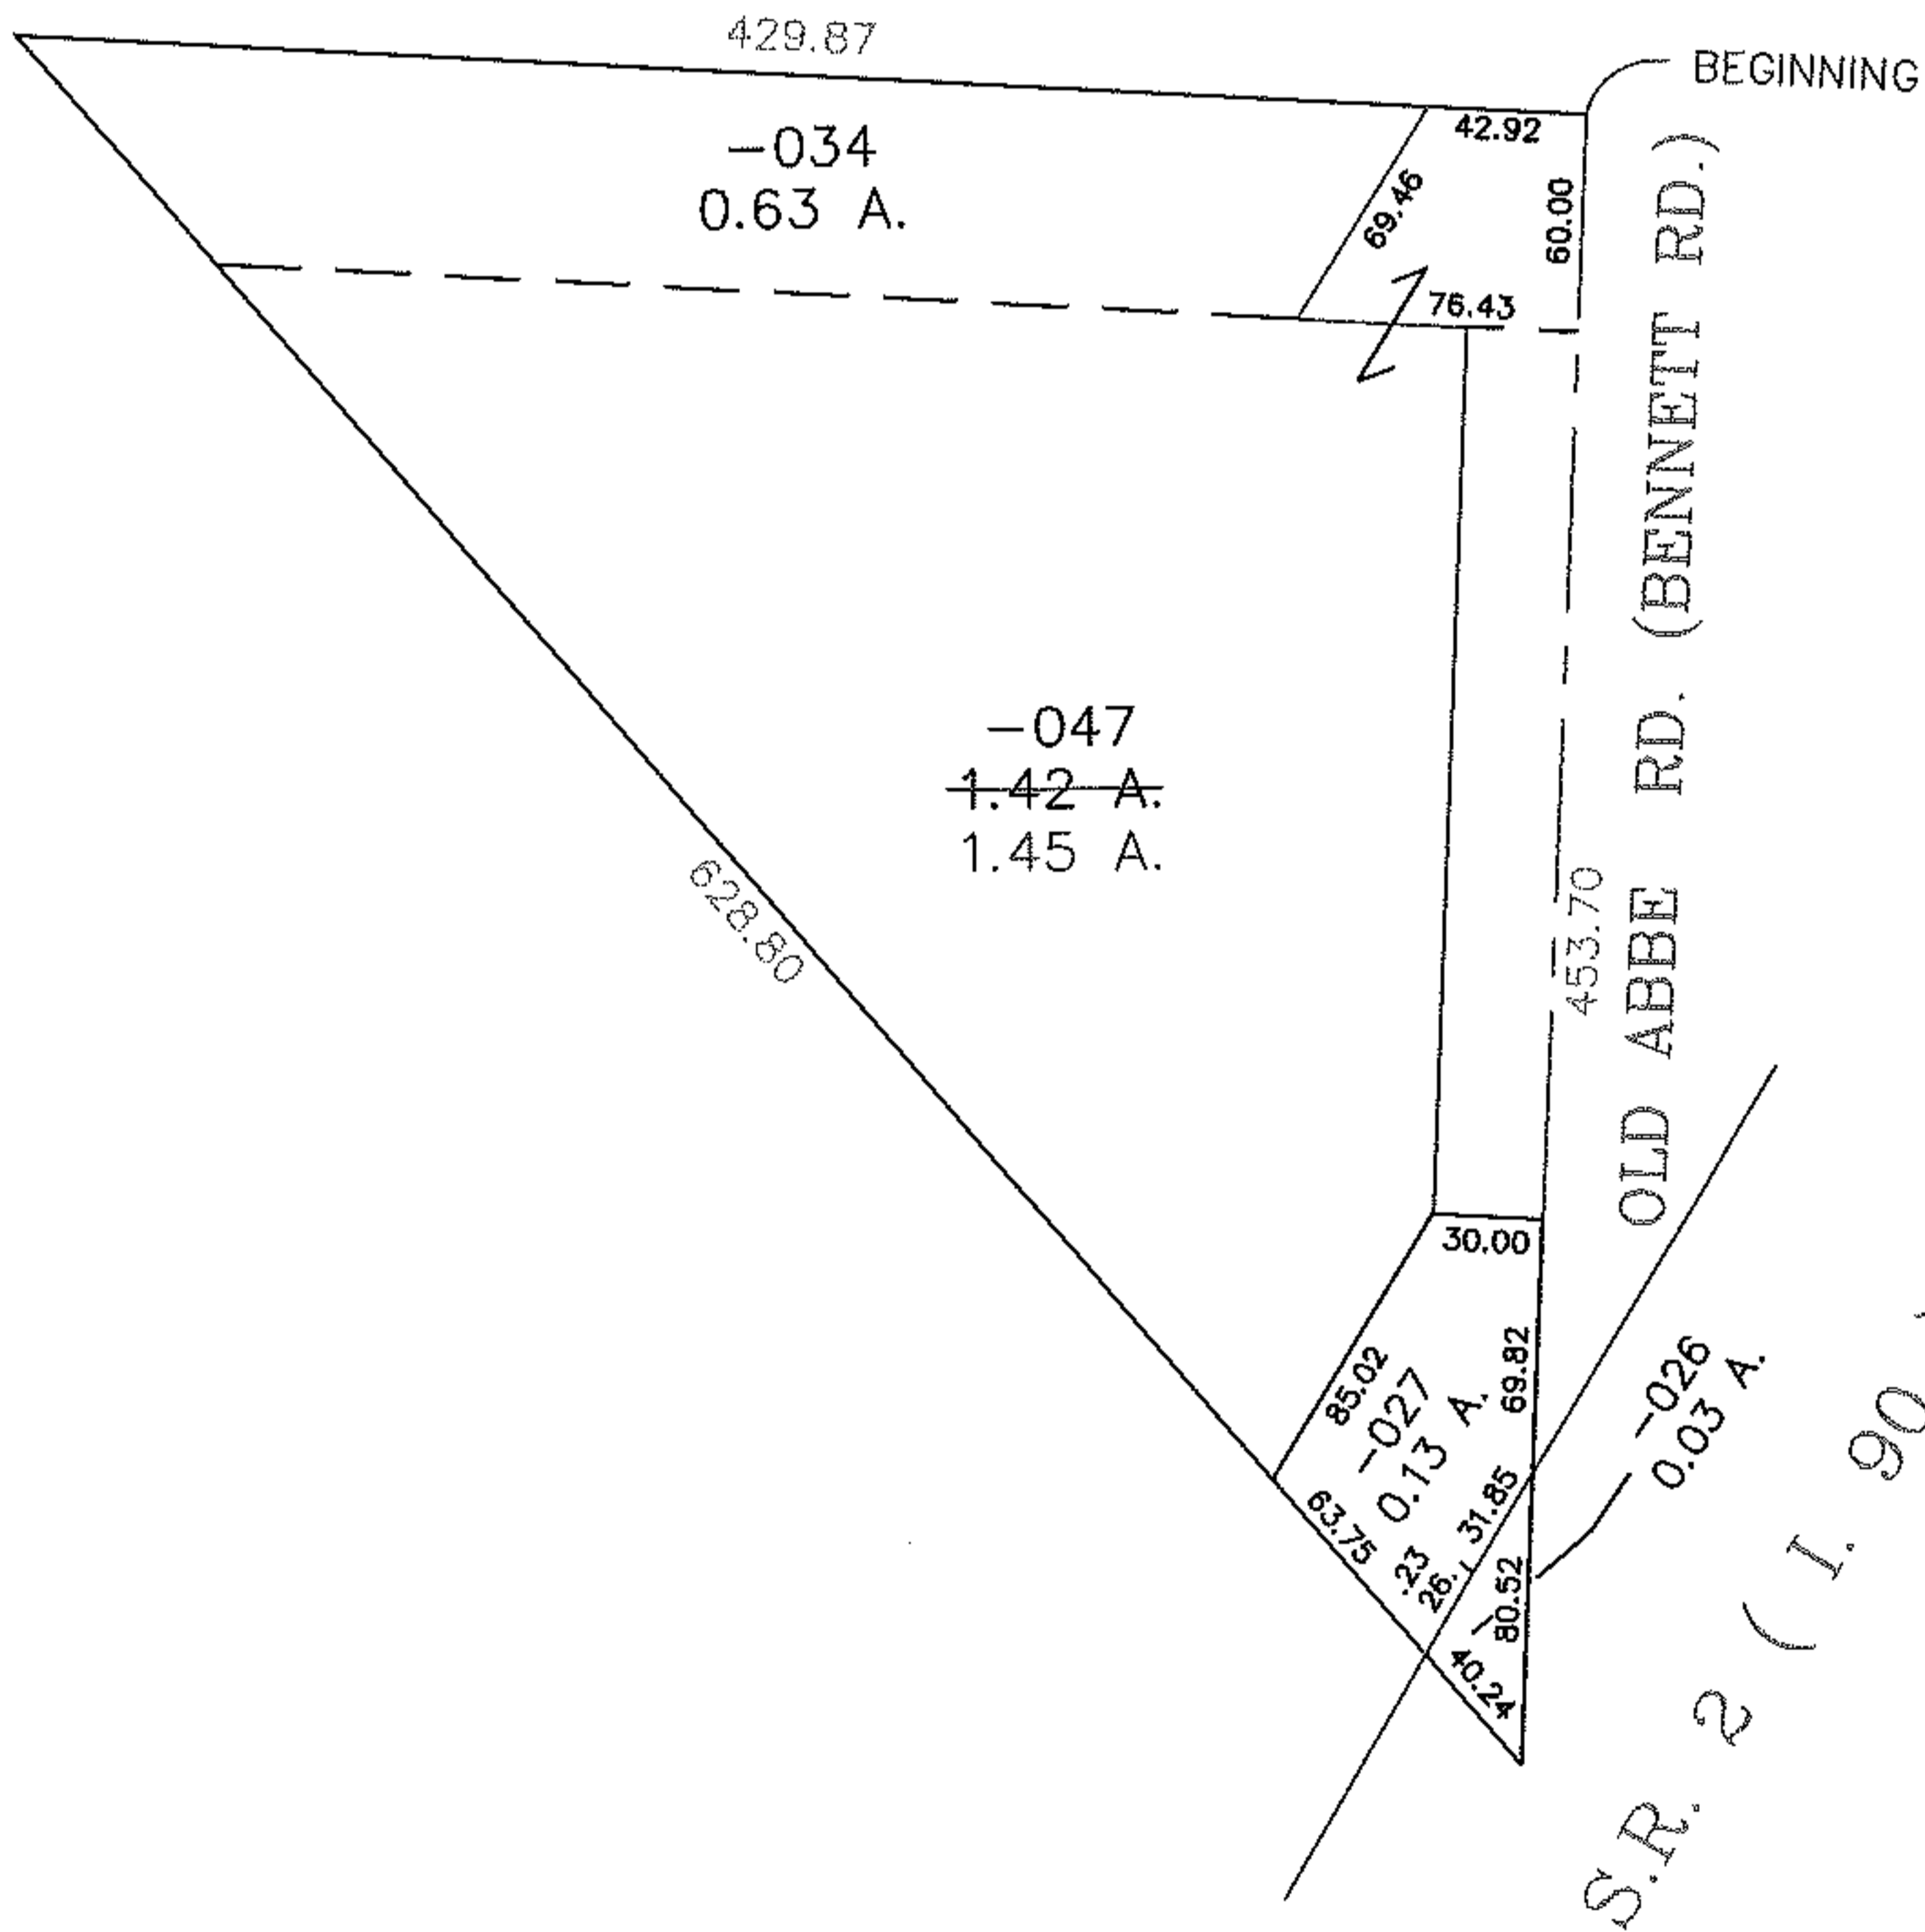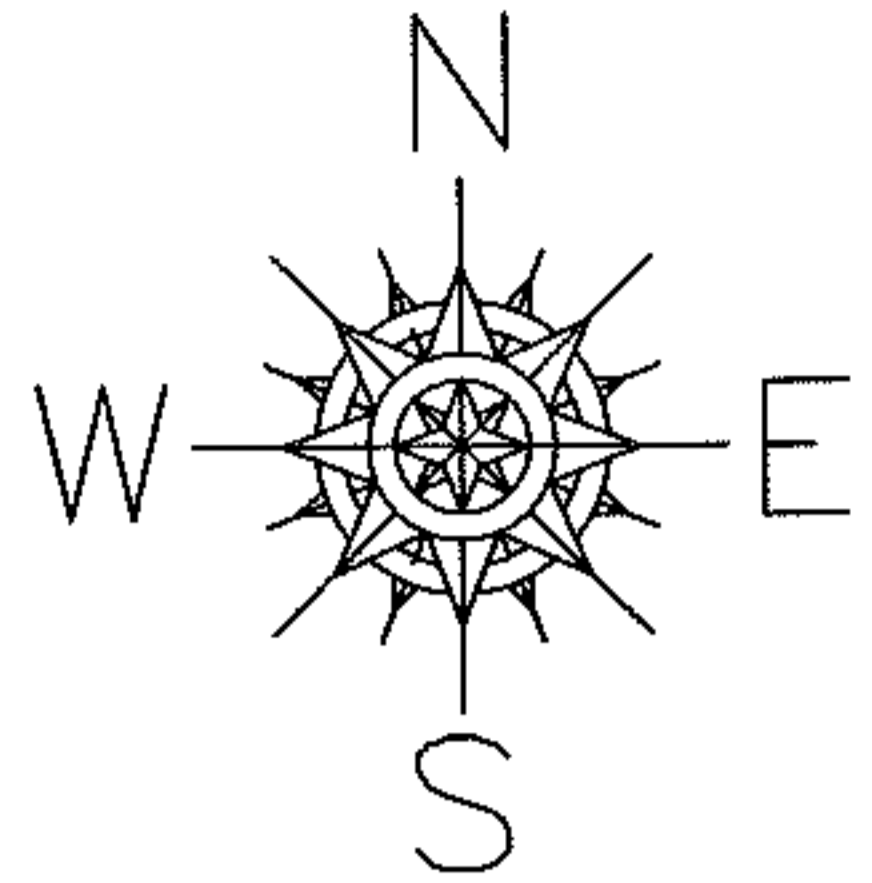

**SPLITS/DEEDS PROCESSED**  
**LORAIN COUNTY TAX MAP DEPARTMENT**  
 226 MIDDLE AVE. ELYRIA, OHIO

SURVEYED BY: XXXXXXXXXXXX  
 CLOSURE: 0.01 : 10.000  
 MAP PAGE(S): 3-00-014-B  
 APPROVED BY: TJS DATE: 2/24/10  
 SCALE: 1" = 100 PRIOR INSTRUMENT: DV 956/544