



RASTER

PARENT PARCEL: 05-00-020-000-114

CHILD PARCEL: 05-00-020-000-115 THRU -121 05-00-019-000-067, -068

STARTING POINT: CENTERLINE OF COOPER FOSTER PARK RD. & O.L. 20

NO. 01979

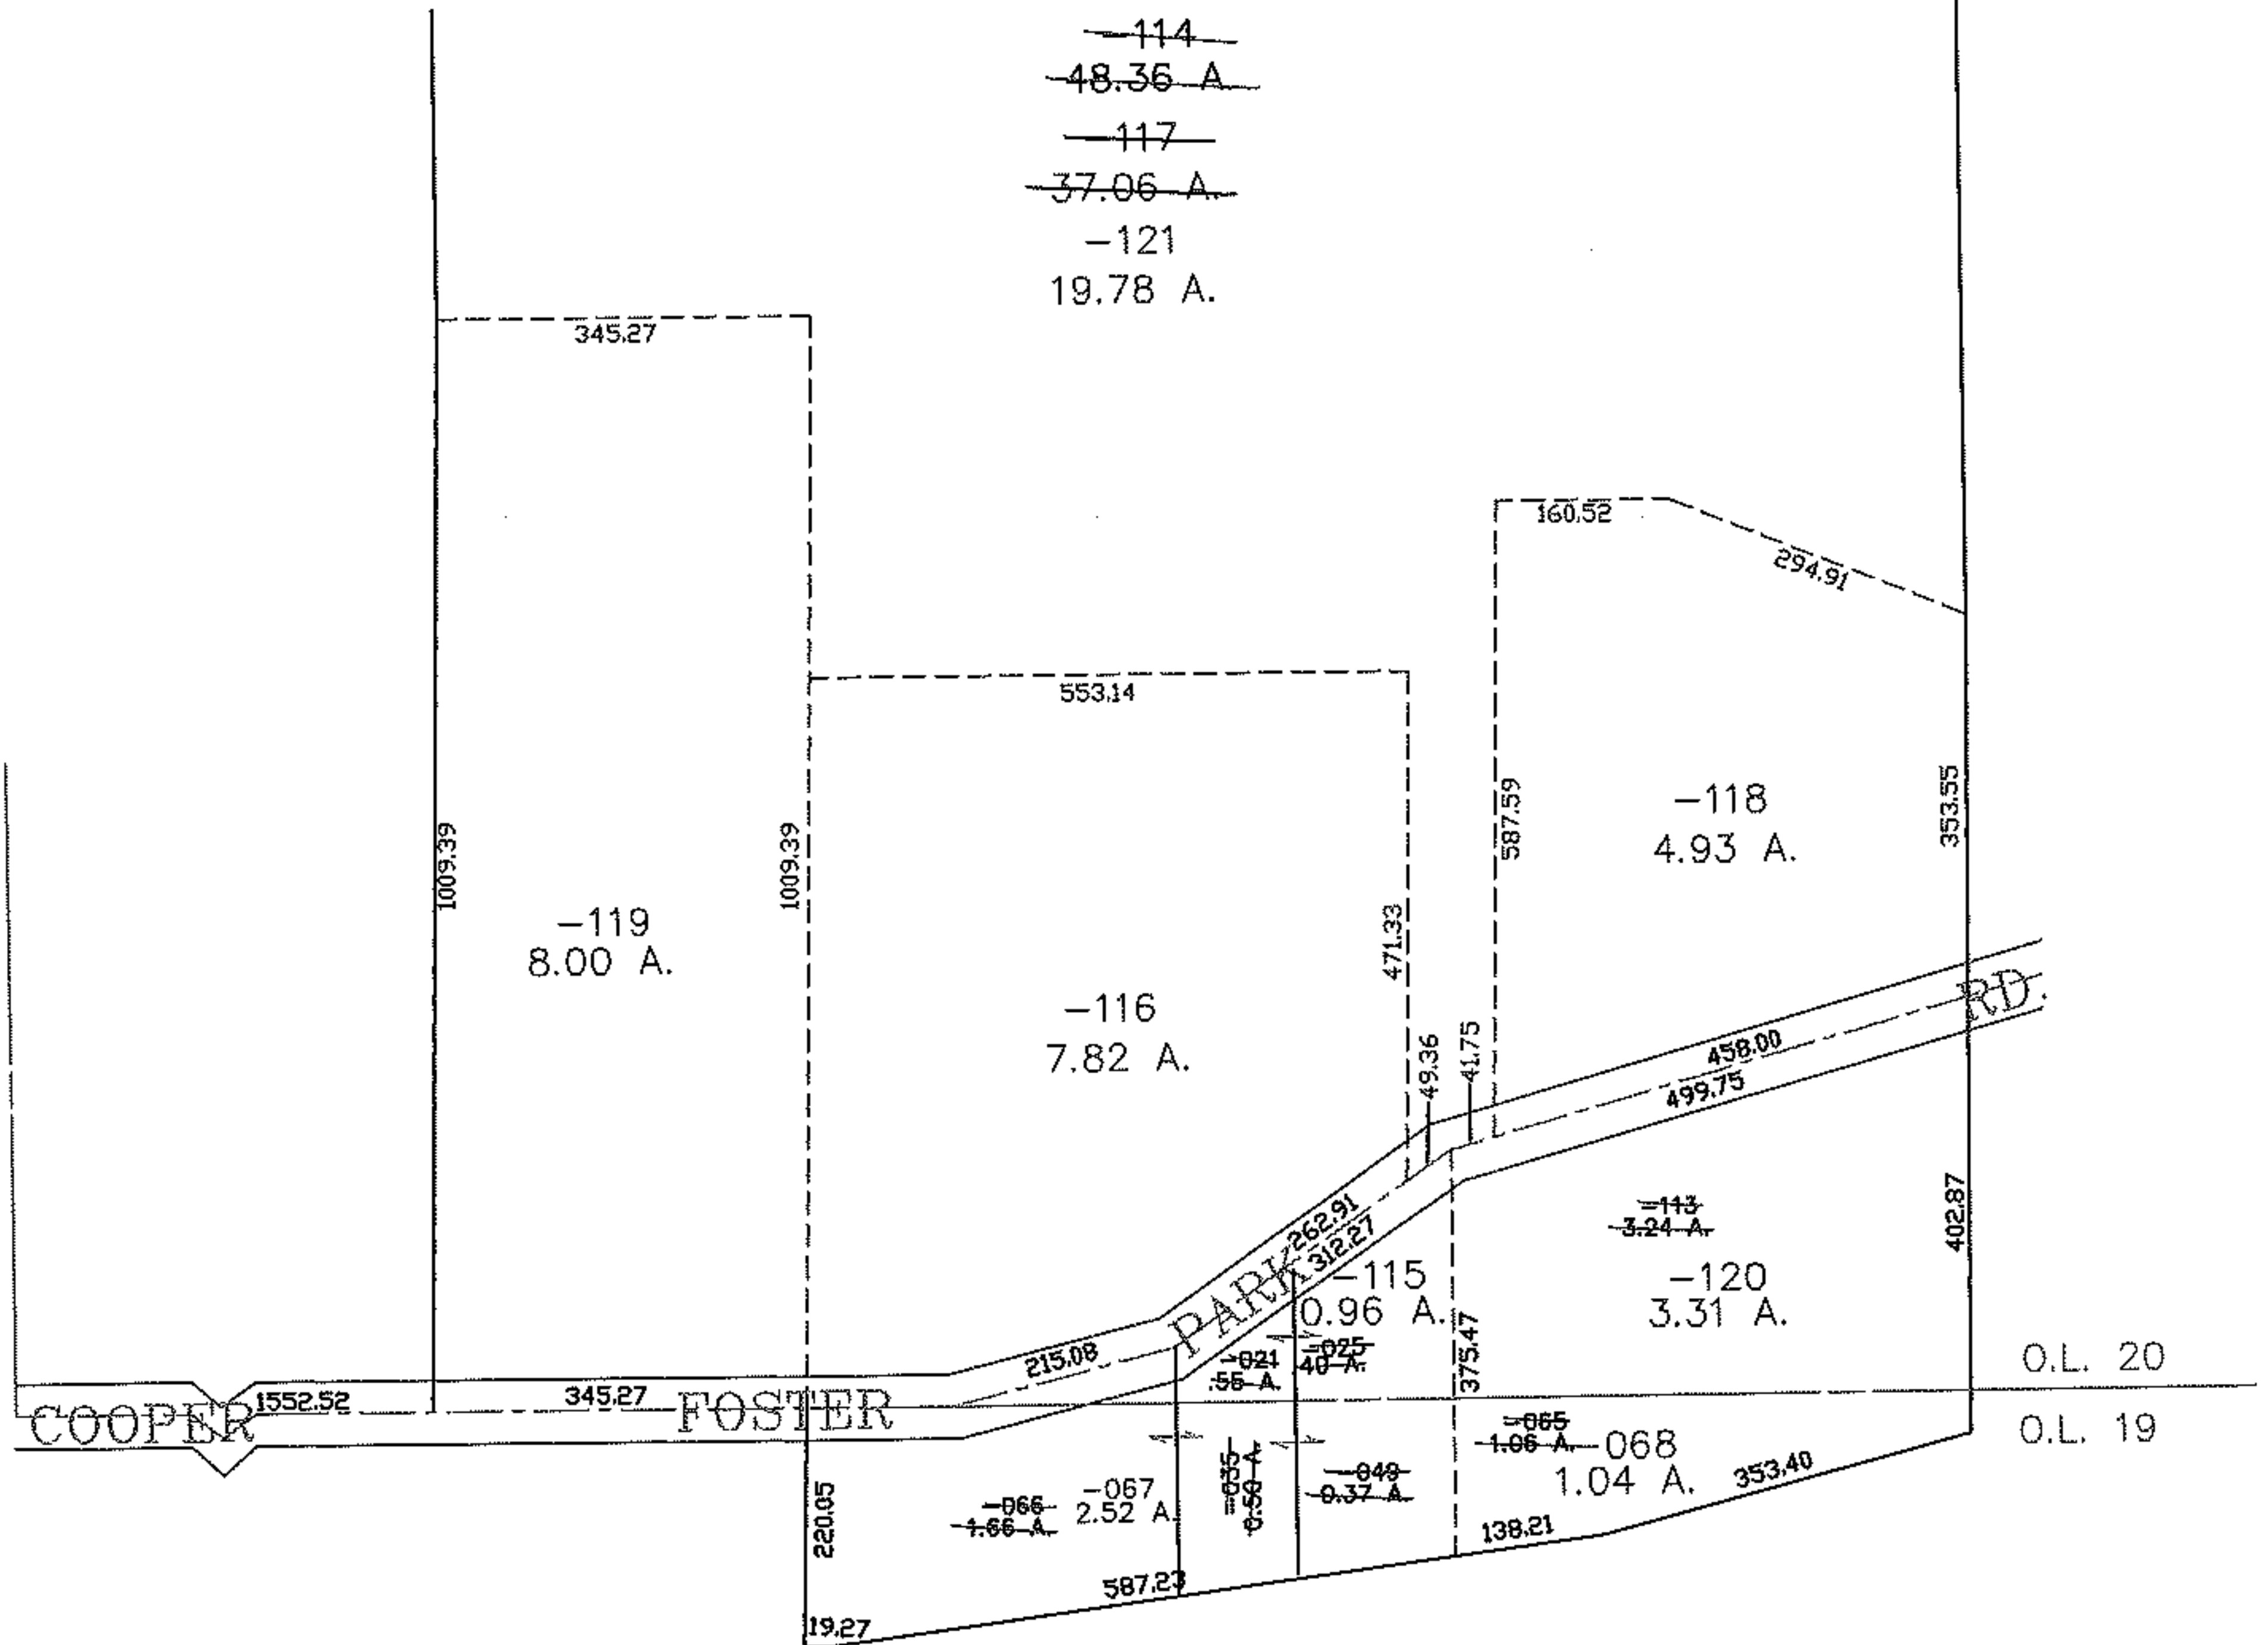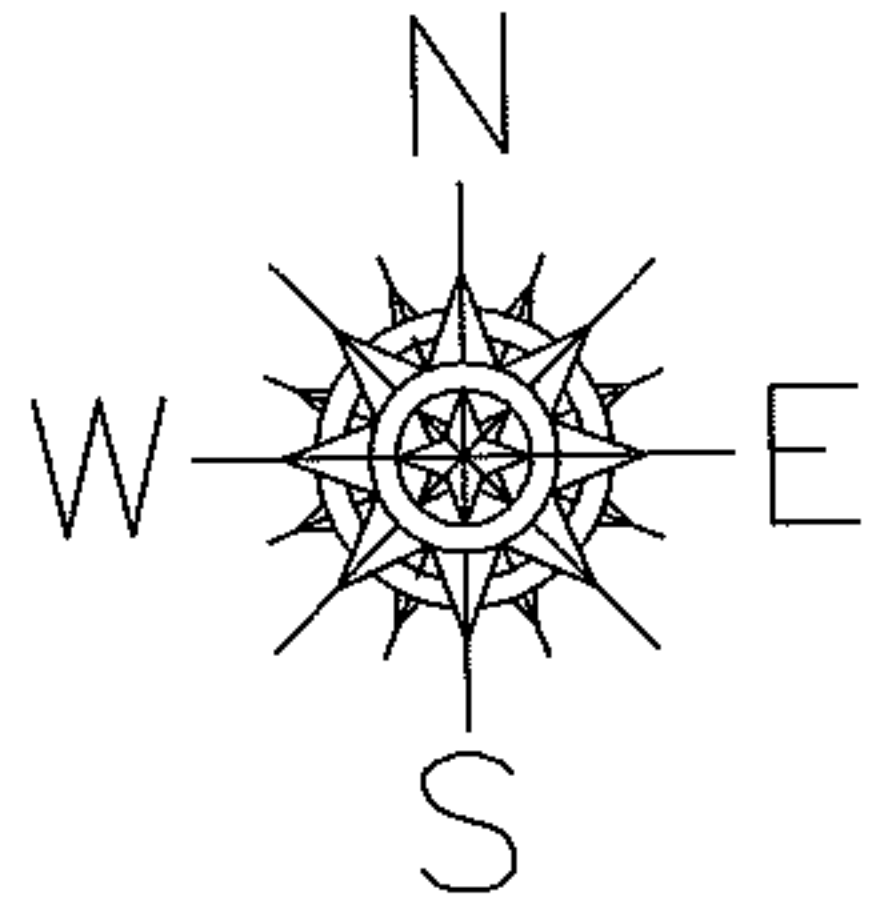

SPLITS/DEEDS PROCESSED

LORAIN COUNTY TAX MAP DEPARTMENT
226 MIDDLE AVE. ELYRIA, OHIO

SURVEYED BY: DAVE ELWELL

CLOSURE: 0.00 : 10,000

MAP PAGE(S): 05-00-020-B

APPROVED BY: JAH DATE: 8-12-05

SCALE: 1" = 300 PRIOR INSTRUMENT: 20050056726