
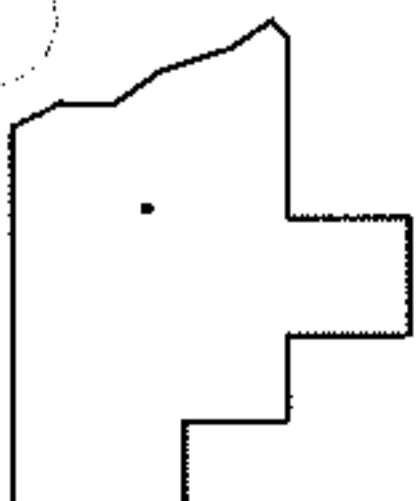
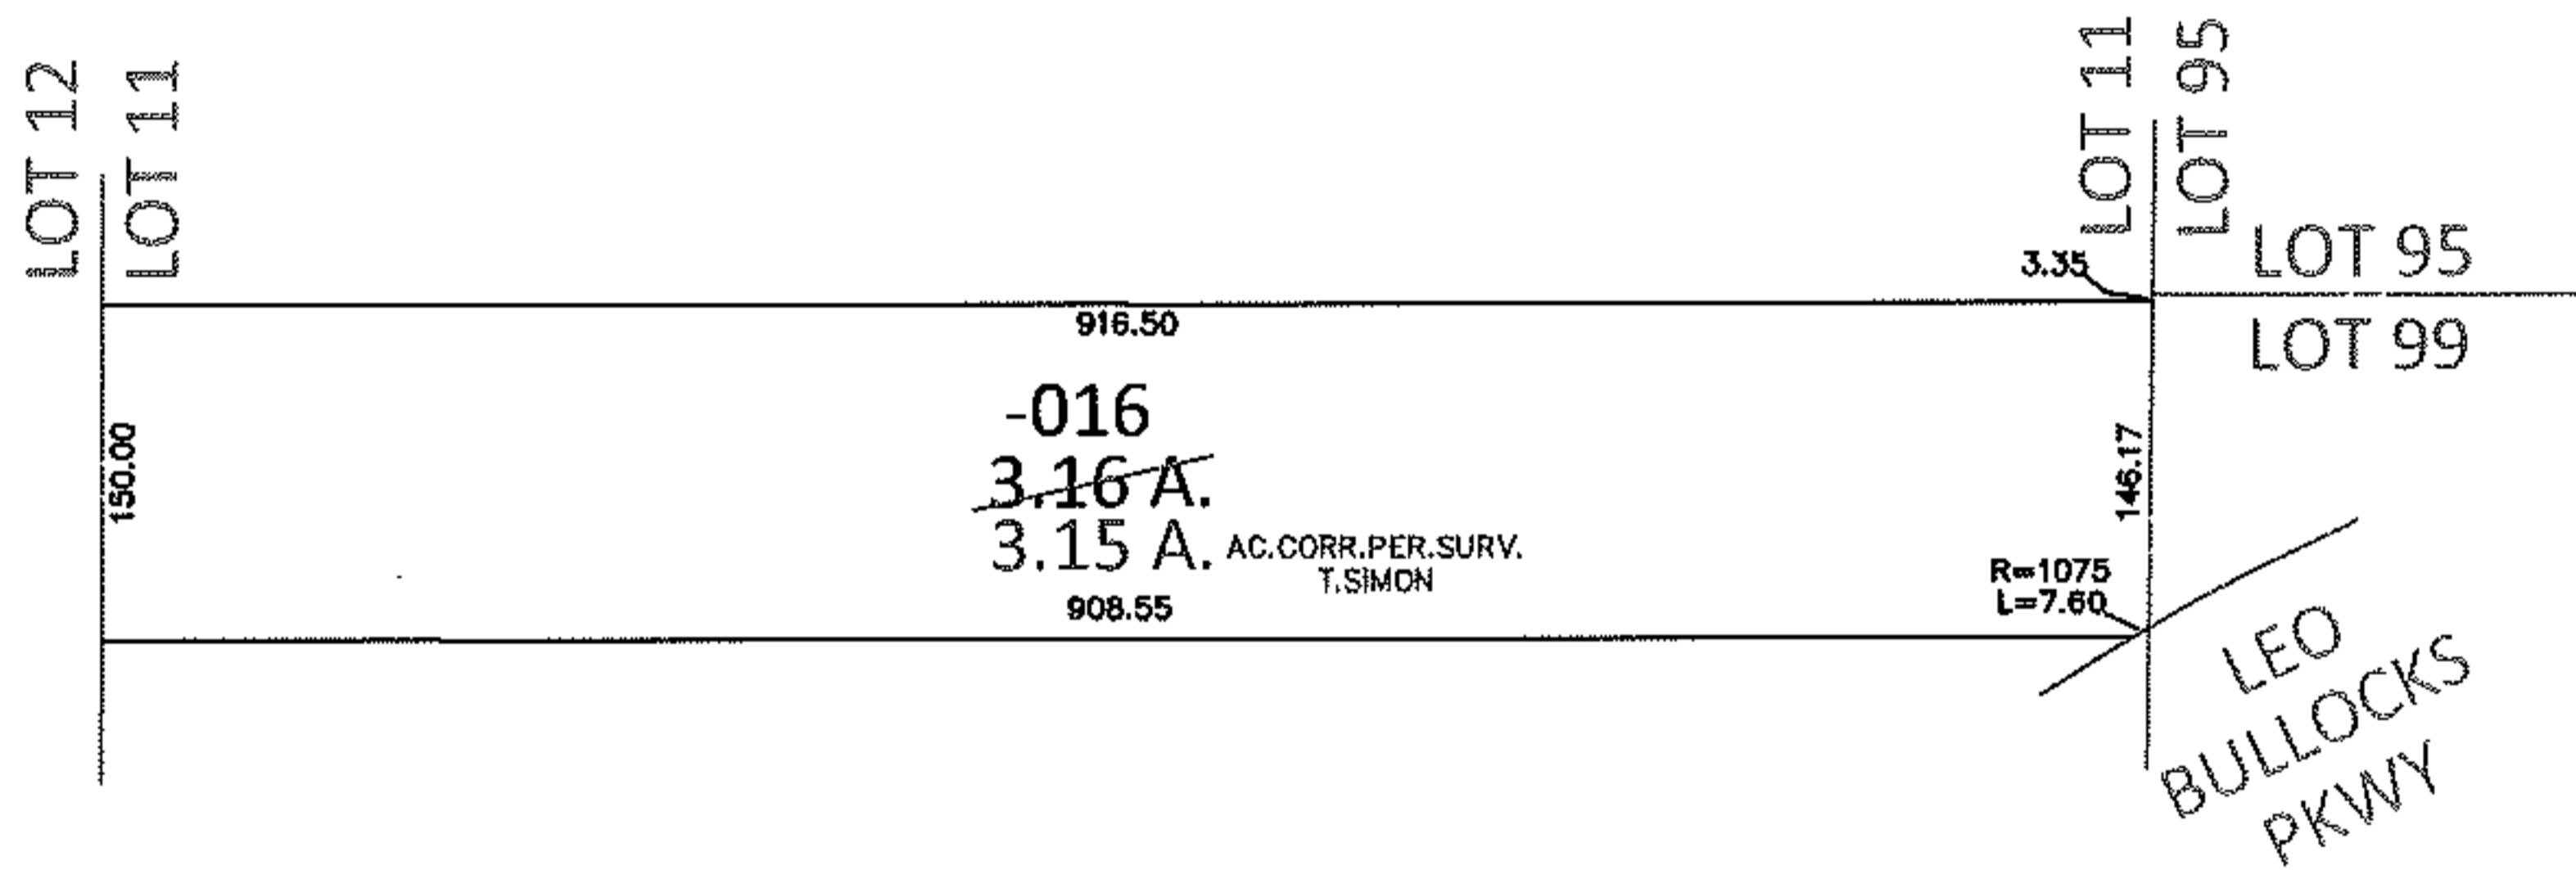


PARENT PARCEL: 06-24-011-000-016

CHILD PARCEL: _____

10-01980-C

STARTING POINT: AT A DRILL HOLE AT THE NORTHWEST CORNER OF LOT 99

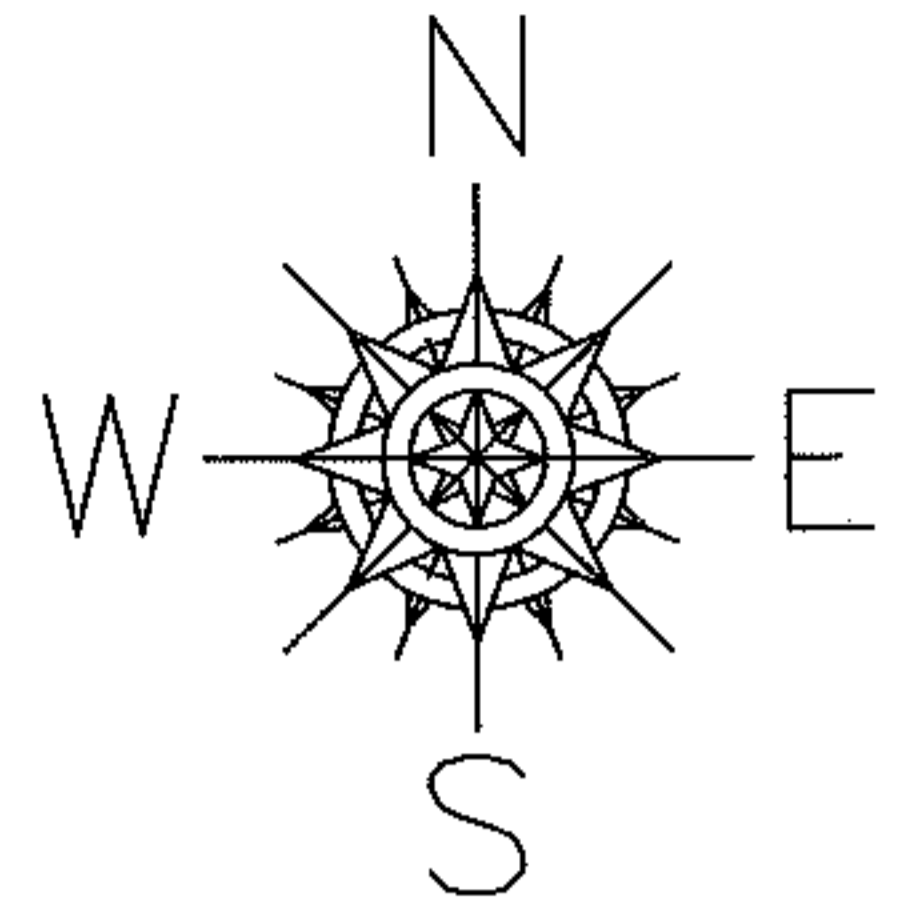

SPLITS/DEEDS PROCESSED

LORAIN COUNTY TAX MAP DEPARTMENT
226 MIDDLE AVE. ELYRIA, OHIO

SURVEYED BY: THOMAS A. SIMON

CLOSURE: .01:10,000

MAP PAGE(S): 6-115

APPROVED BY: RRM DATE: 3-3-10

SCALE: 1"= 200 PRIOR INST.: 2003886955