

PARENT PARCEL: 04-00-010-116-038

CHILD PARCEL: 04-00-010-116-039 & -040

STARTING POINT: CL OF JULIAN ST. & CL OF RIDGEVILLE-LORAIN RD.

10-01981-U

UNCOMBINATION

~~04-00-010-116-038~~
~~0.48 A.~~

04-00-010-116-039
0.21 A.




PER DV 1359/284

SURVEY BEFORE NEXT TRANSFER

DOESN'T CLOSE BY 9.85'

04-00-010-116-040
0.27 A.

PER DV 1394/594

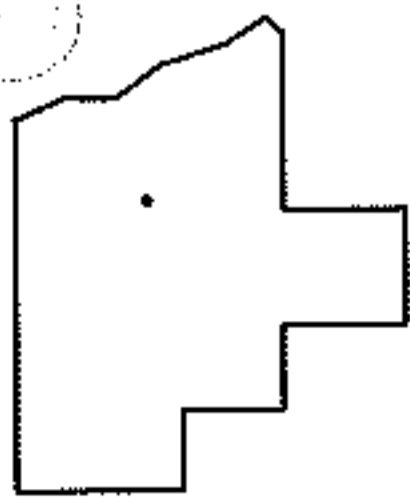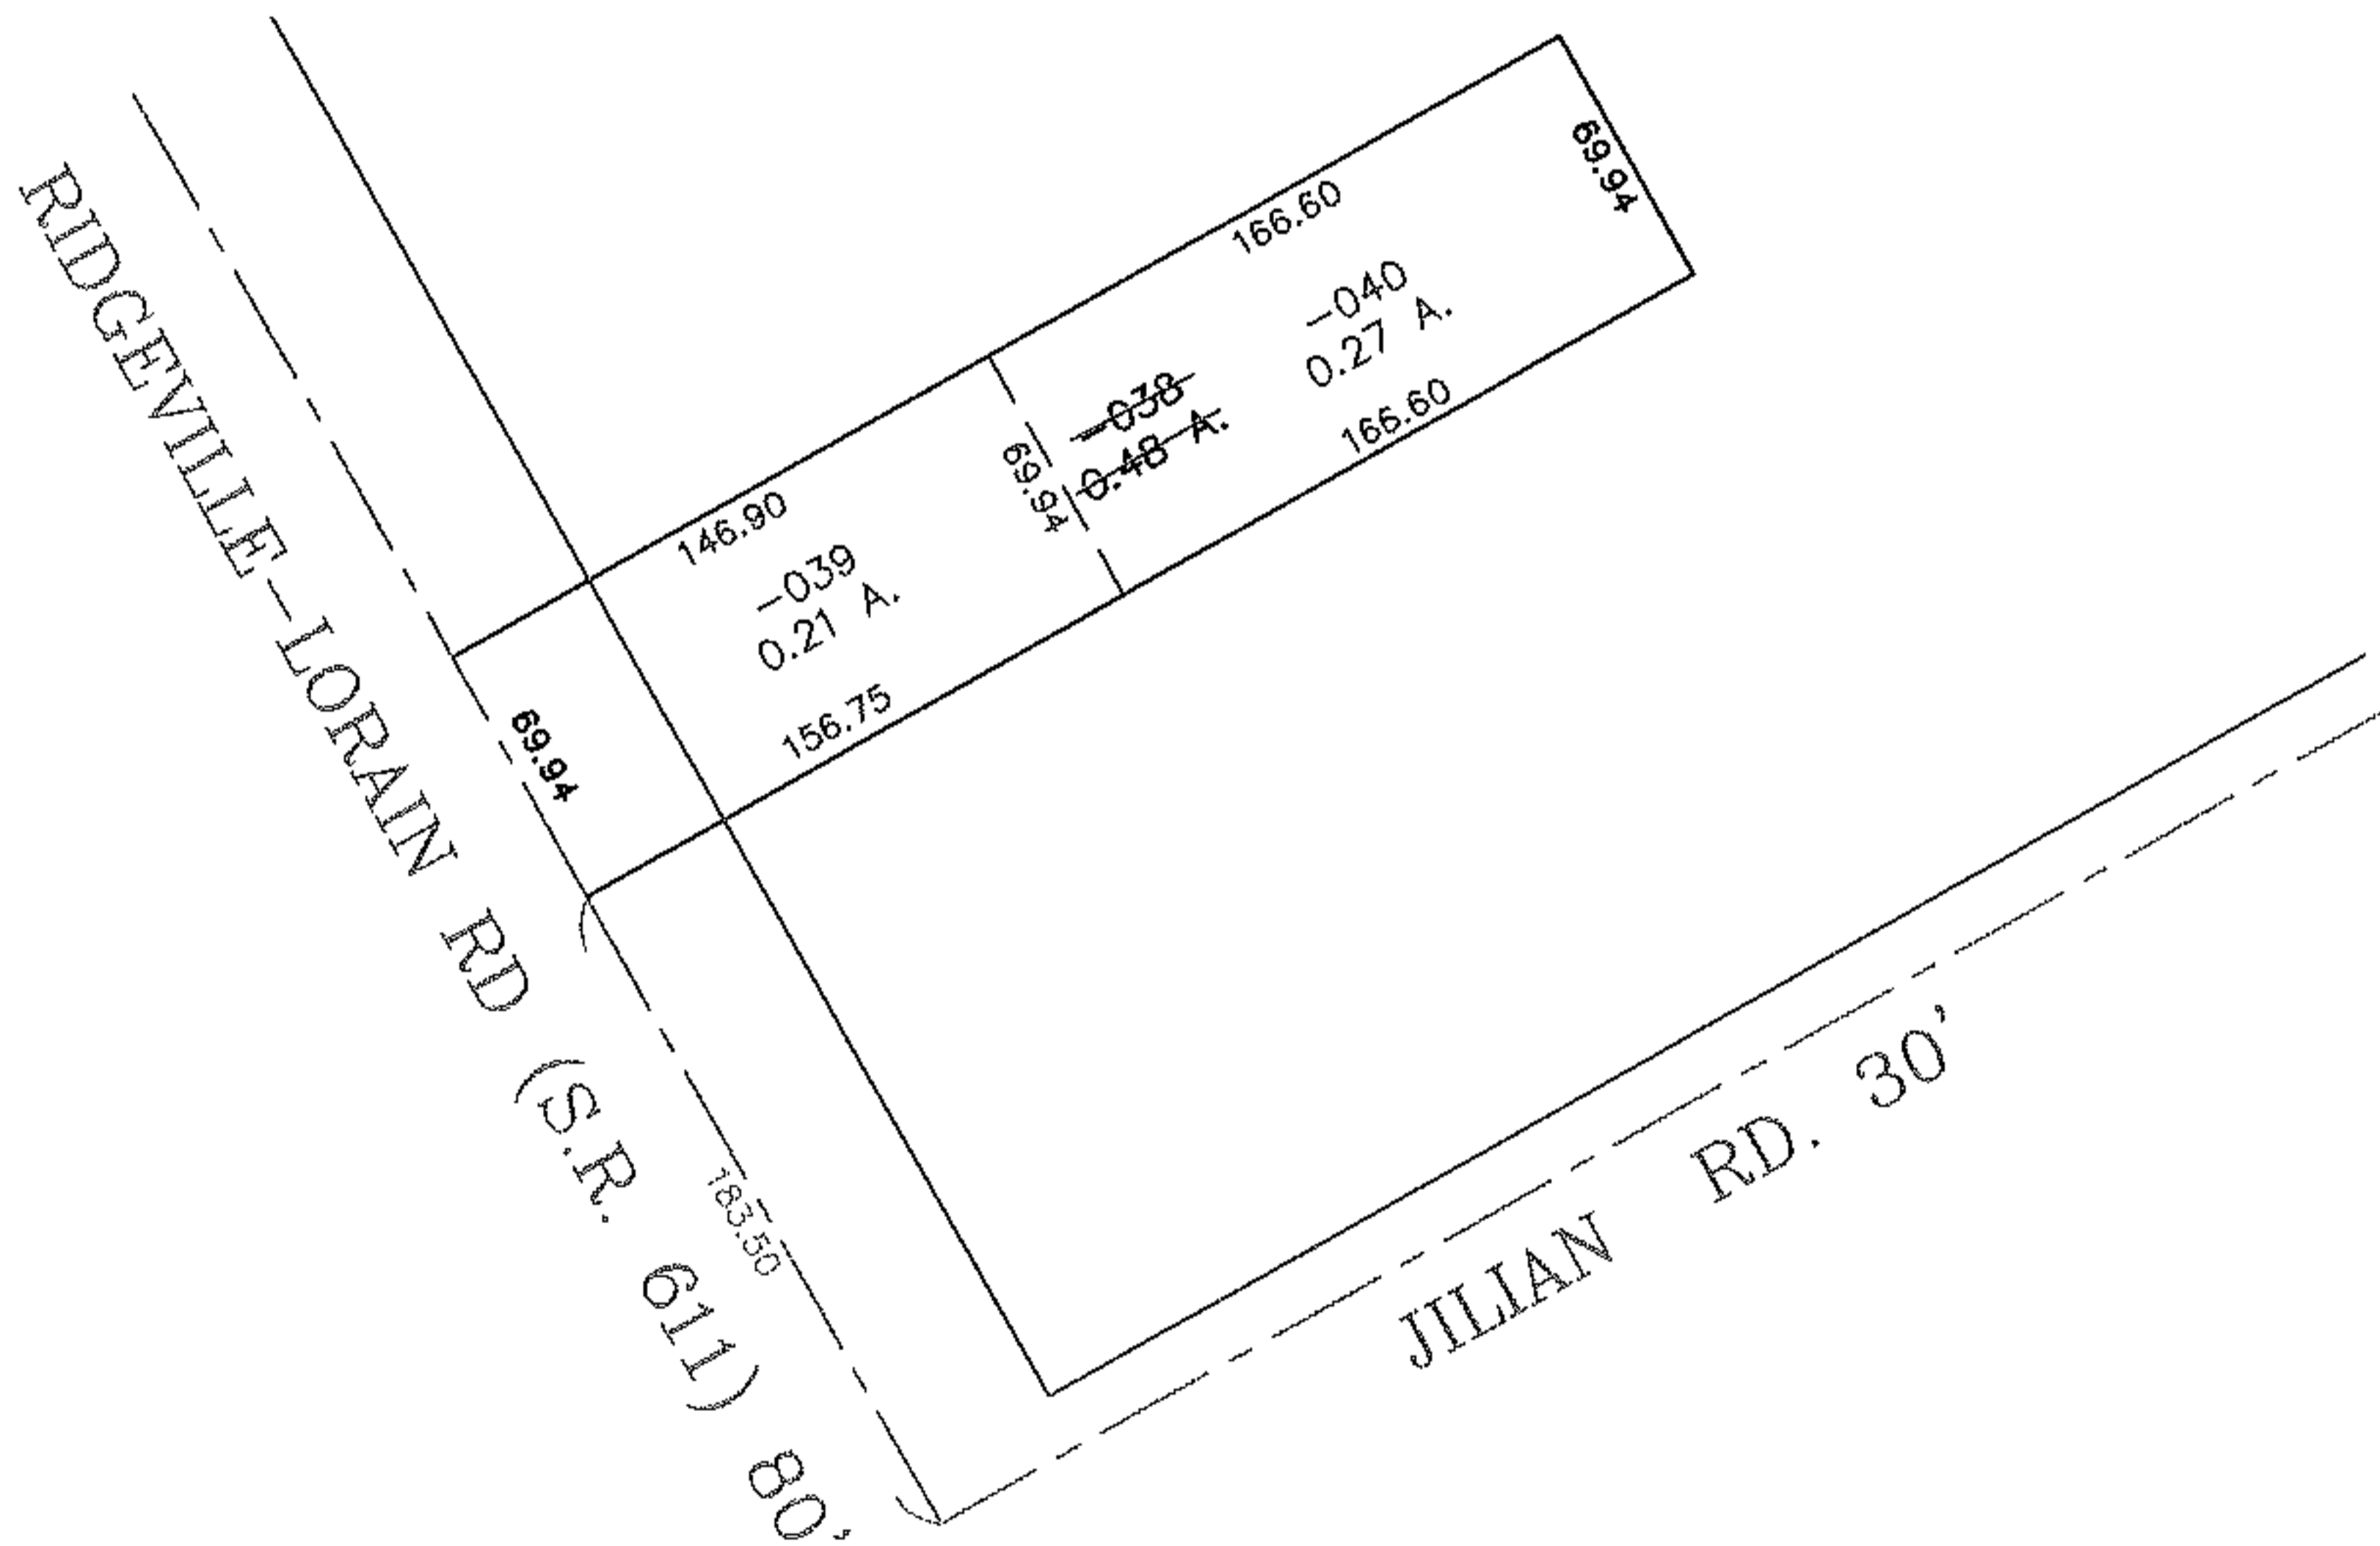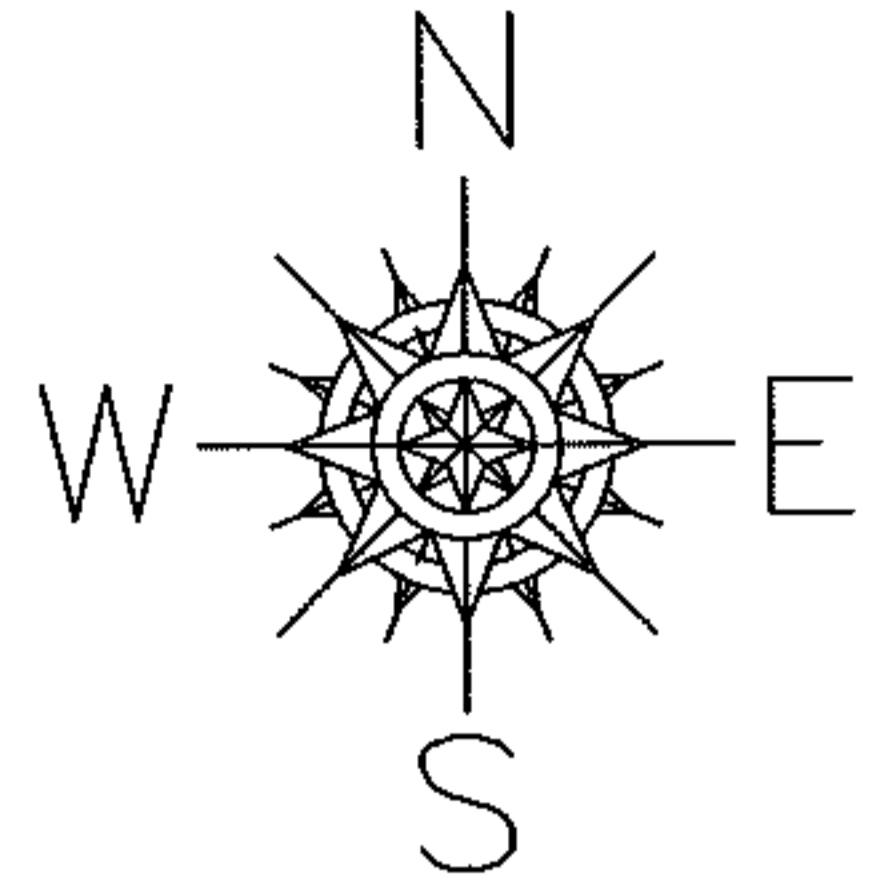

SPLITS/DEEDS PROCESSED
LORAIN COUNTY TAX MAP DEPARTMENT
226 MIDDLE AVE. ELYRIA, OHIO

SURVEYED BY: XXXXXXXXXXXXX
CLOSURE: DOESN'T CLOSE
MAP PAGE(S): 04-00-010-G
APPROVED BY: TJS DATE: 3/5/10
SCALE: 1" = 100'