


PARENT PARCEL: 02-00-051-142-024

10-01983-D

CHILD PARCEL:

STARTING POINT: INTERSECTION OF WEST R.O.W. LINE OF HENDERSON DR. AND SOUTH R.O.W. LINE OF COLORADO AVE.

COLORADO AVE.

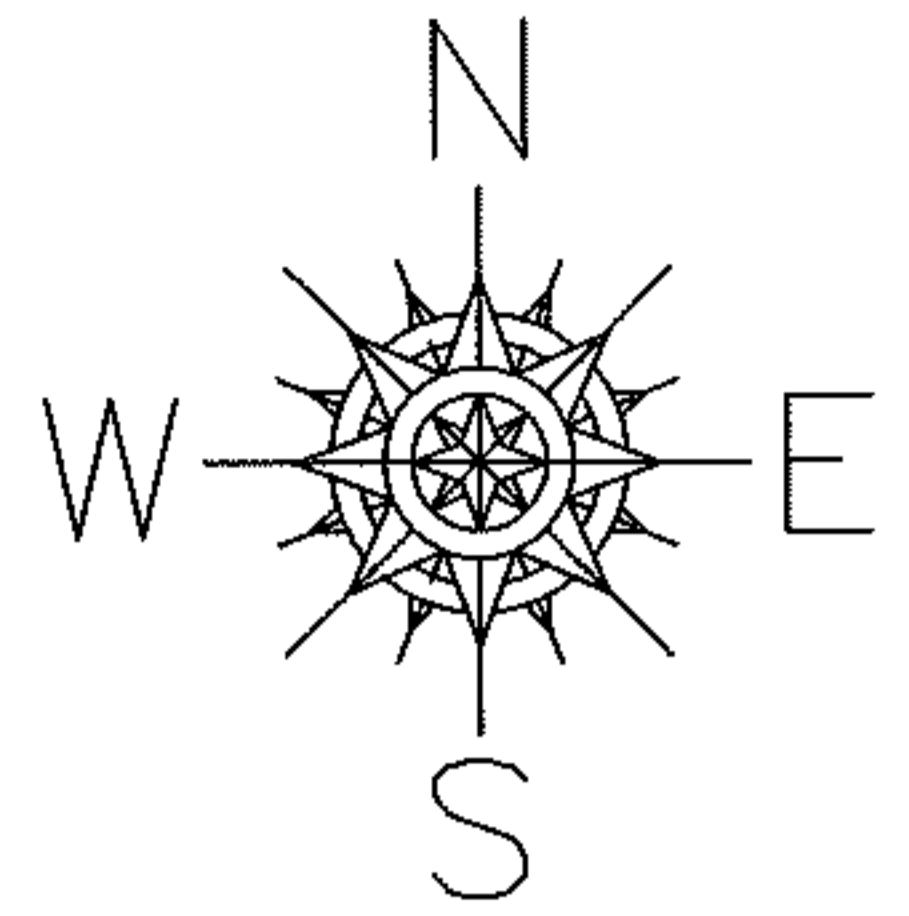

DR.

386.33

MAP CORRECTION ONLY

R=1106.28  
L=113.88

~~274.18~~  
267.14


R=1106.28  
L=204.19

-024  
1.15 A.

227.59  
~~234.89~~

200.00

HENDERSON

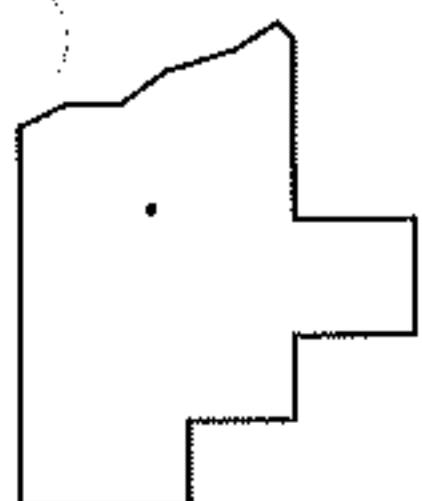

SPLITS/DEEDS PROCESSED

LORAIN COUNTY TAX MAP DEPARTMENT  
226 MIDDLE AVE. ELYRIA, OHIO

SURVEYED BY: SUHAIL & SUHAIL

CLOSURE: .00:10,000

MAP PAGE(S): 2-00-051-B

APPROVED BY: RRM DATE: 3-11-10

SCALE: 1"= 100 PRIOR INST.: 20080242801