
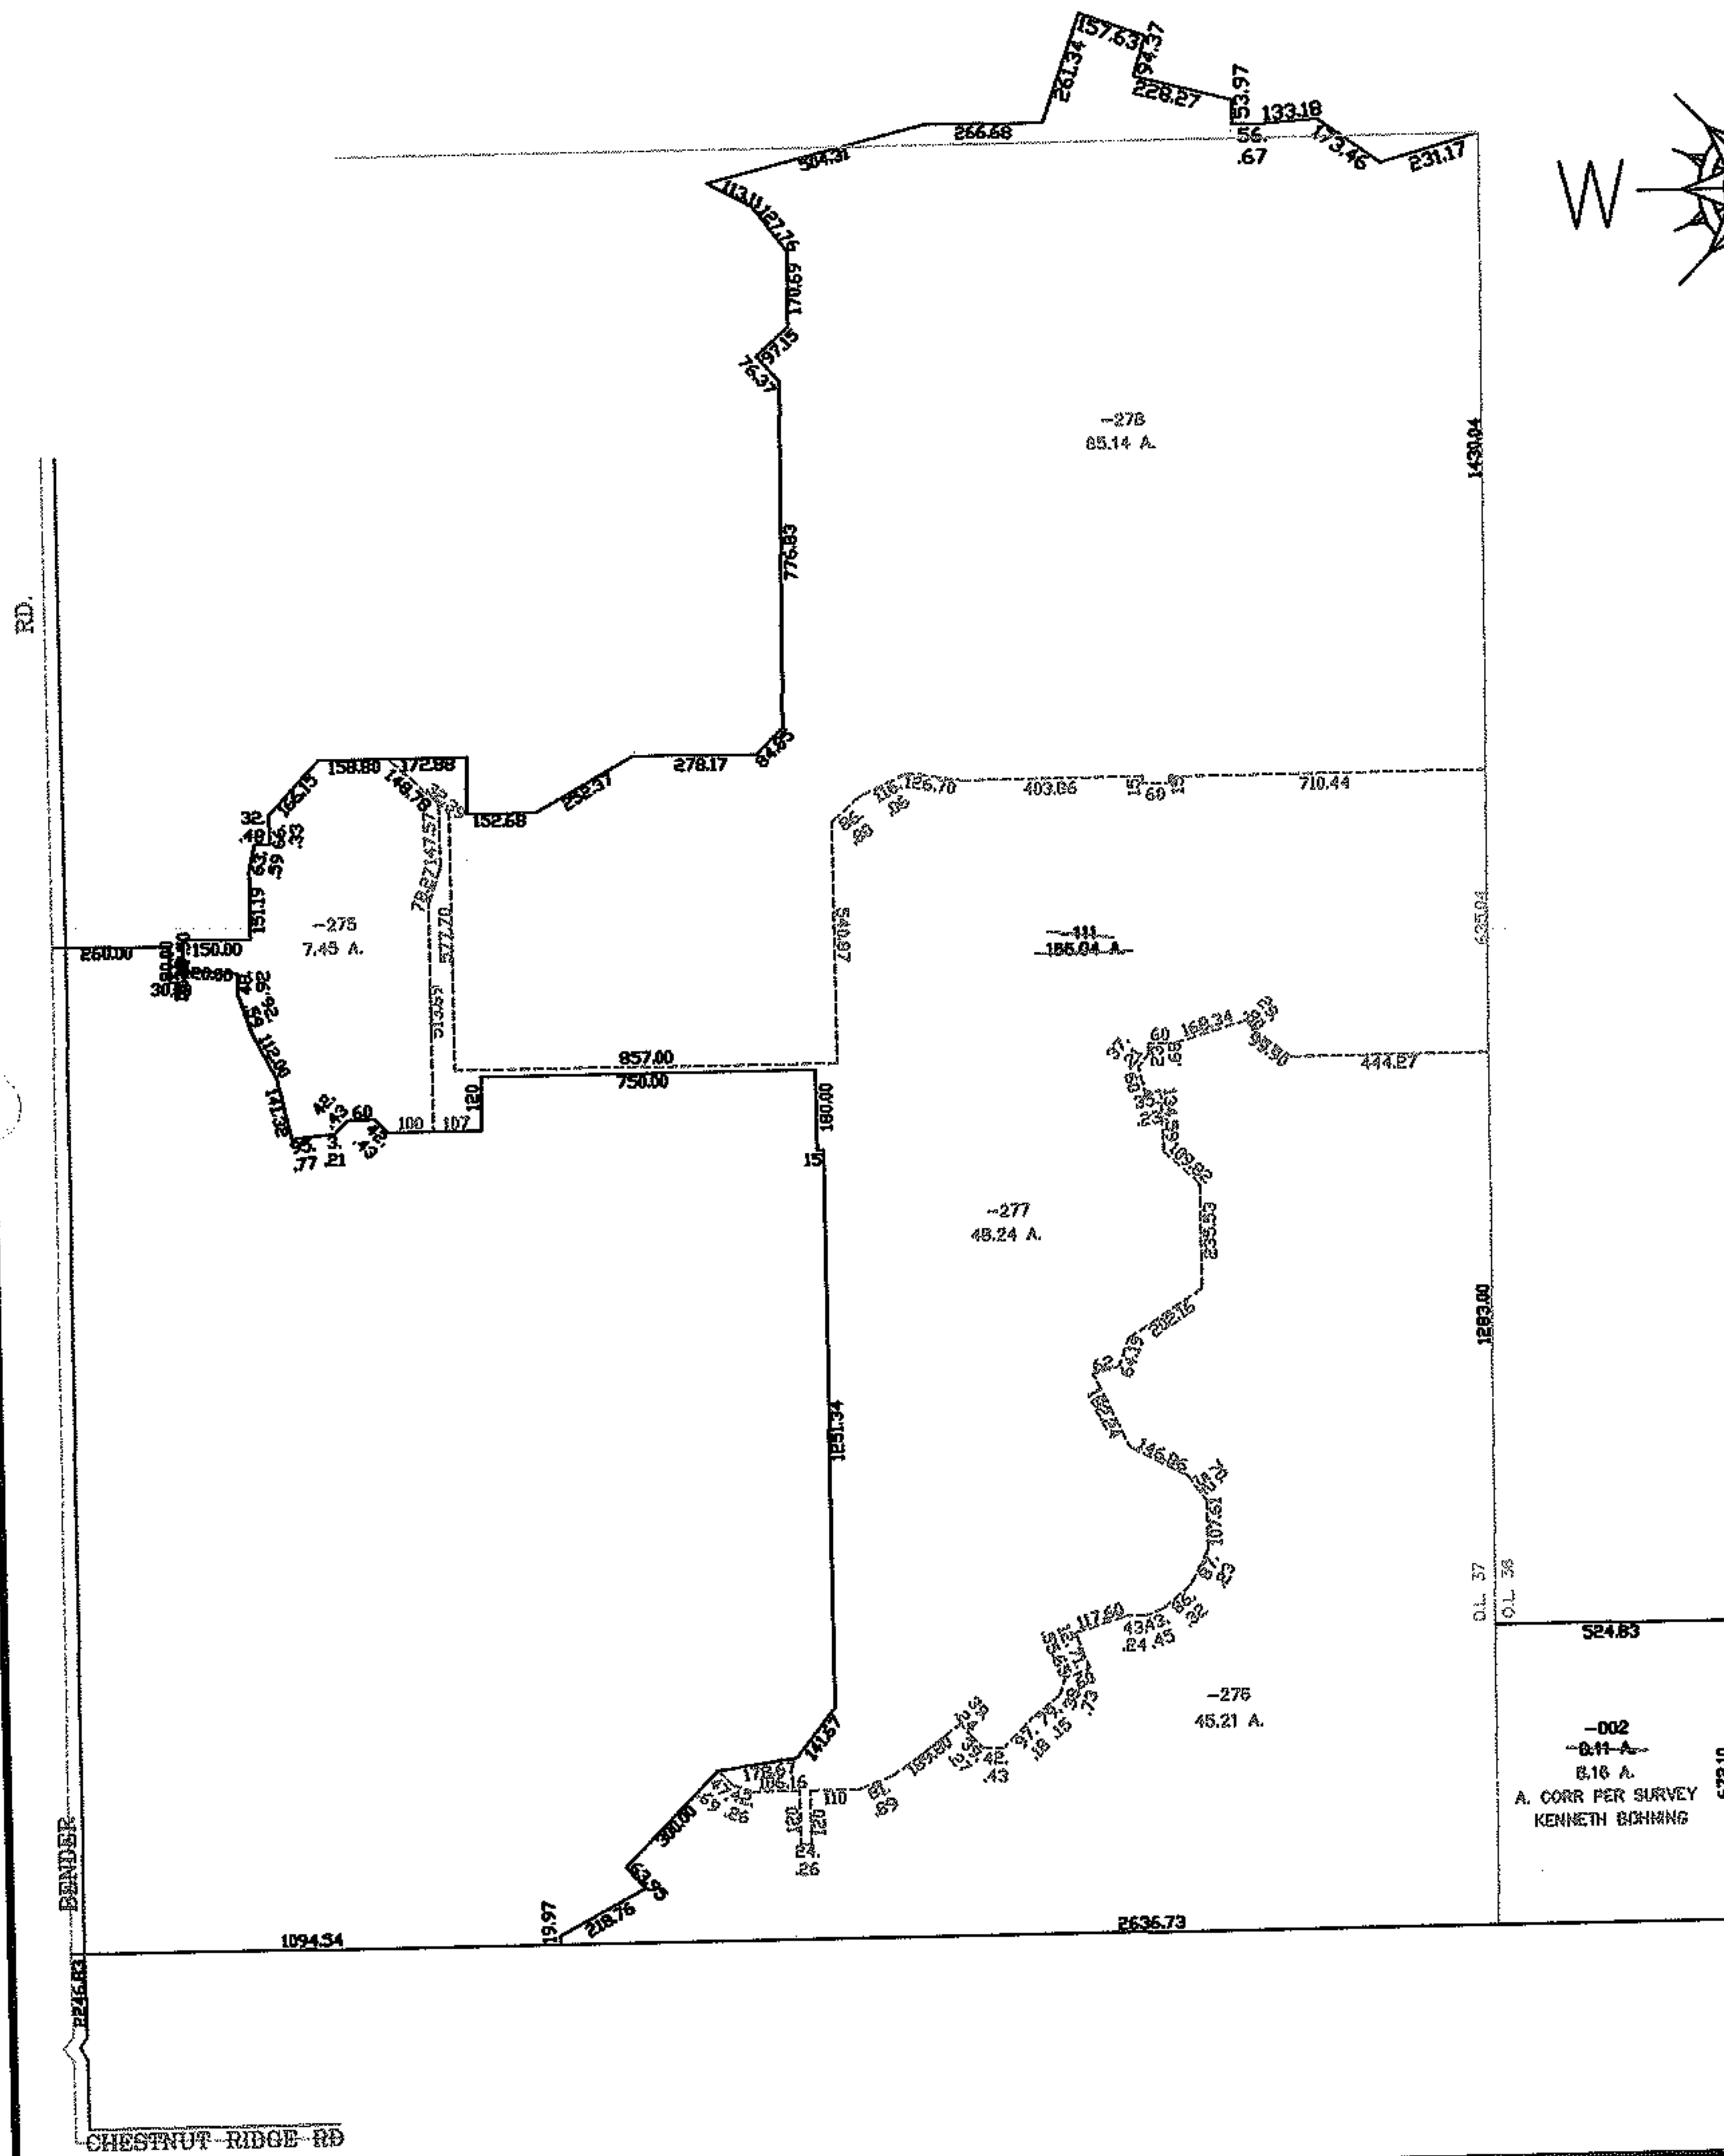


PARENT PARCEL: 07-00-037-000-111, 07-00-036-000-002

CHILD PARCEL: 07-00-037-000-275 THRU -278

STARTING POINT: CENTERLINE OF BENDER RD. & CHESTNUT RIDGE RD.

NO. 01983

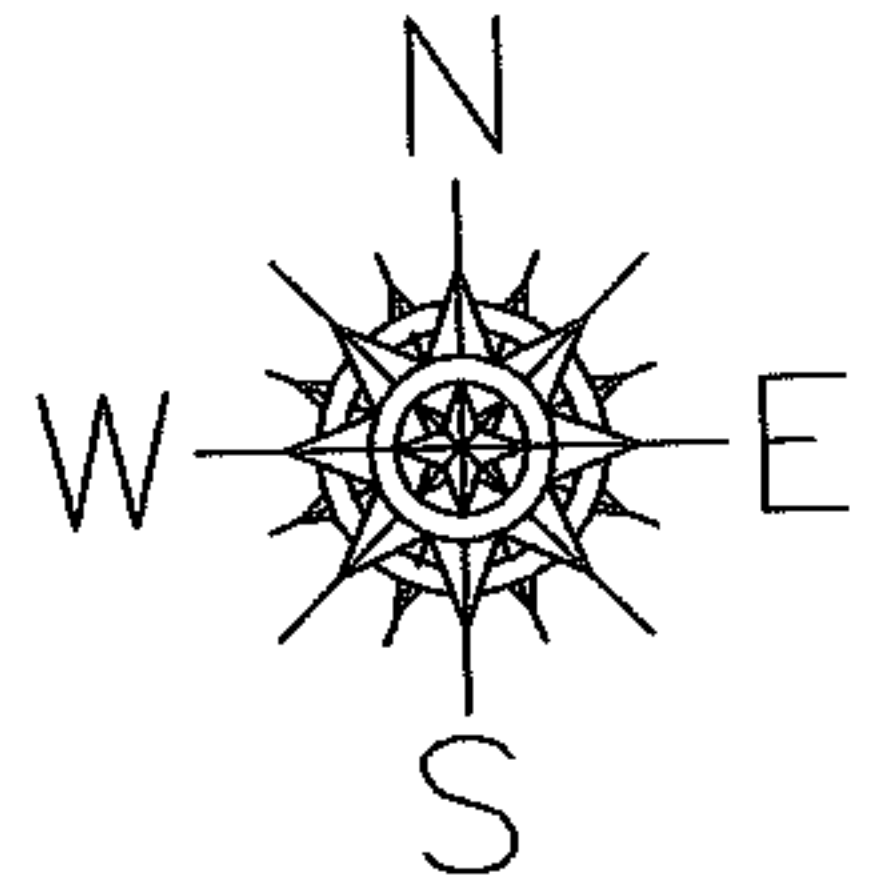

524.83  
-002  
-011-A-  
8.16 A.  
A. CORR PER SURVEY  
KENNETH BOHNING  
672.10

**SPLITS/DEEDS PROCESSED**

LORAIN COUNTY TAX MAP DEPARTMENT  
226 MIDDLE AVE. ELYRIA, OHIO

SURVEYED BY: KENNETH BOHNING

CLOSURE: 0.00 : 10.000

MAP PAGE(S): 7-E

APPROVED BY: JAH DATE: 8-17-05

SCALE: 1" = 600 PRIOR INSTRUMENT: 20050055528