

PARENT PARCEL: 02-01-005-120-001

CHILD PARCEL: 02-01-005-120-027

STARTING POINT: XXXXXX

10-01984-C

DEPTH CORRECTION


02-01-005-120-001

~~60 X 68~~

60 X 65

CORR. PER DEED

INST. # 20030975657

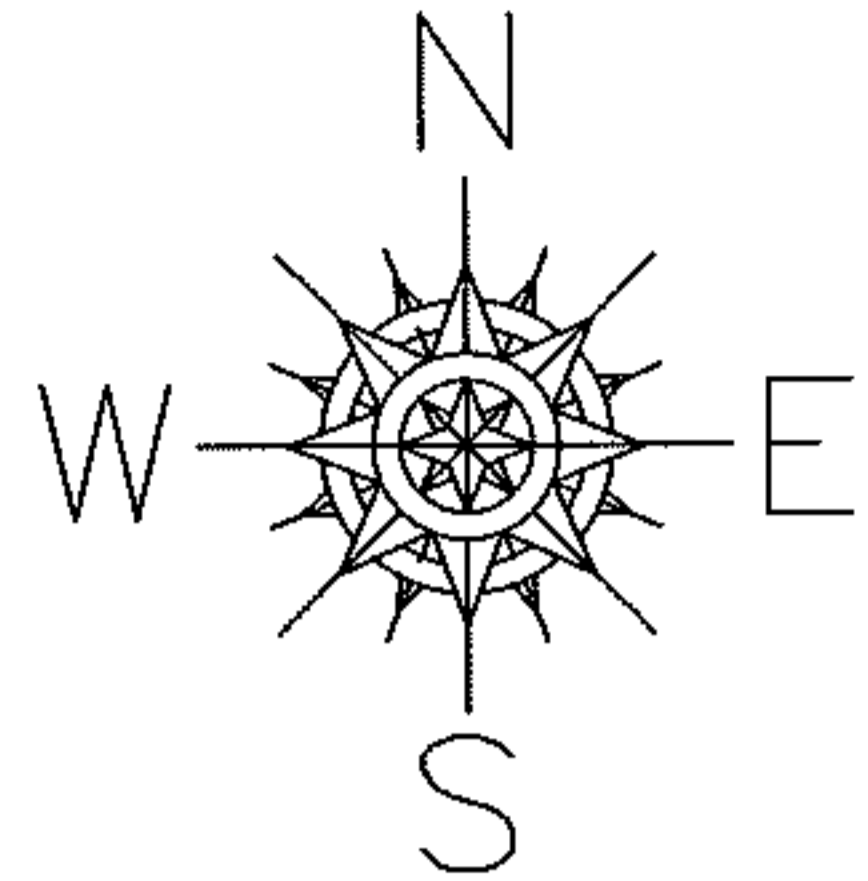

ADD TO DUPLICATE

02-01-005-120-027


3 X 60

CORR. PER DEED

DV 224/61

9TH ST.

WASHINGTON AVE.

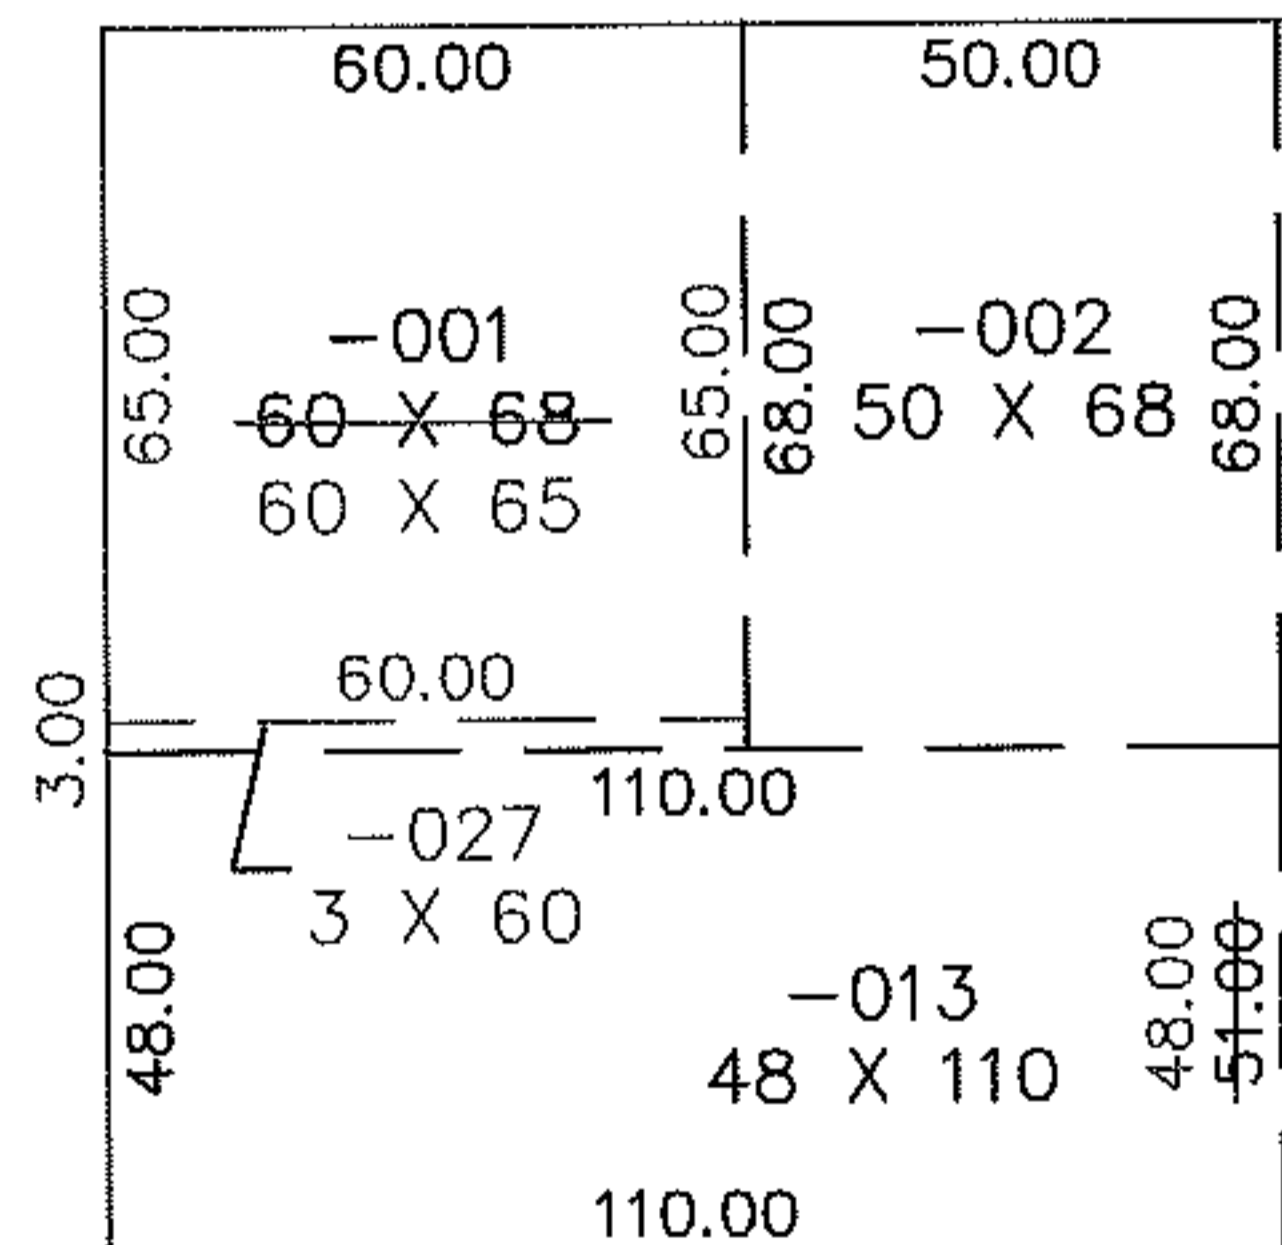

SPLITS/DEEDS PROCESSED

LORAIN COUNTY TAX MAP DEPARTMENT
226 MIDDLE AVE. ELYRIA, OHIO

SURVEYED BY: XXXXXXXXXXXX

CLOSURE: XXXXXX

MAP PAGE(S): 2-01-005-B

APPROVED BY: TJS DATE: 3/12/10

SCALE: 1"= 50'