



RASTER

PARENT PARCEL: 10-00-005-102-474, 06-25-001-000-010, 06-25-001-000-021

CHILD PARCEL: 10-00-005-102-489 THRU -492 06-25-001-000-233

STARTING POINT: CENTERLINE OF ABBE RD. & HAMPTON RD.

NO. 01986

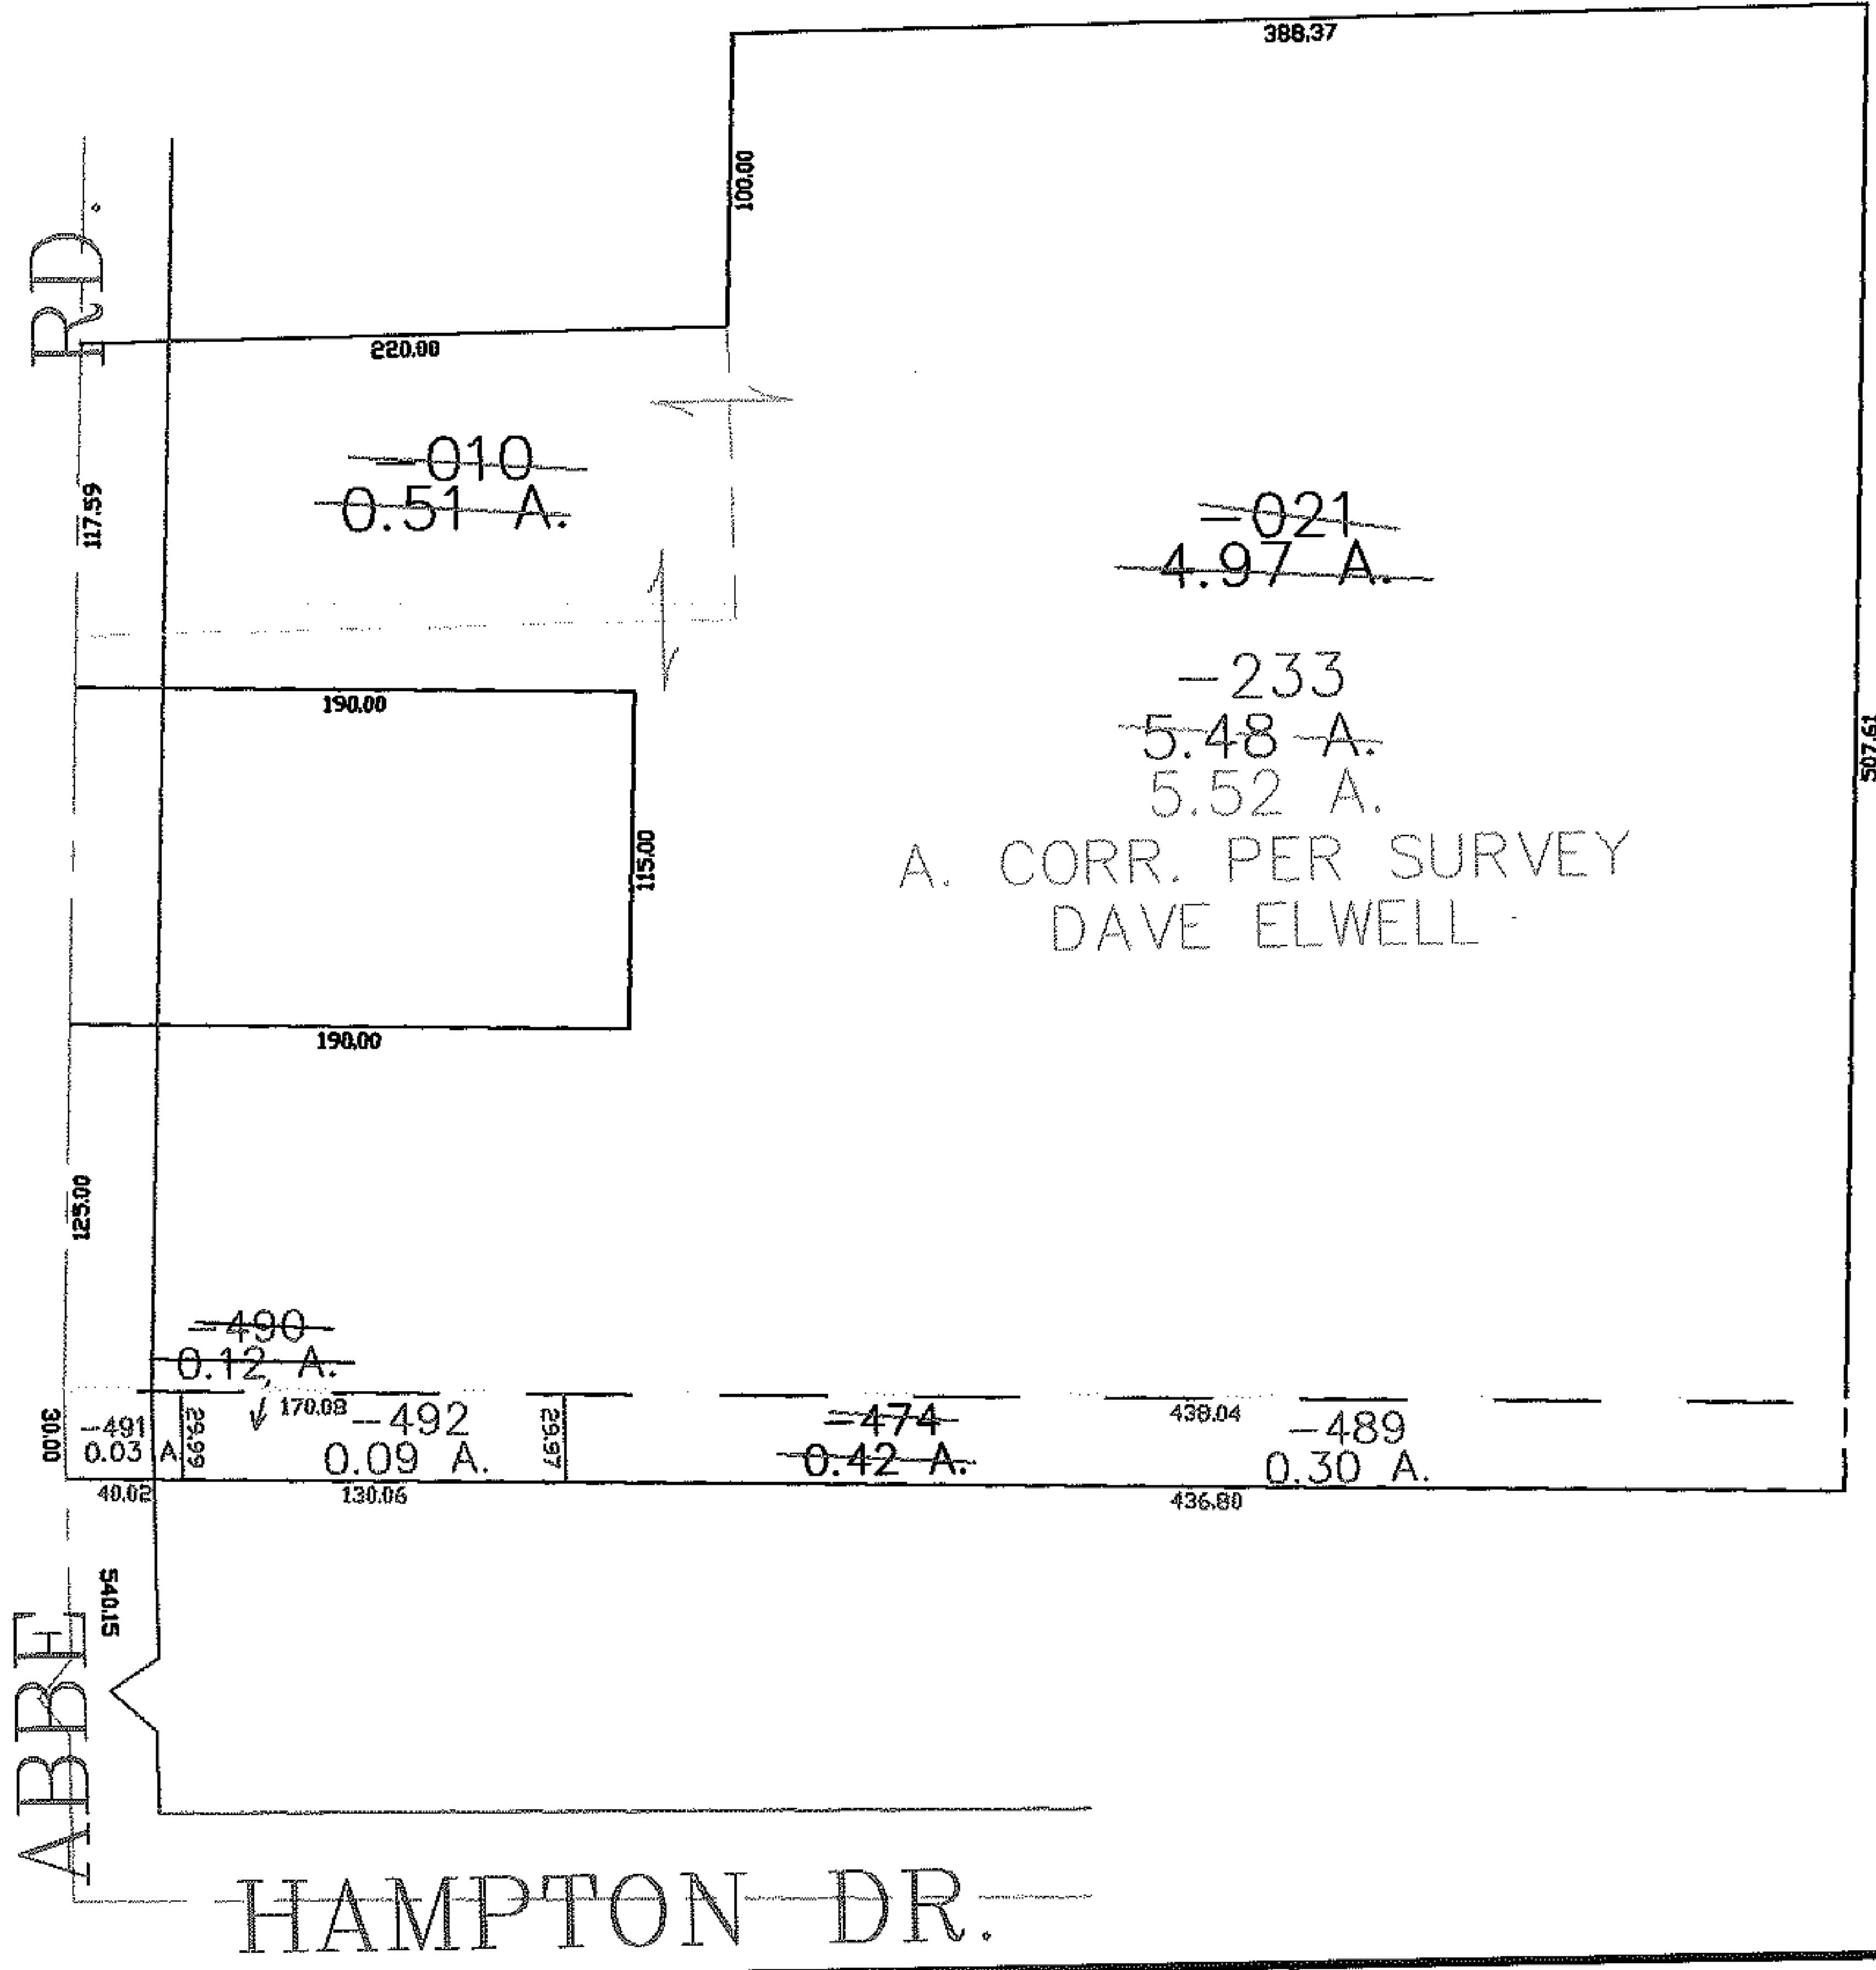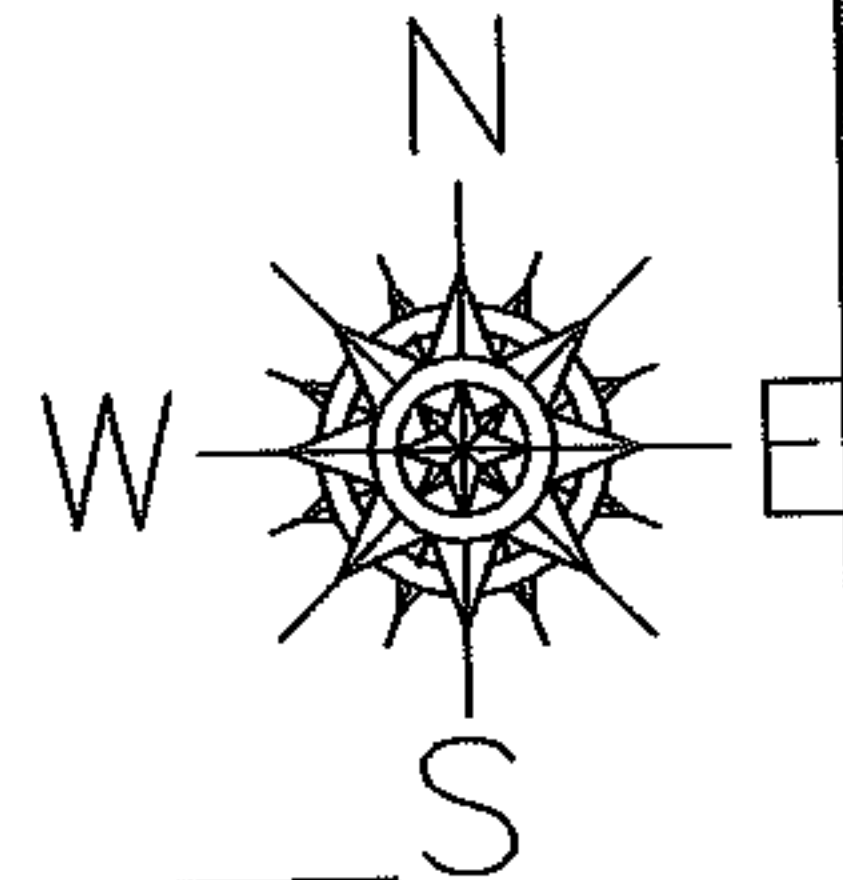

**SPLITS/DEEDS PROCESSED**

LORAIN COUNTY TAX MAP DEPARTMENT  
226 MIDDLE AVE. ELYRIA, OHIO

SURVEYED BY: DAVE ELWELL  
 CLOSURE: 0.00 : 10.000  
 MAP PAGE(S): 10-00-005-C  
 APPROVED BY: JAH DATE: 8-22-05  
 SCALE: 1" = 100 PRIOR INSTRUMENT: 980529146