


PARENT PARCEL: 04-00-029-000-524

CHILD PARCEL: _____

STARTING POINT: S/L 183 IN BRIDGESIDE SUB. NO.5

10-01987-C

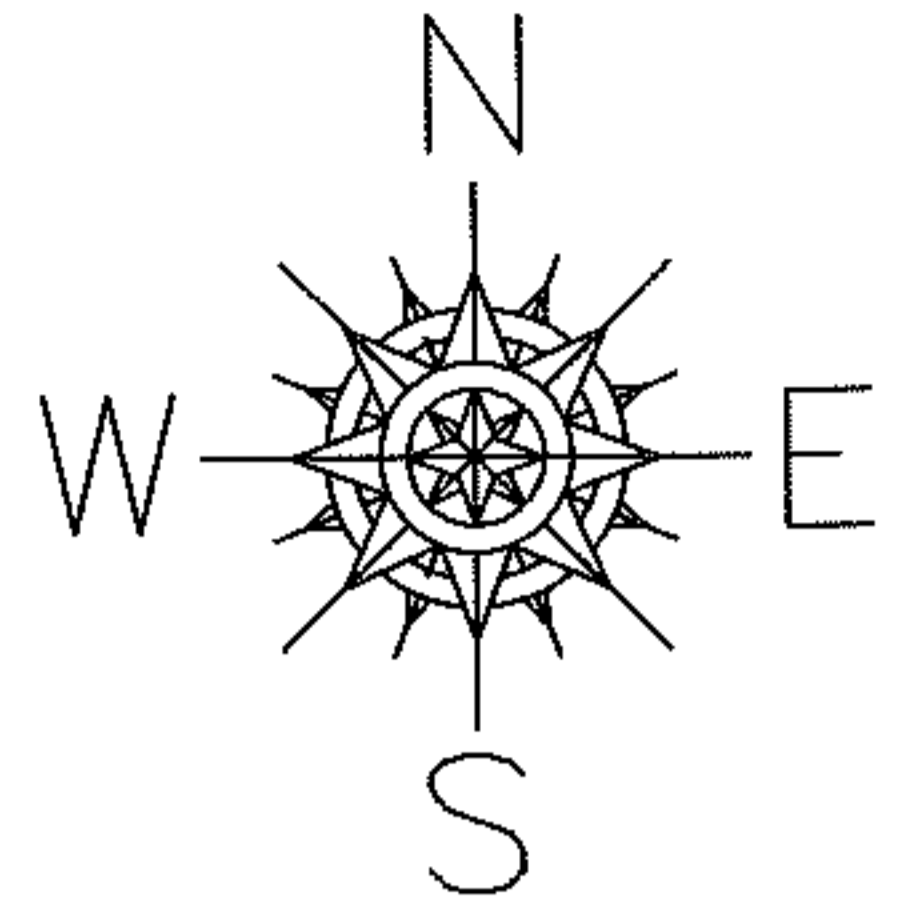

FRONTAGE CORRECTION


S/L 183 IN BRIDGESIDE SUB NO.5

VOL.75 PGS.42-44

04-00-029-000-524

125.33 FRONTAGE CORR. PER PLAT.

~~226.58~~ X 136.00

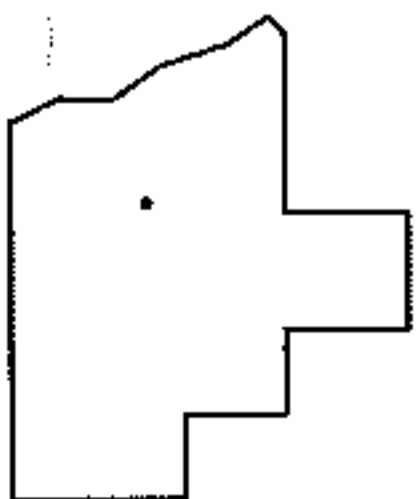

SPLITS/DEEDS PROCESSED

LORAIN COUNTY TAX MAP DEPARTMENT
226 MIDDLE AVE. ELYRIA, OHIO

SURVEYED BY: MICHAEL A. STRAUB

CLOSURE: .00:10,000

MAP PAGE(S): 4-00-029-F

APPROVED BY: RRM DATE: 3-17-10

SCALE: 1"= 100 PRIOR INST.: VOL.75 PGS.42-44