
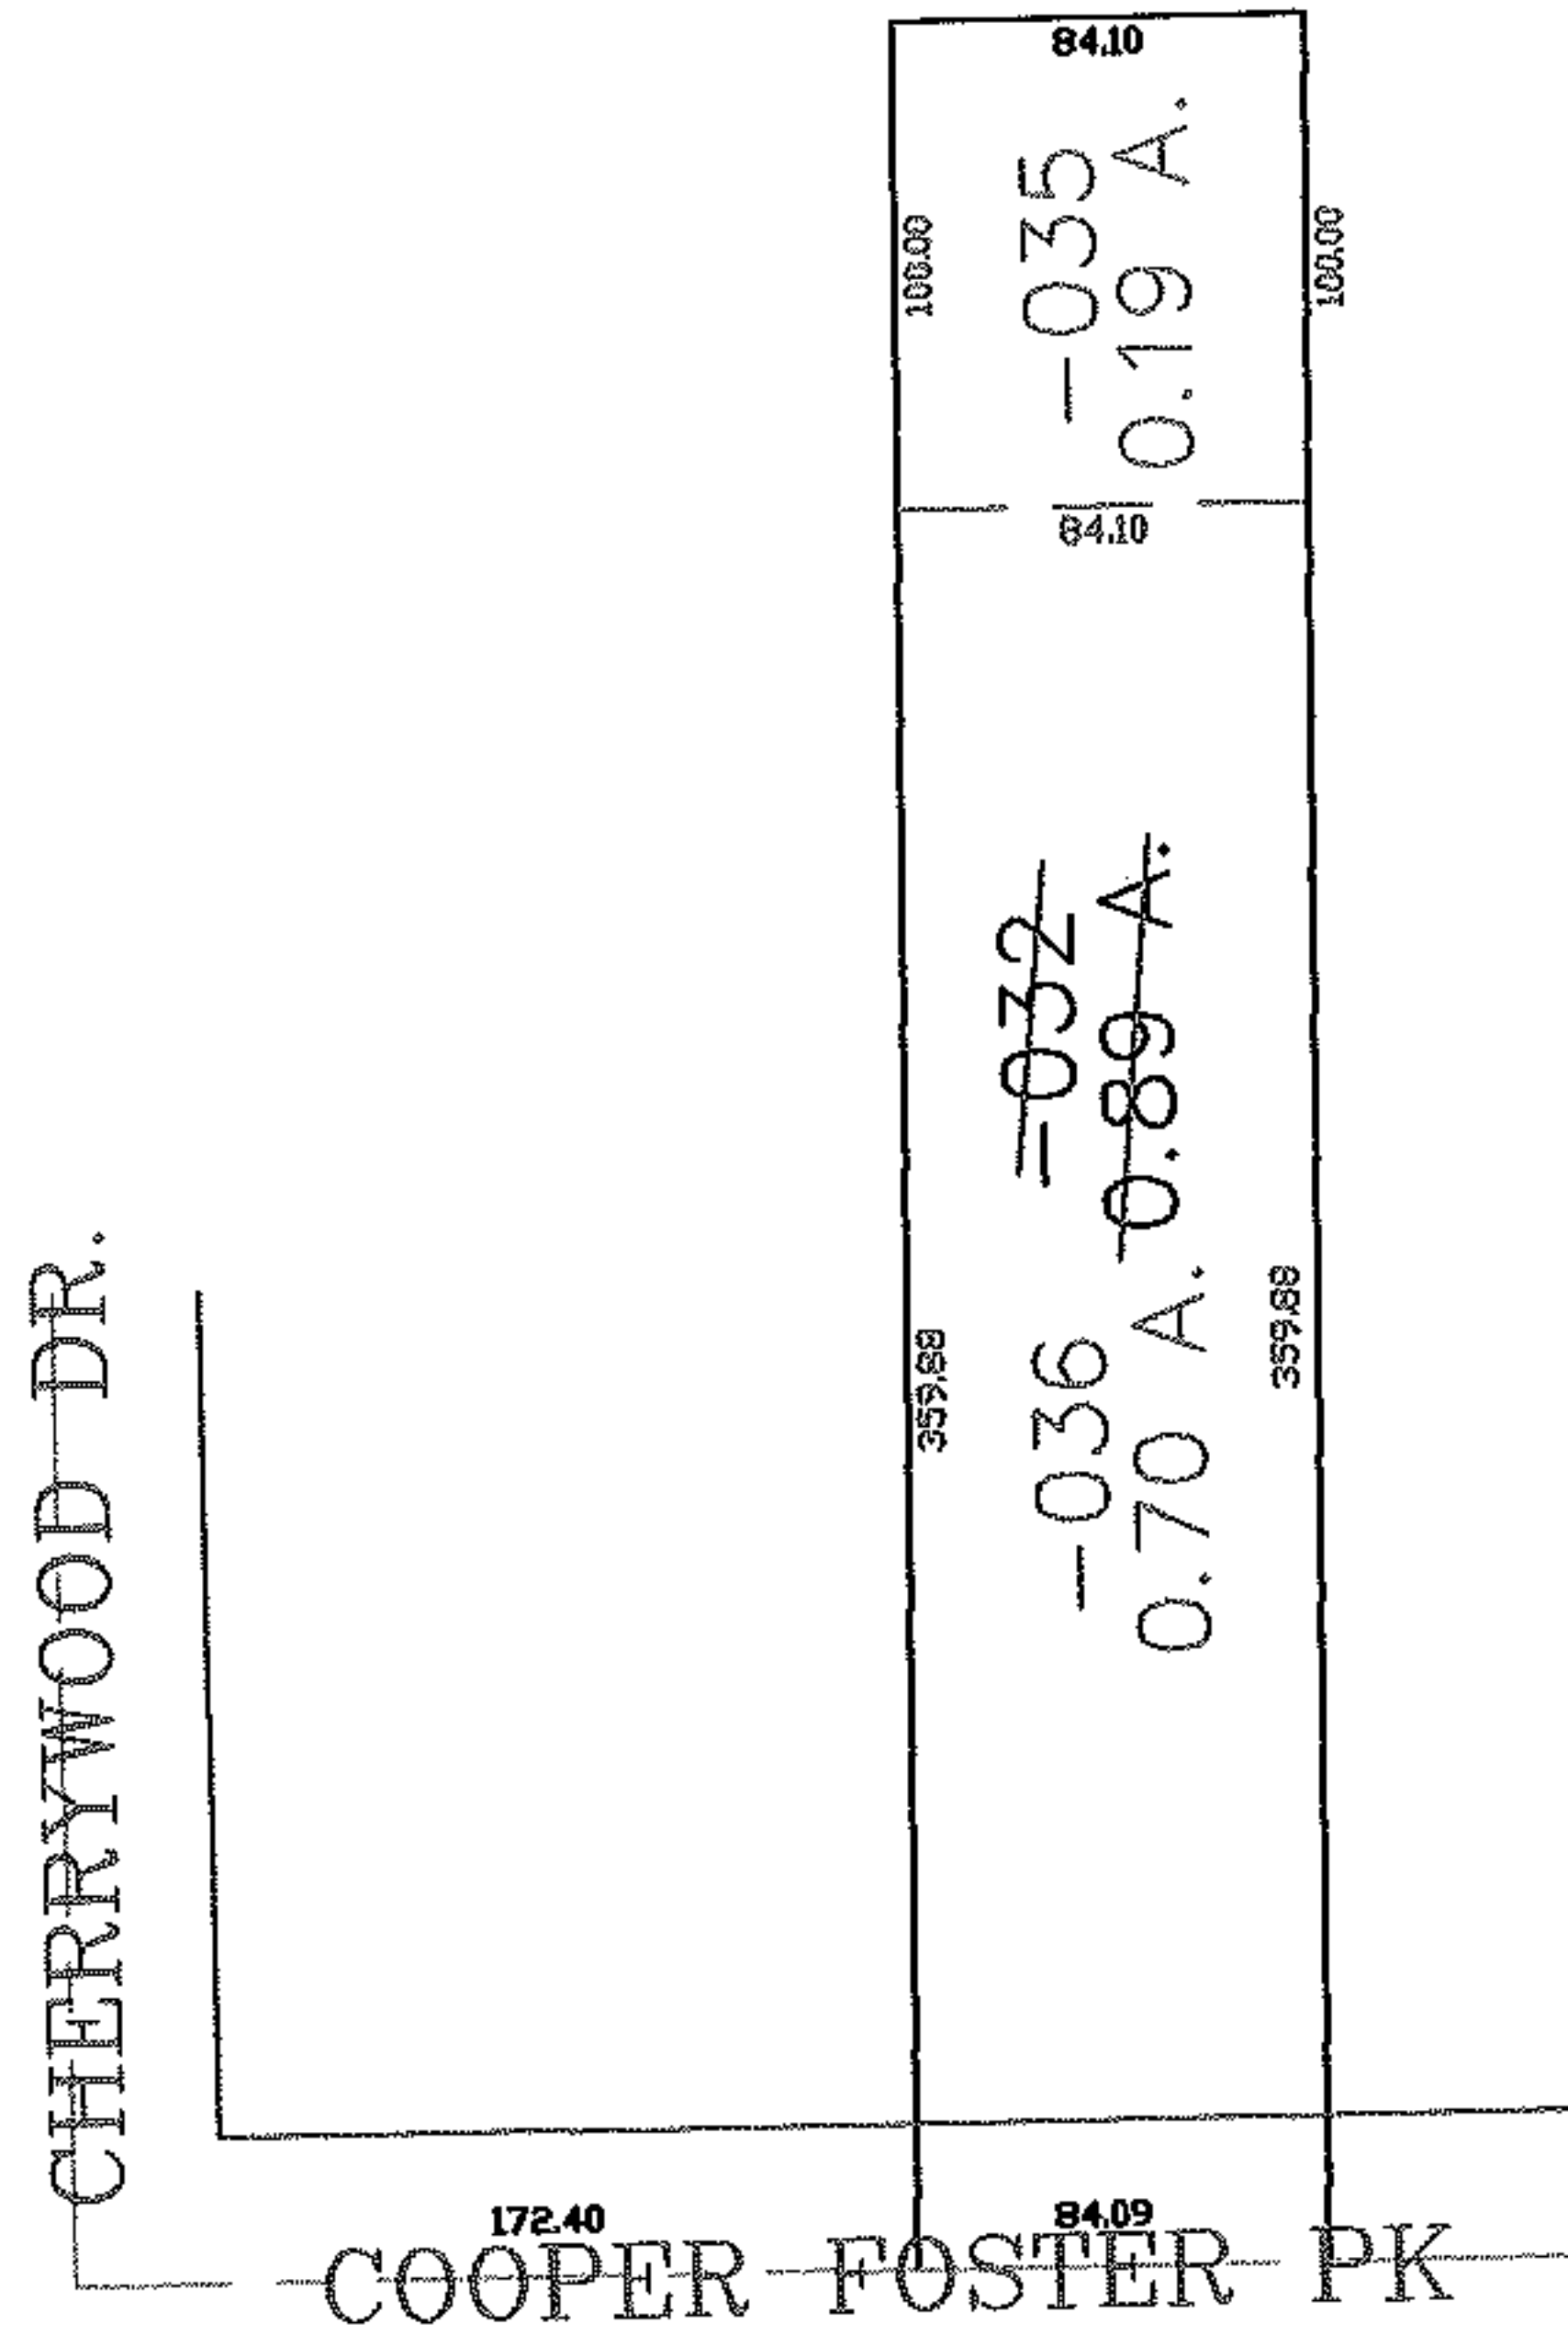


PARENT PARCEL: 02-01-003-270-032

CHILD PARCEL: 02-01-003-270-035, -036

STARTING POINT: CENTERLINE OF CHERRYWOOD DR. & COOPER FOSTER PK RD.

NO. 01987

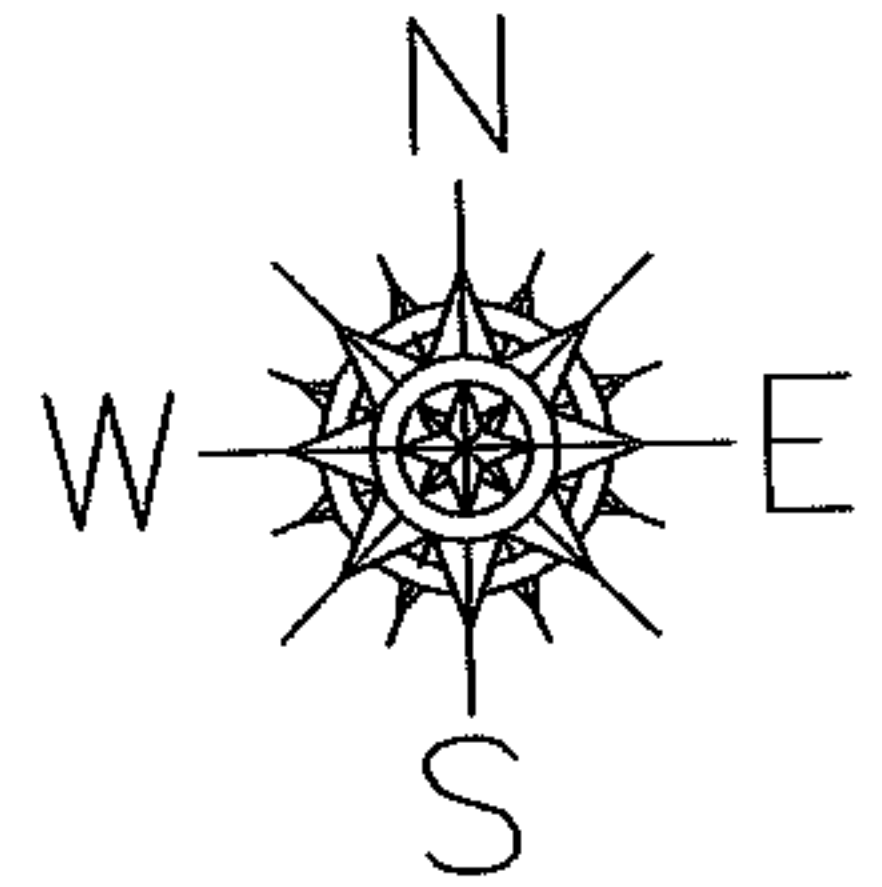

SPLITS/DEEDS PROCESSED

LORAIN COUNTY TAX MAP DEPARTMENT
226 MIDDLE AVE. ELYRIA, OHIO

SURVEYED BY: THOMAS SIMON

CLOSURE: 0.00 : 10.000

MAP PAGE(S): 02-01-003-N

APPROVED BY: JAH DATE: 8-22-05

SCALE: 1" = 100 PRIOR INSTRUMENT: 20030911787