

PARENT PARCEL: 20-05-004-000-004 & -016

CHILD PARCEL: 20-05-004-000-017

STARTING POINT: WEST LINE OF O.L. 3 & CL OF BURSLEY RD.

10-01988-C

COMBINATION

~~20-05-004-000-004~~

~~7.00 A.~~

~~20-05-004-000-016~~

~~13.95 A.~~

20-05-004-000-017



~~20.95 A.~~

20.88 A.

COMBINATION & AC. CORR.

PER DEED

INST. # 20010746791

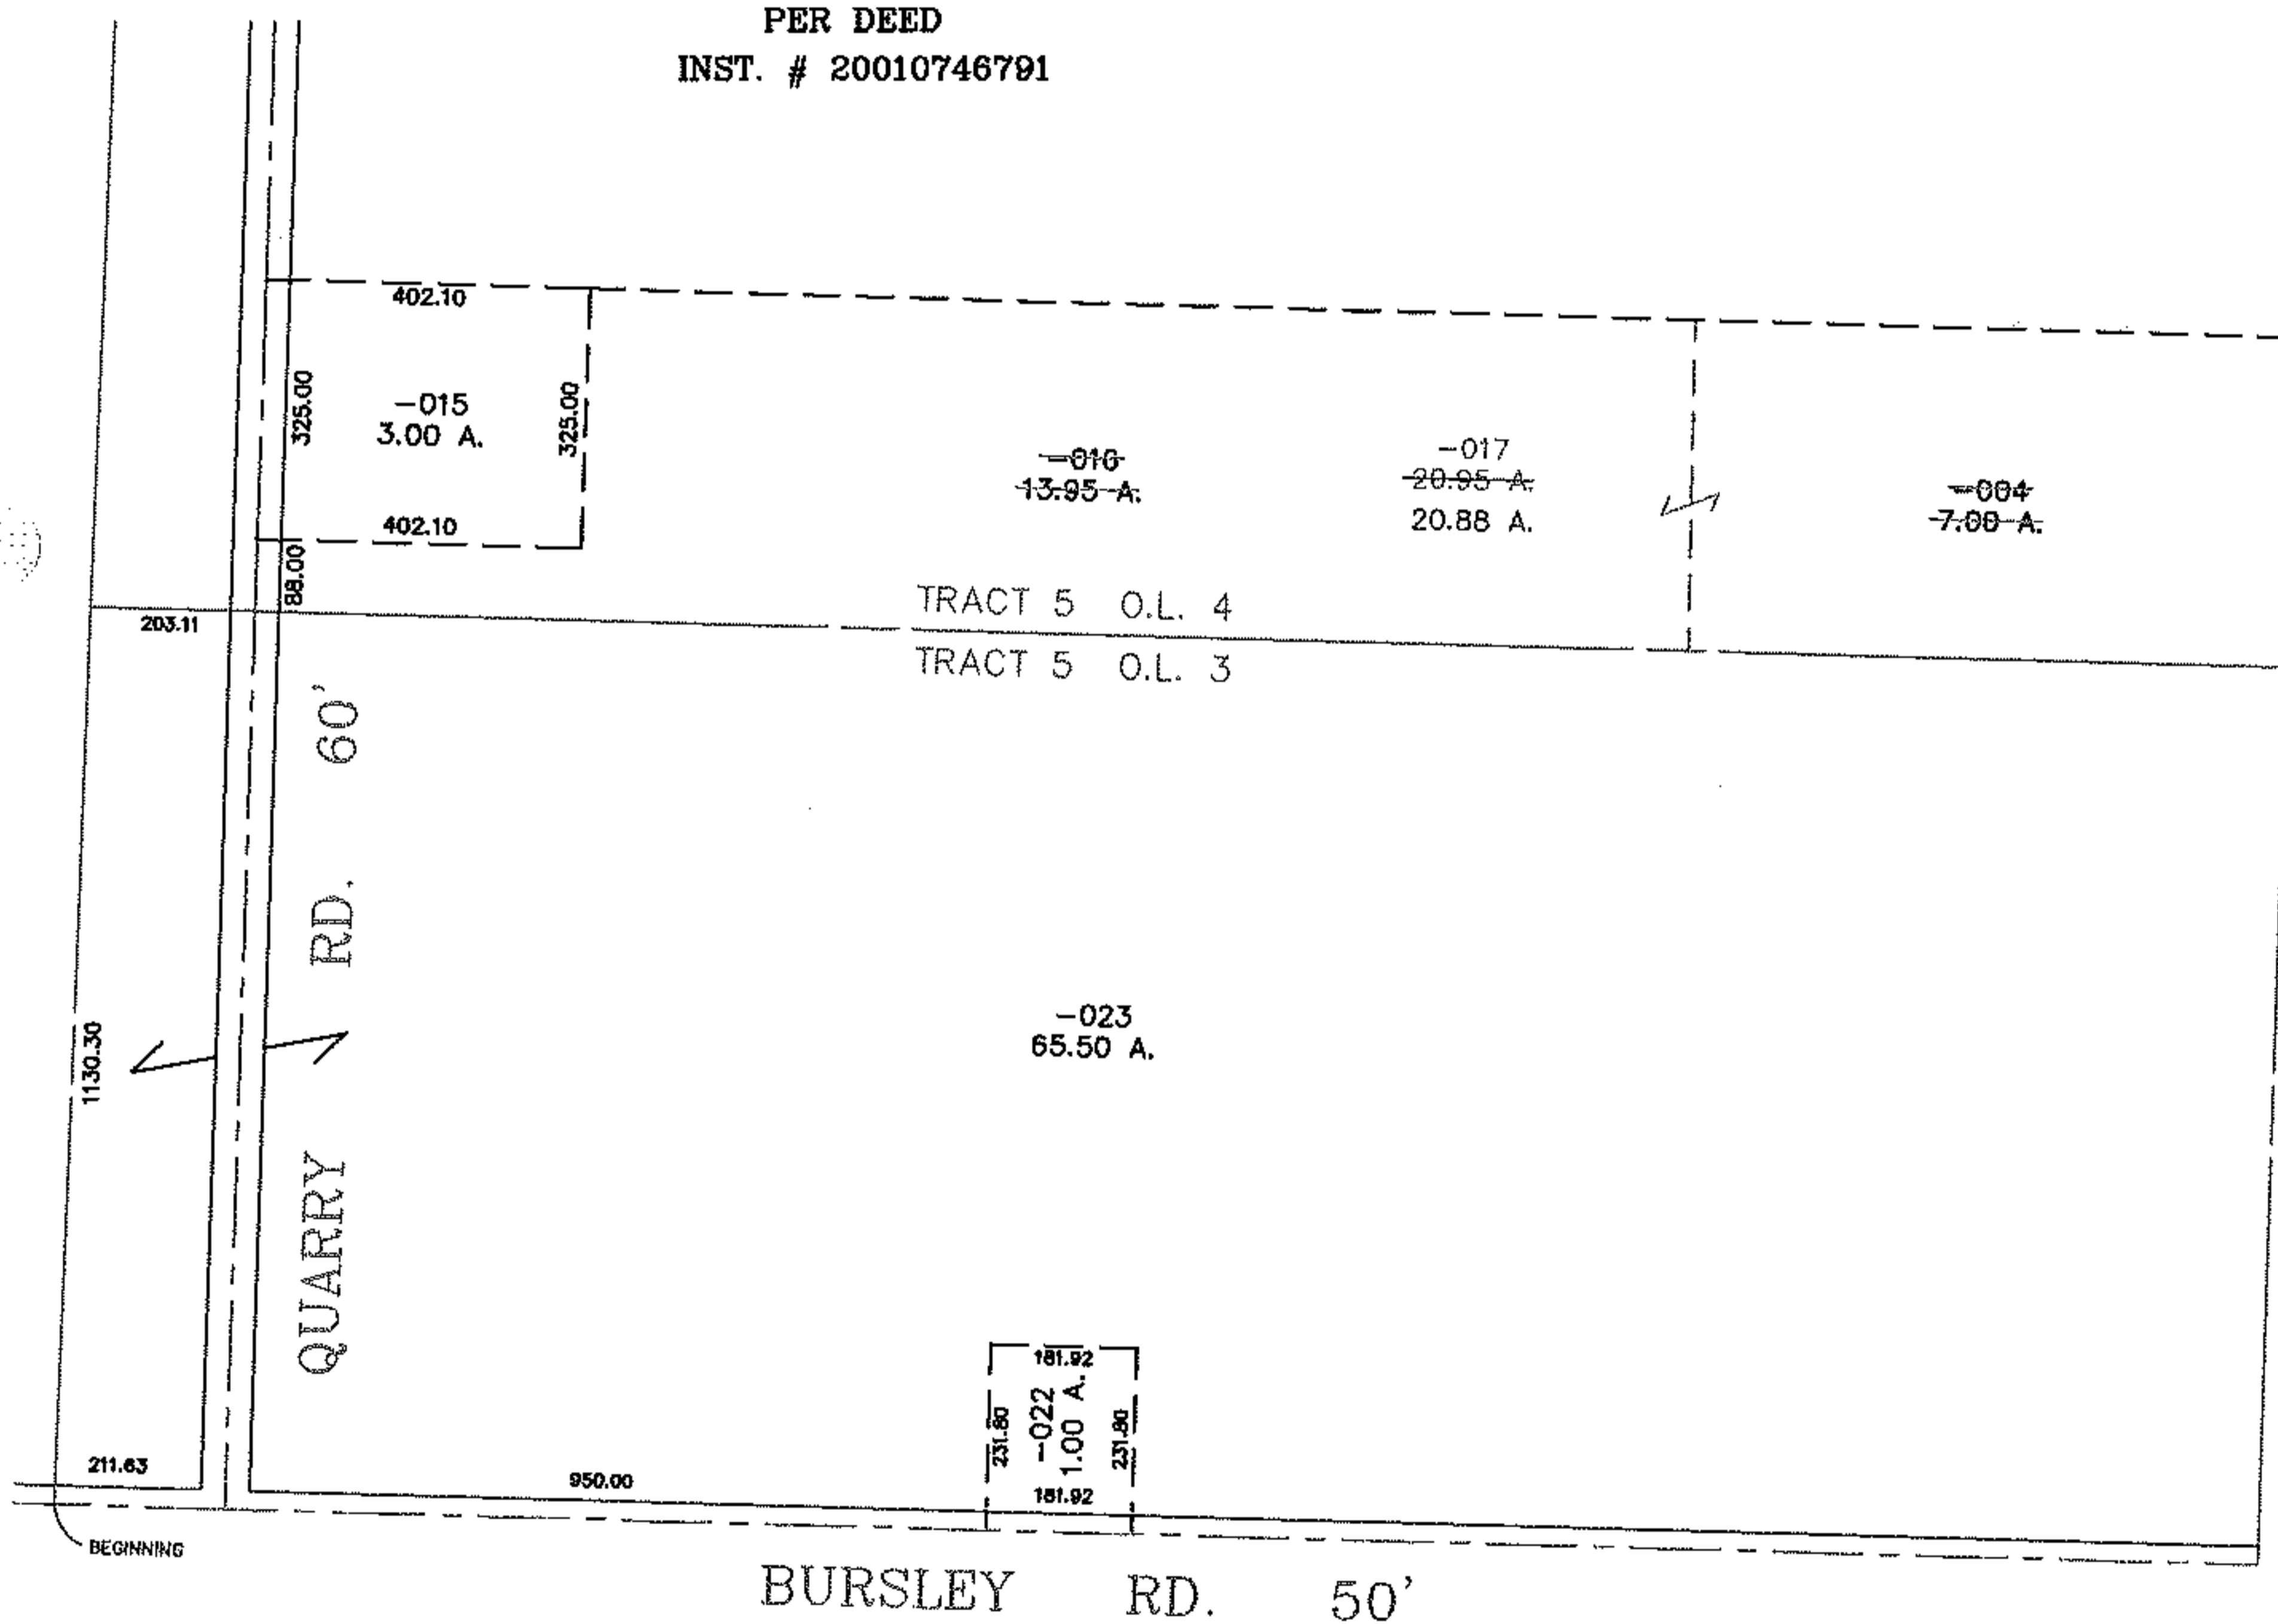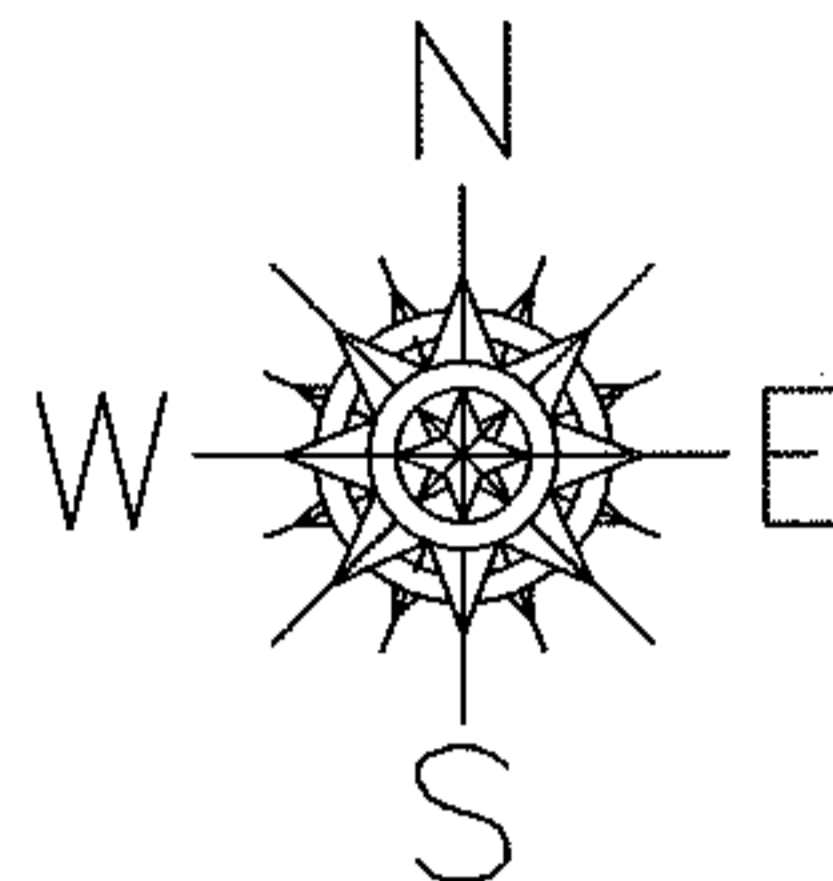

SPLITS/DEEDS PROCESSED

LORAIN COUNTY TAX MAP DEPARTMENT
226 MIDDLE AVE. ELYRIA, OHIO

SURVEYED BY: NONE

CLOSURE: NONE

MAP PAGE(S): 20-D

APPROVED BY: TJS DATE: 3/18/10

SCALE: 1" = 400 PRIOR INST.: DV 1367/31