
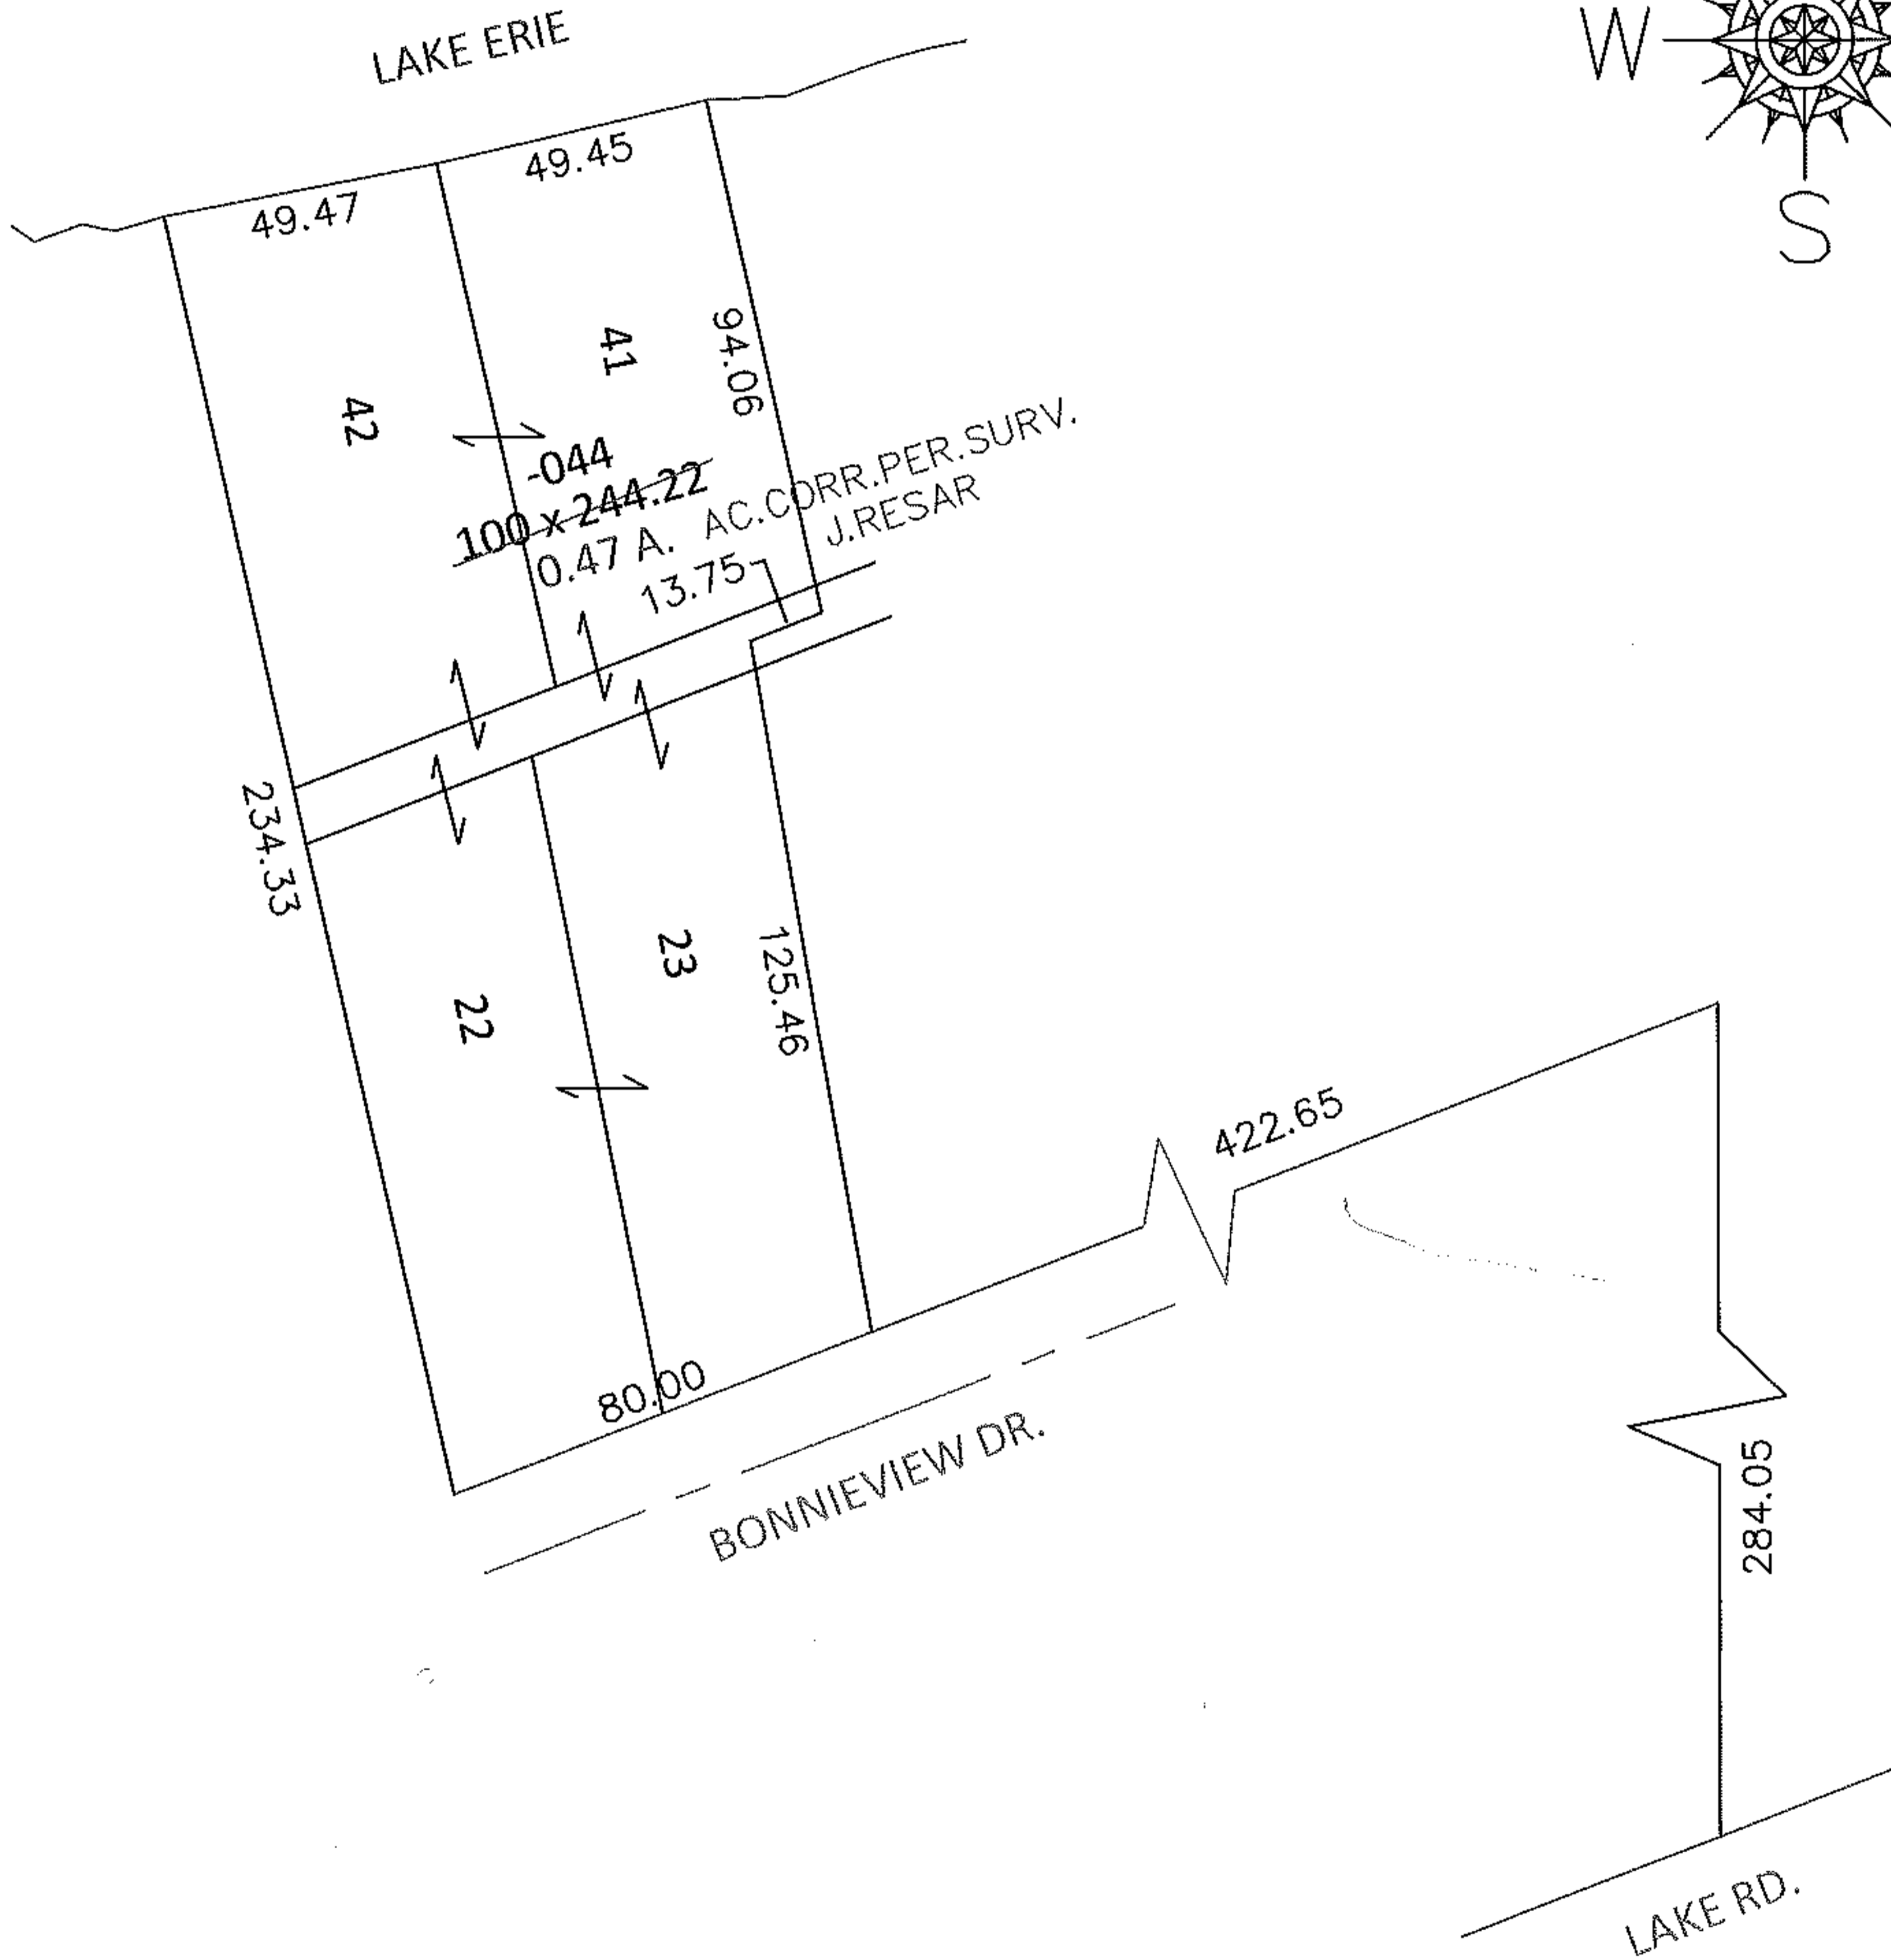


PARENT PARCEL: 04-00-007-101-044


CHILD PARCEL: _____

10-01990-D

STARTING POINT: INTERSECTION OF NORTH R.O.W. LINE OF LAKE RD. AND EAST LINE OF PARCEL CONVEYED TO EDWARD J. CUYLER DV 46/525

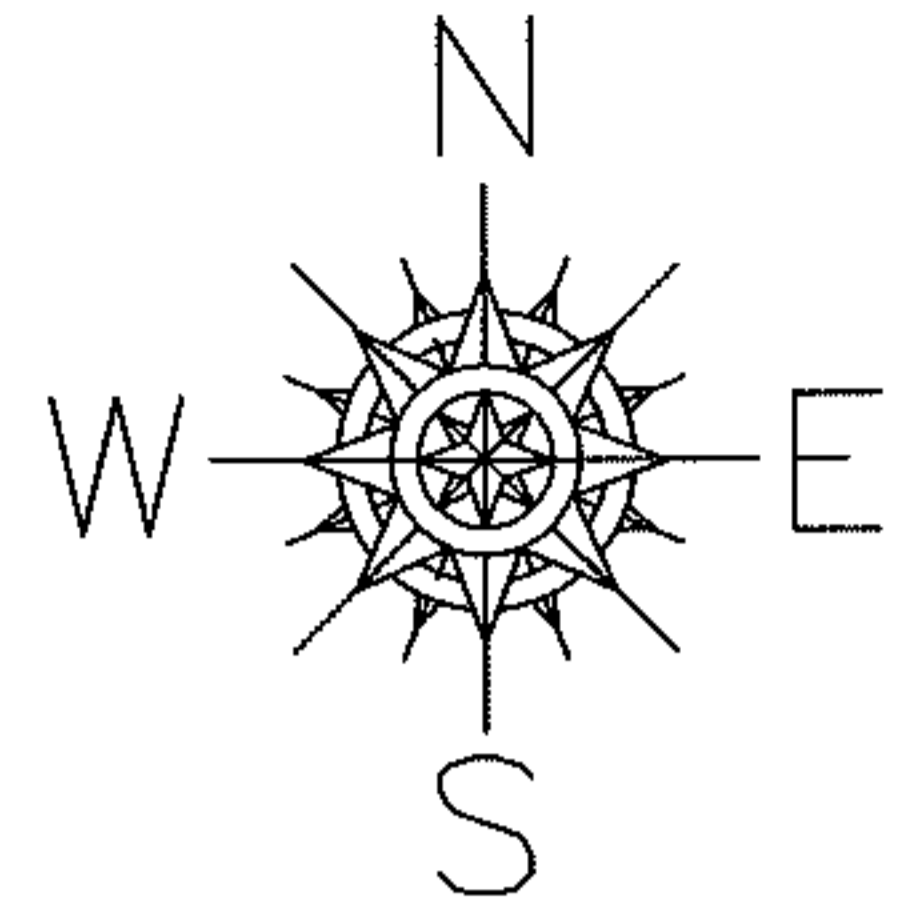

*DV 1048/368
*DV 1177/513

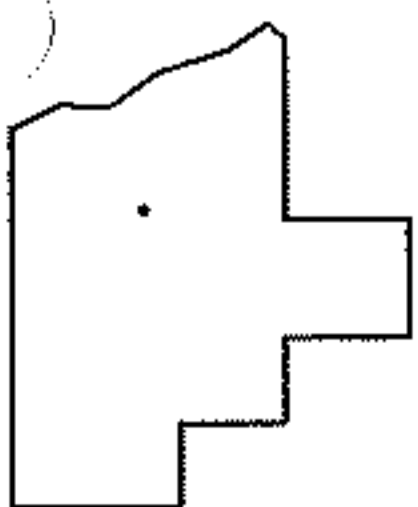

SPLITS/DEEDS PROCESSED

LORAIN COUNTY TAX MAP DEPARTMENT
226 MIDDLE AVE. ELYRIA, OHIO

SURVEYED BY: JAMES A. RESAR
CLOSURE: .01:10,000
MAP PAGE(S): 4-00-007-A
APPROVED BY: RRM DATE: 3-24-10
SCALE: 1"= 50 PRIOR INST.: * SEE ABOVE

RASTER