

PARENT PARCEL: 09-00-086-103-027

CHILD PARCEL: XX-XX-XXX-XXX-XXX

STARTING POINT: DRILL HOLE FD., NORTH R.O.W. OF GROVELAND &  
WEST R.O.W. OF S. PLEASANT ST.

10-01991-C



### FRONTAGE CORRECTION

09-00-086-103-027

~~47.70 X 170.00~~

47.61 X 170.00

CORR. PER SURV.  
DALE R. HAYWOOD

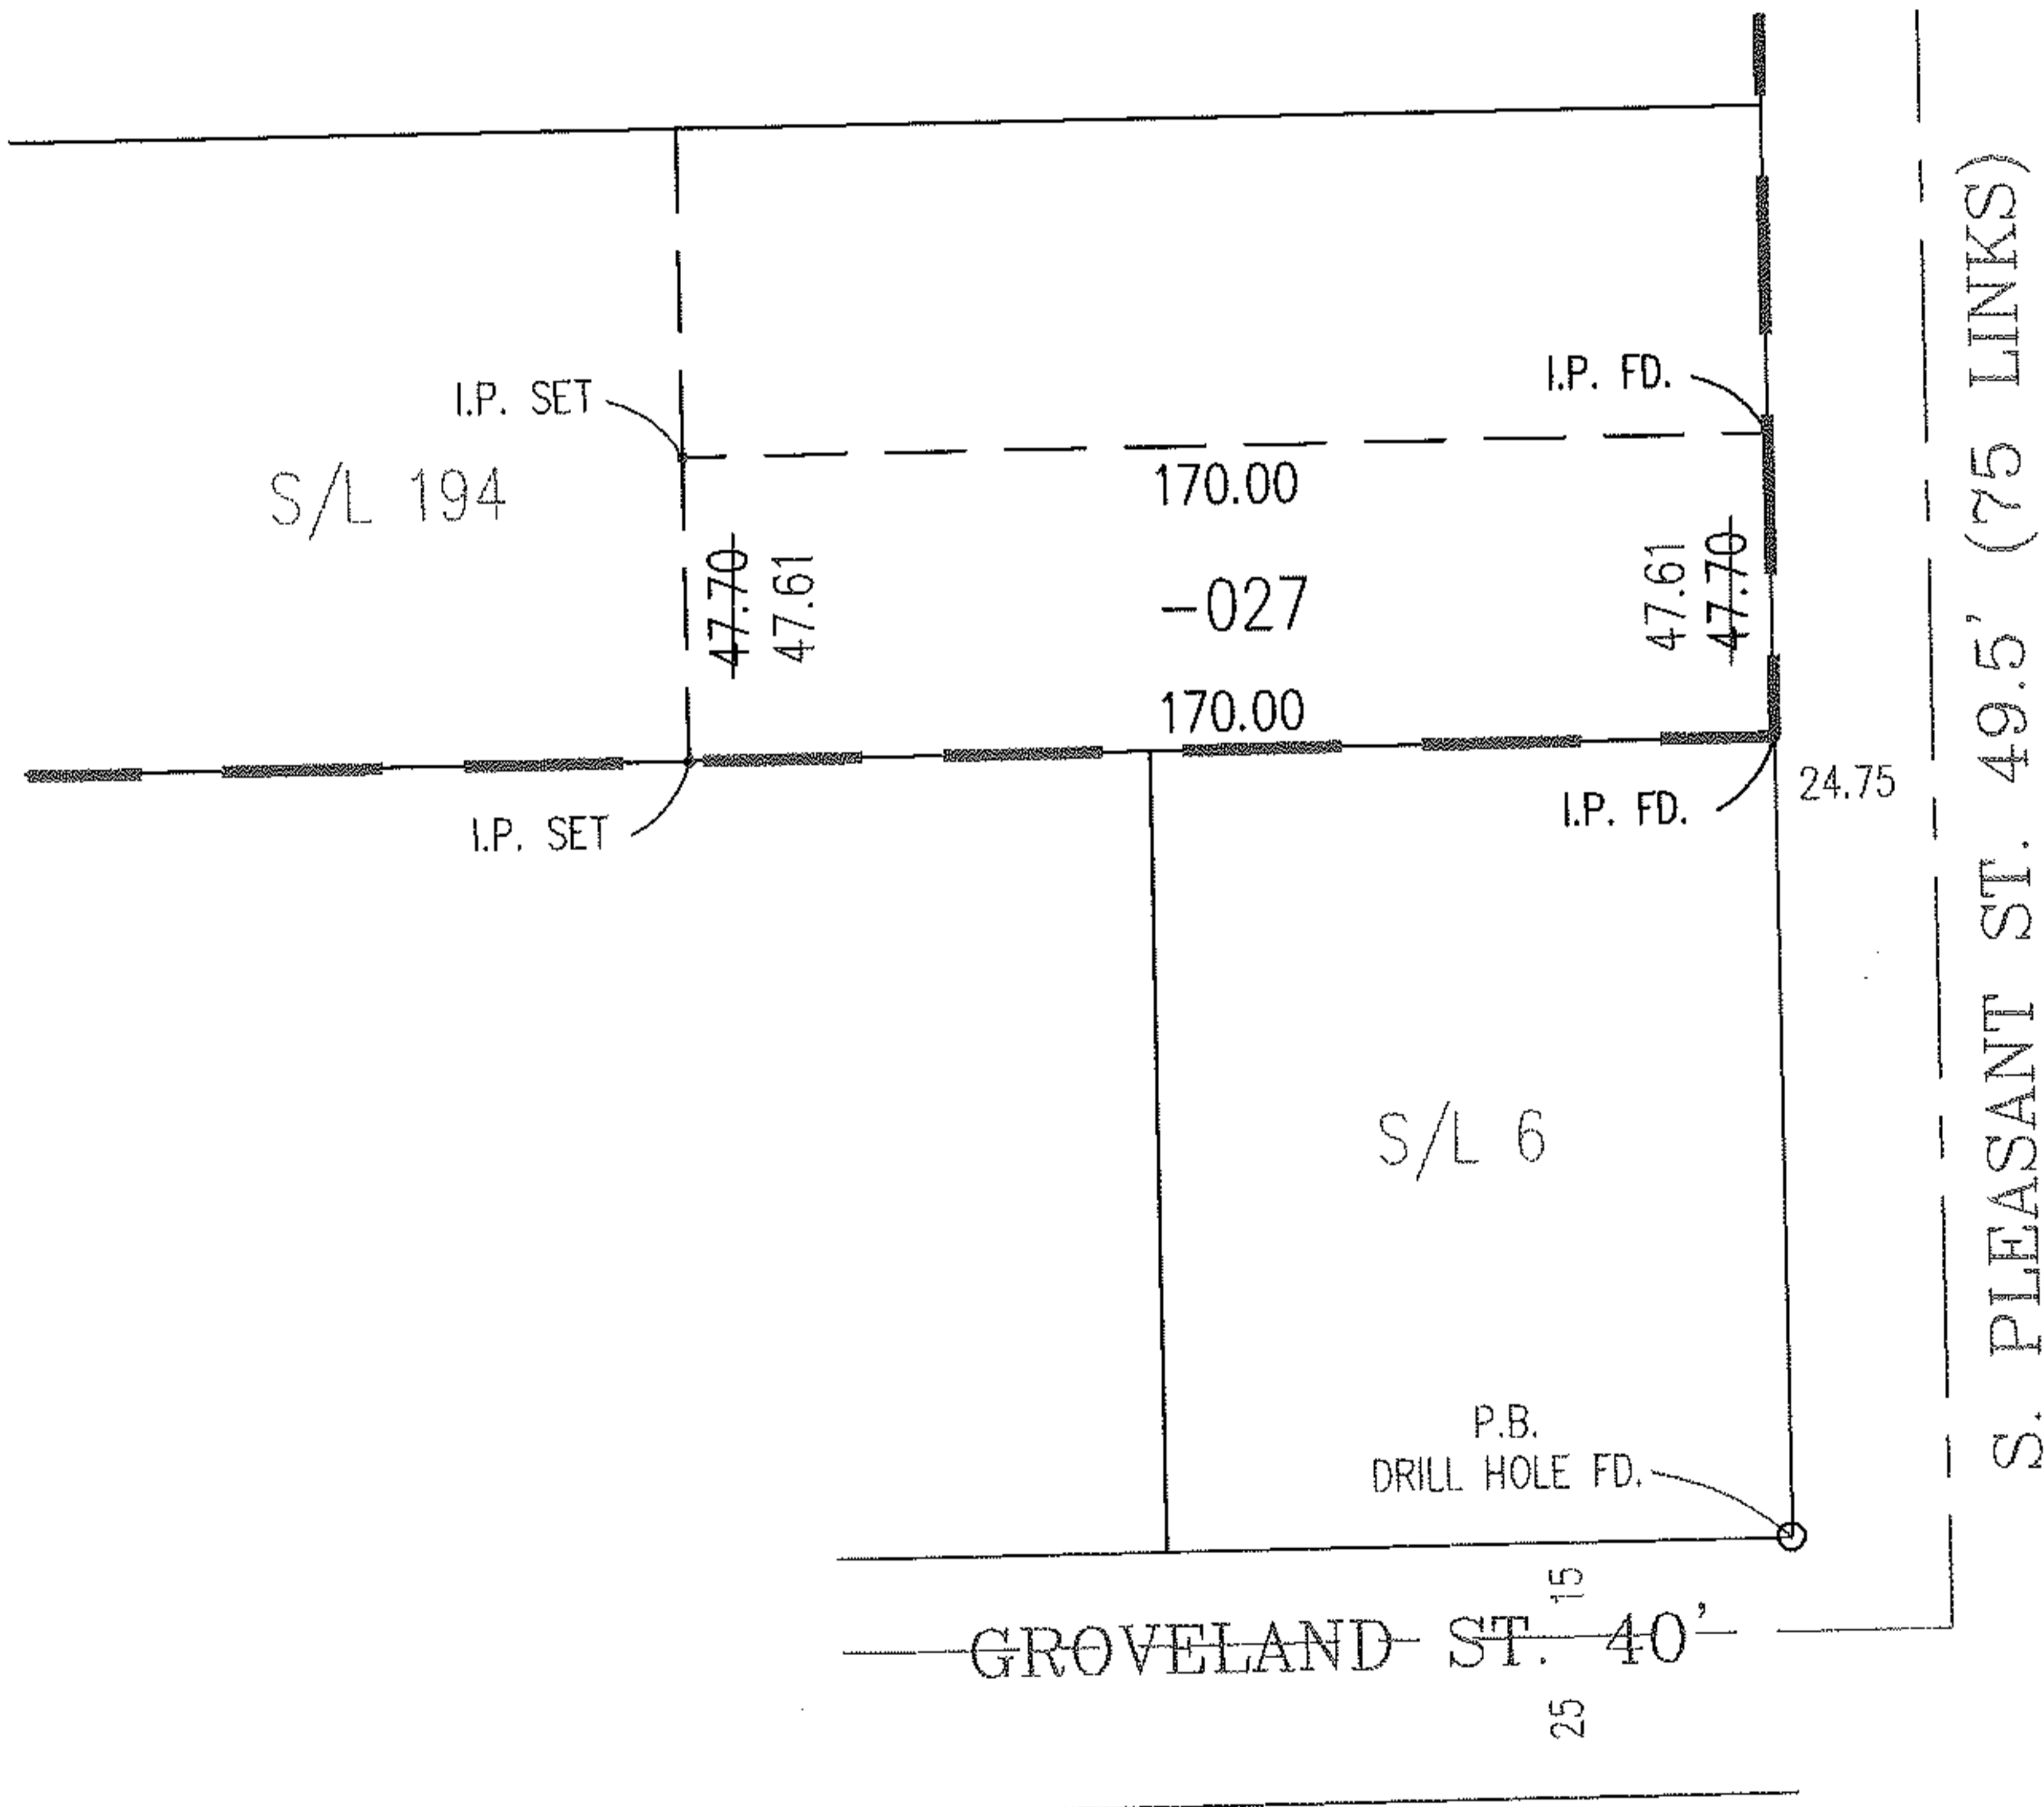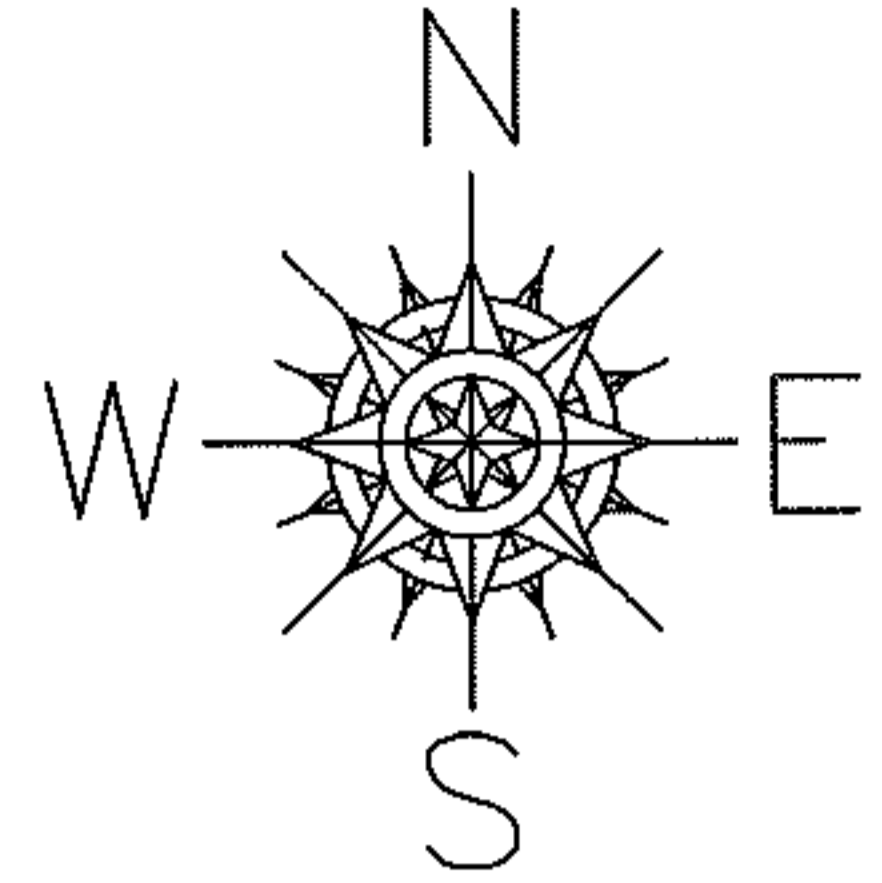

### SPLITS/DEEDS PROCESSED

LORAIN COUNTY TAX MAP DEPARTMENT  
226 MIDDLE AVE. ELYRIA, OHIO

SURVEYED BY: DALE R. HAYWOOD

CLOSURE: 0.00 : 10,000

MAP PAGE(S): 9-00-086-A

APPROVED BY: TJS DATE: 3/23/10

SCALE: 1"= 50' PRIOR INST.: 20090294720

*RAS 3/23/10*