




RASTER

PARENT PARCEL: 07-00-030-000-021, -022, -009 07-00-031-000-033, -034
CHILD PARCEL: 07-00-030-000-090 THRU -094 07-00-031-000-120
STARTING POINT: CENTERLINE OF AVON-BELDEN RD. & O.L. 30

NO. 01992

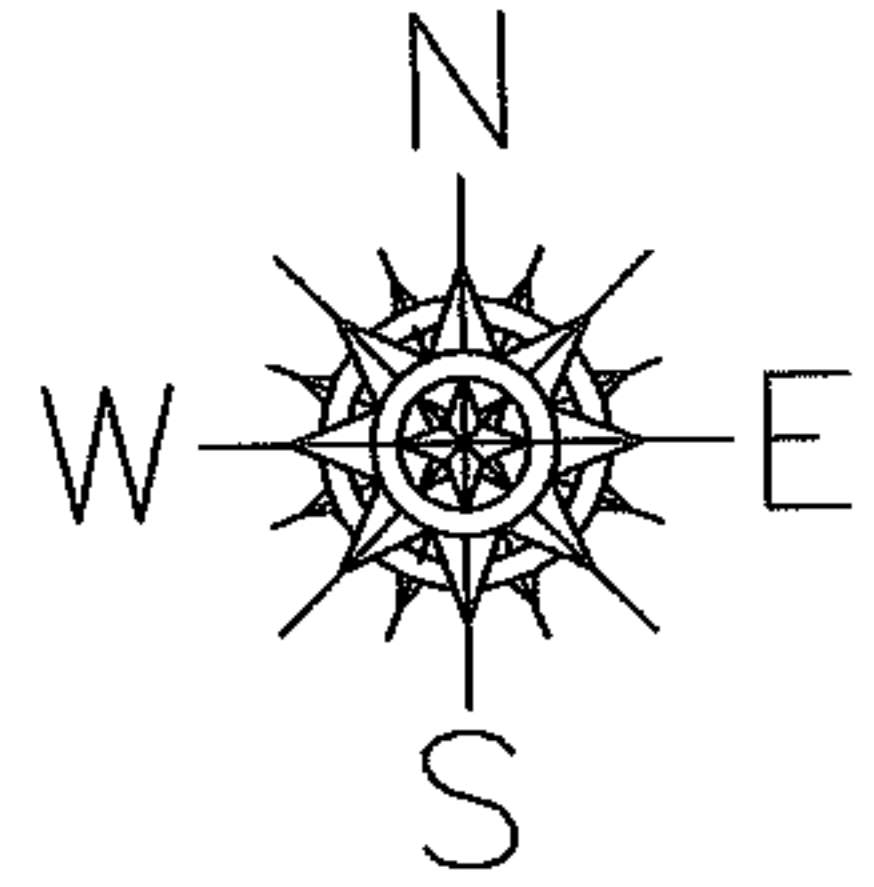

PLOT 1" = 100'

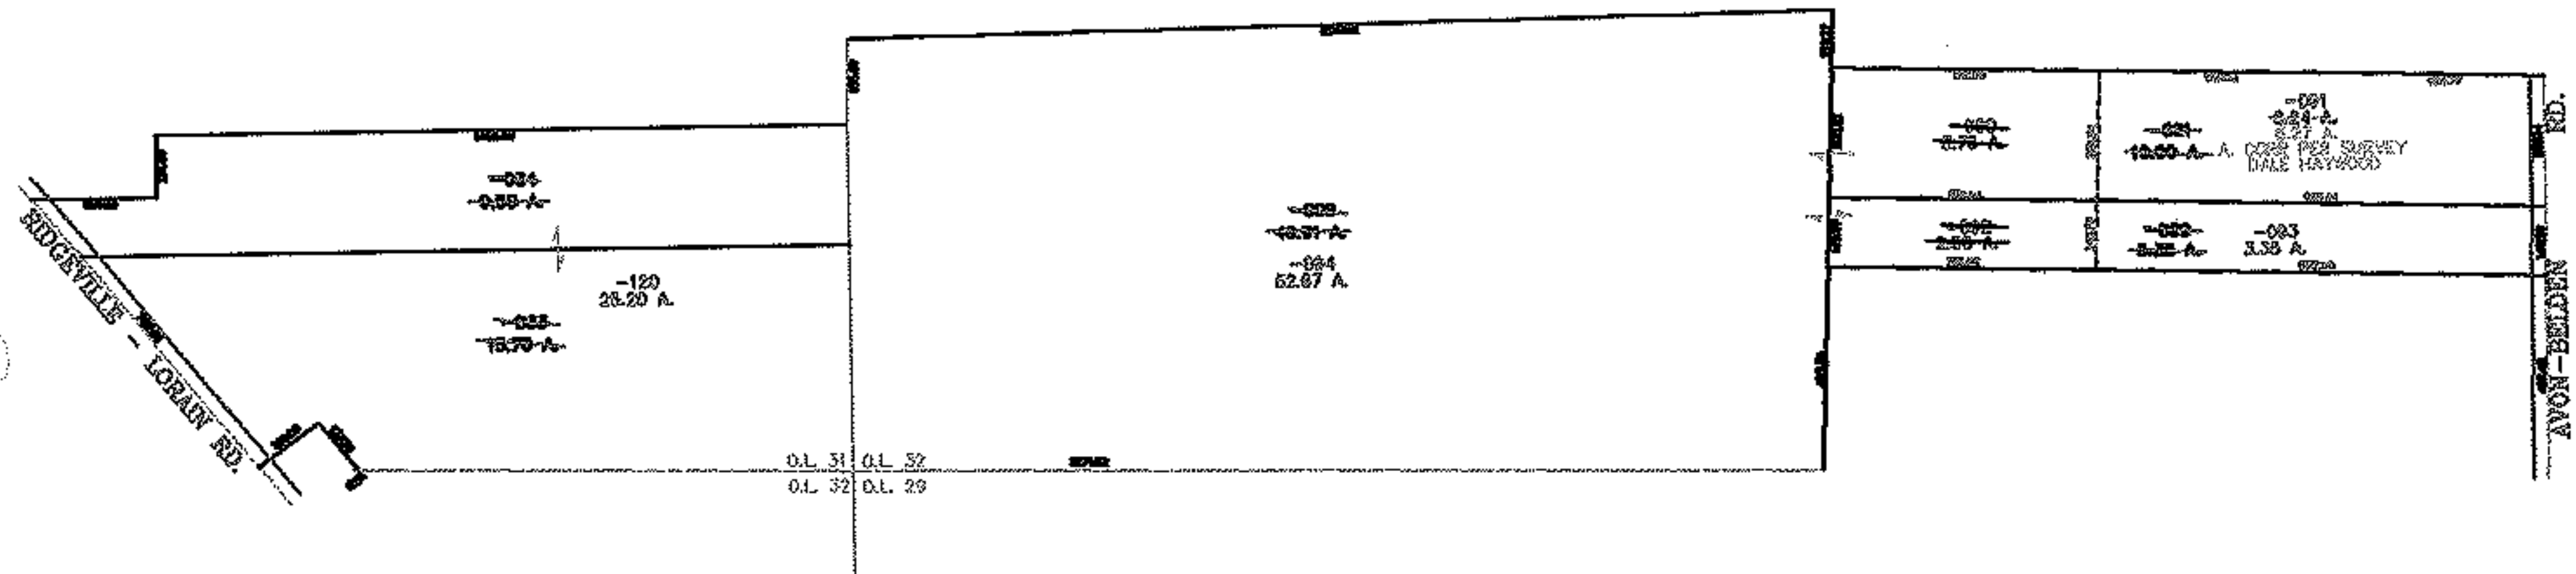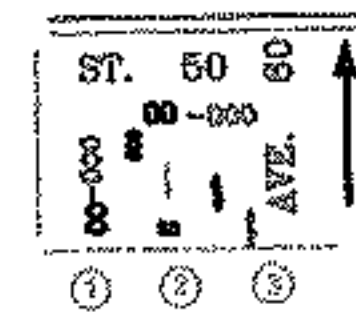

SURVEYED BY: DALE HAYWOOD
CLOSURE: 0.00 : 10.000
MAP PAGE(S): 07-00-030-C, D
APPROVED BY: JAH DATE: 8-31-05
SCALE: 1" = 750' PRIOR INSTRUMENT: DV 1338/688

SPLITS/DEEDS PROCESSED

LORAIN COUNTY TAX MAP DEPARTMENT
226 MIDDLE AVE. ELYRIA, OHIO

