
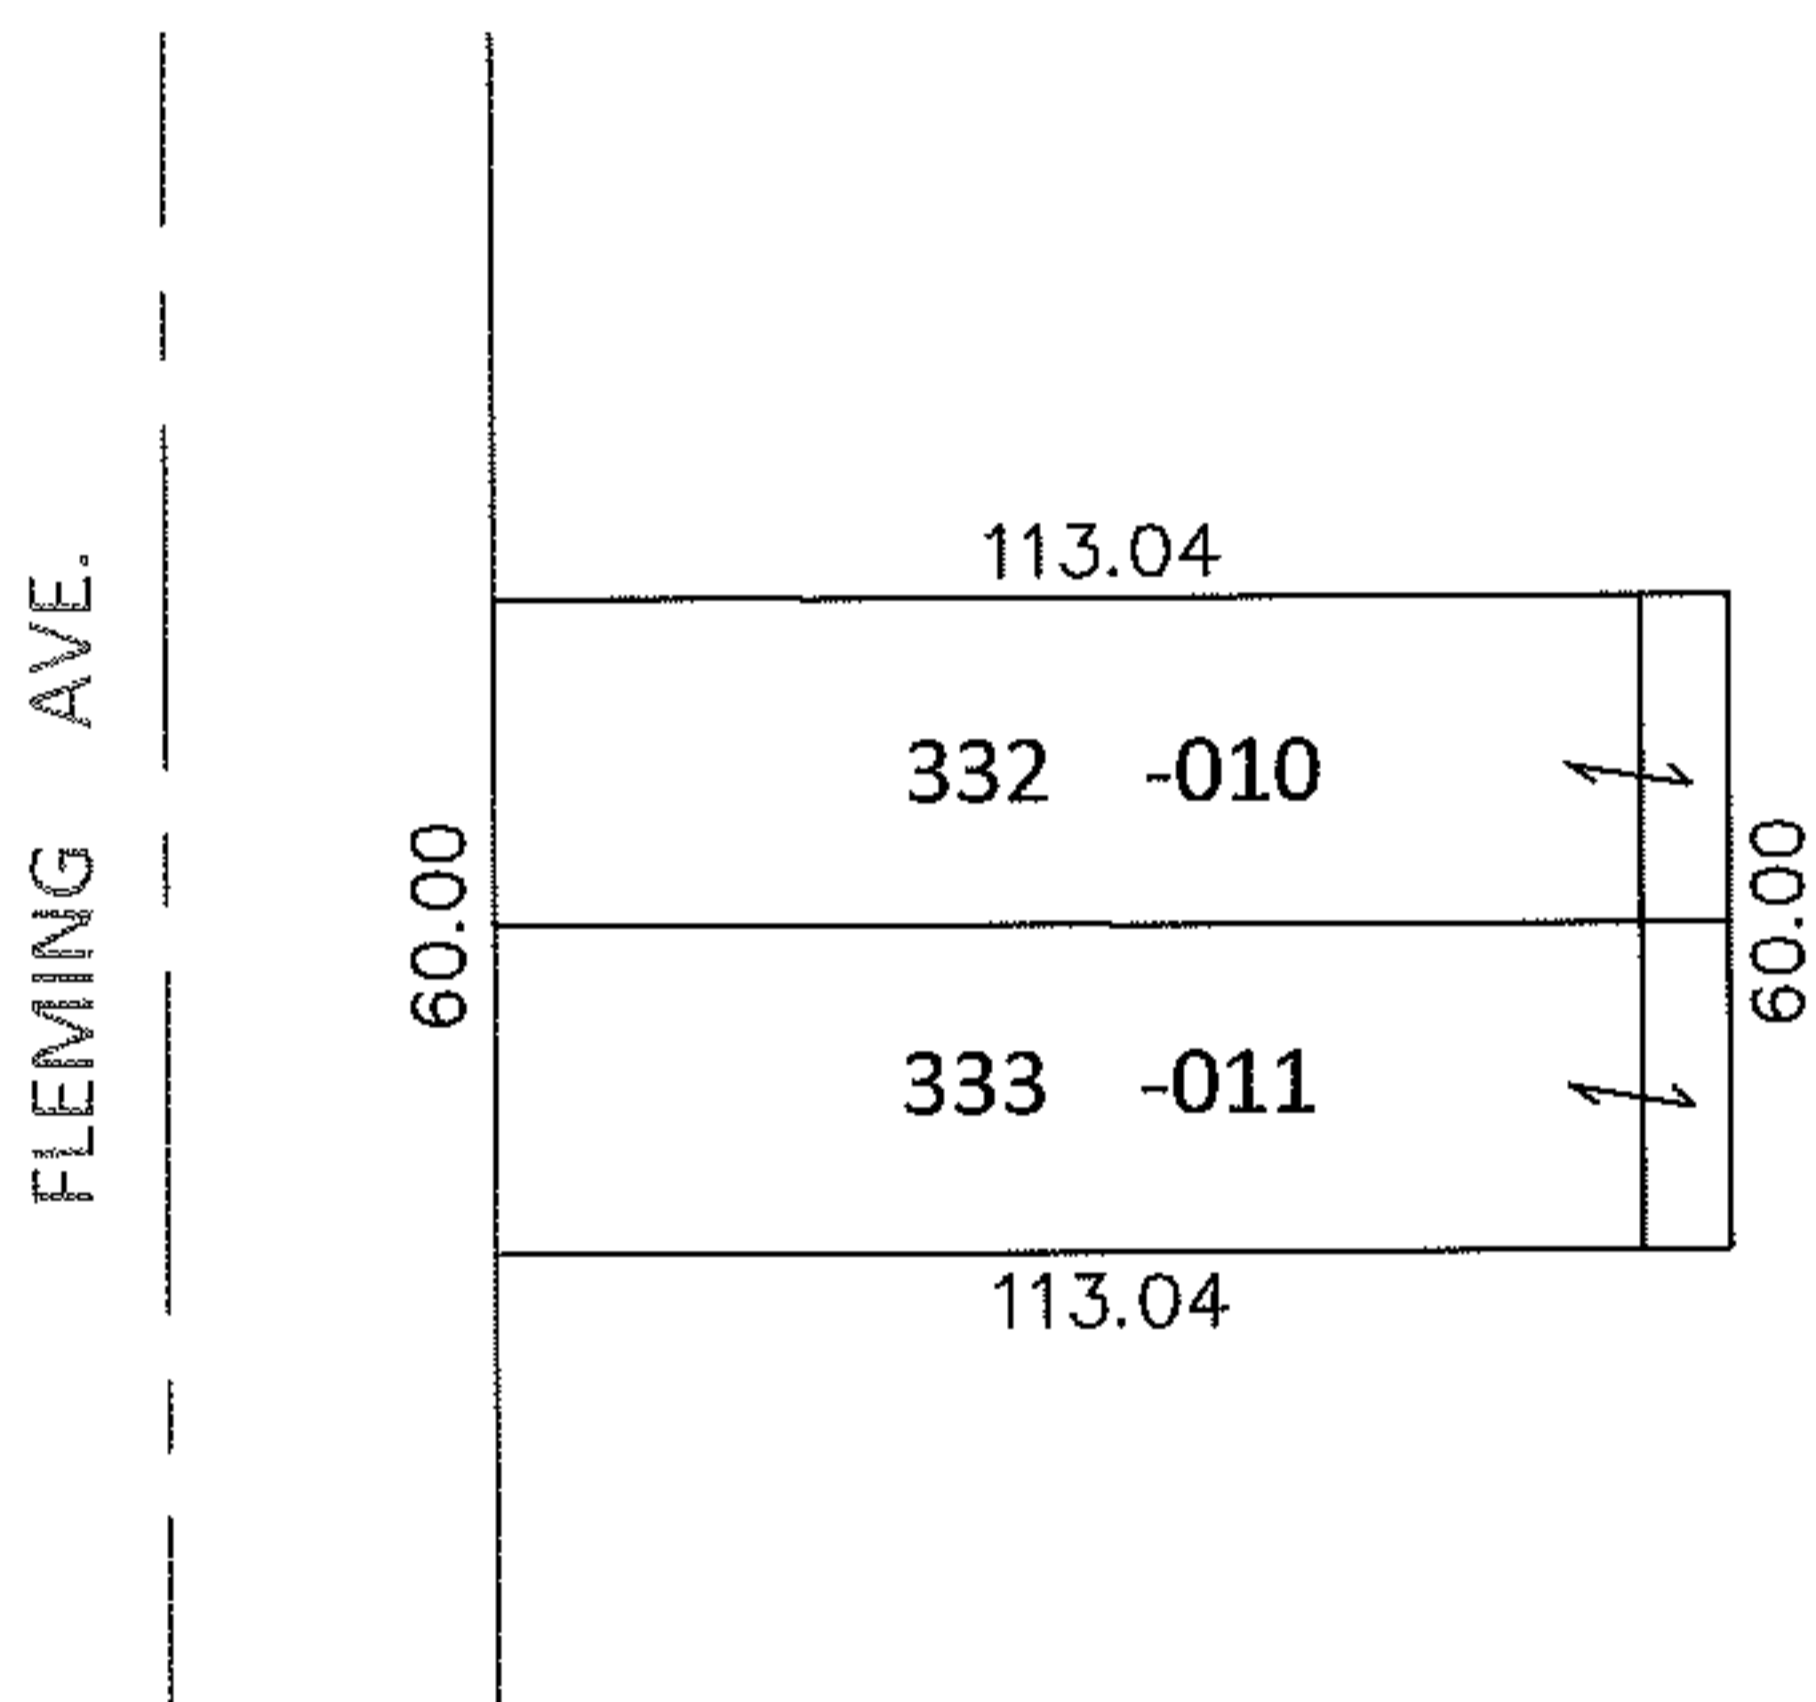


PARENT PARCEL: 03-00-075-108-010, -011

CHILD PARCEL: \_\_\_\_\_

STARTING POINT: NORTHWEST CORNER OF S/L 332 IN LIBERTY SUB. (VOL.9 PG.26)

10-01993-C

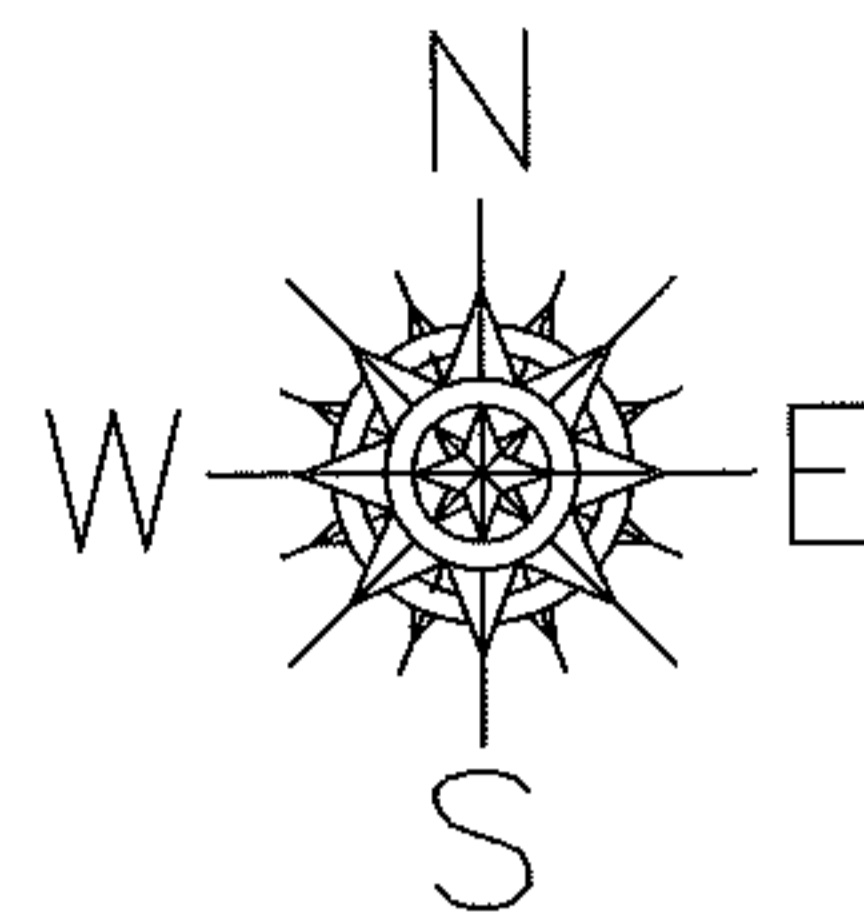

**DEPTH CORRECTION**

03-00-075-108-010

30 X 113.04 DEPTH CORR.PER.SURV.  
~~30 X 105~~ J.YURKSCHATT

03-00-075-108-011

30 X 113.04 DEPTH CORR.PER.SURV.  
~~30 X 105~~ J.YURKSCHATT

**SPLITS/DEEDS PROCESSED**

LORAIN COUNTY TAX MAP DEPARTMENT  
226 MIDDLE AVE. ELYRIA, OHIO

SURVEYED BY: JAMES P. YURKSCHATT

CLOSURE: .00:10,000

MAP PAGE(S): 3-00-075-A

APPROVED BY: RRM DATE: 3-31-10

SCALE: 1"= 50 PRIOR INST.: 20090314995

*Rosen*