


PARENT PARCEL: 07-00-002-102-128

CHILD PARCEL: 07-00-002-102-219,-220


STARTING POINT: NORTHWEST CORNER OF S/L 236 IN RIDGEFIELD HOMES SUB. NO.4

05-01996

RIDGEFIELD HOMES SUB. NO 4
VOL.63 PGS.48-51

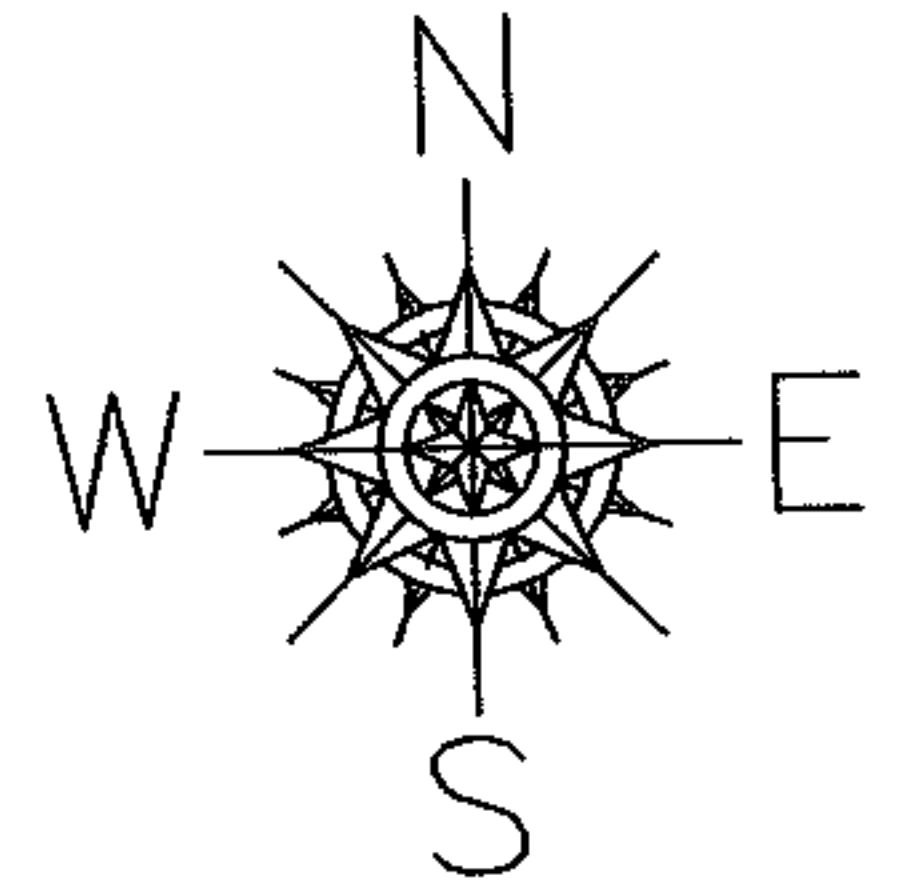

TIMBER EDGE DR.

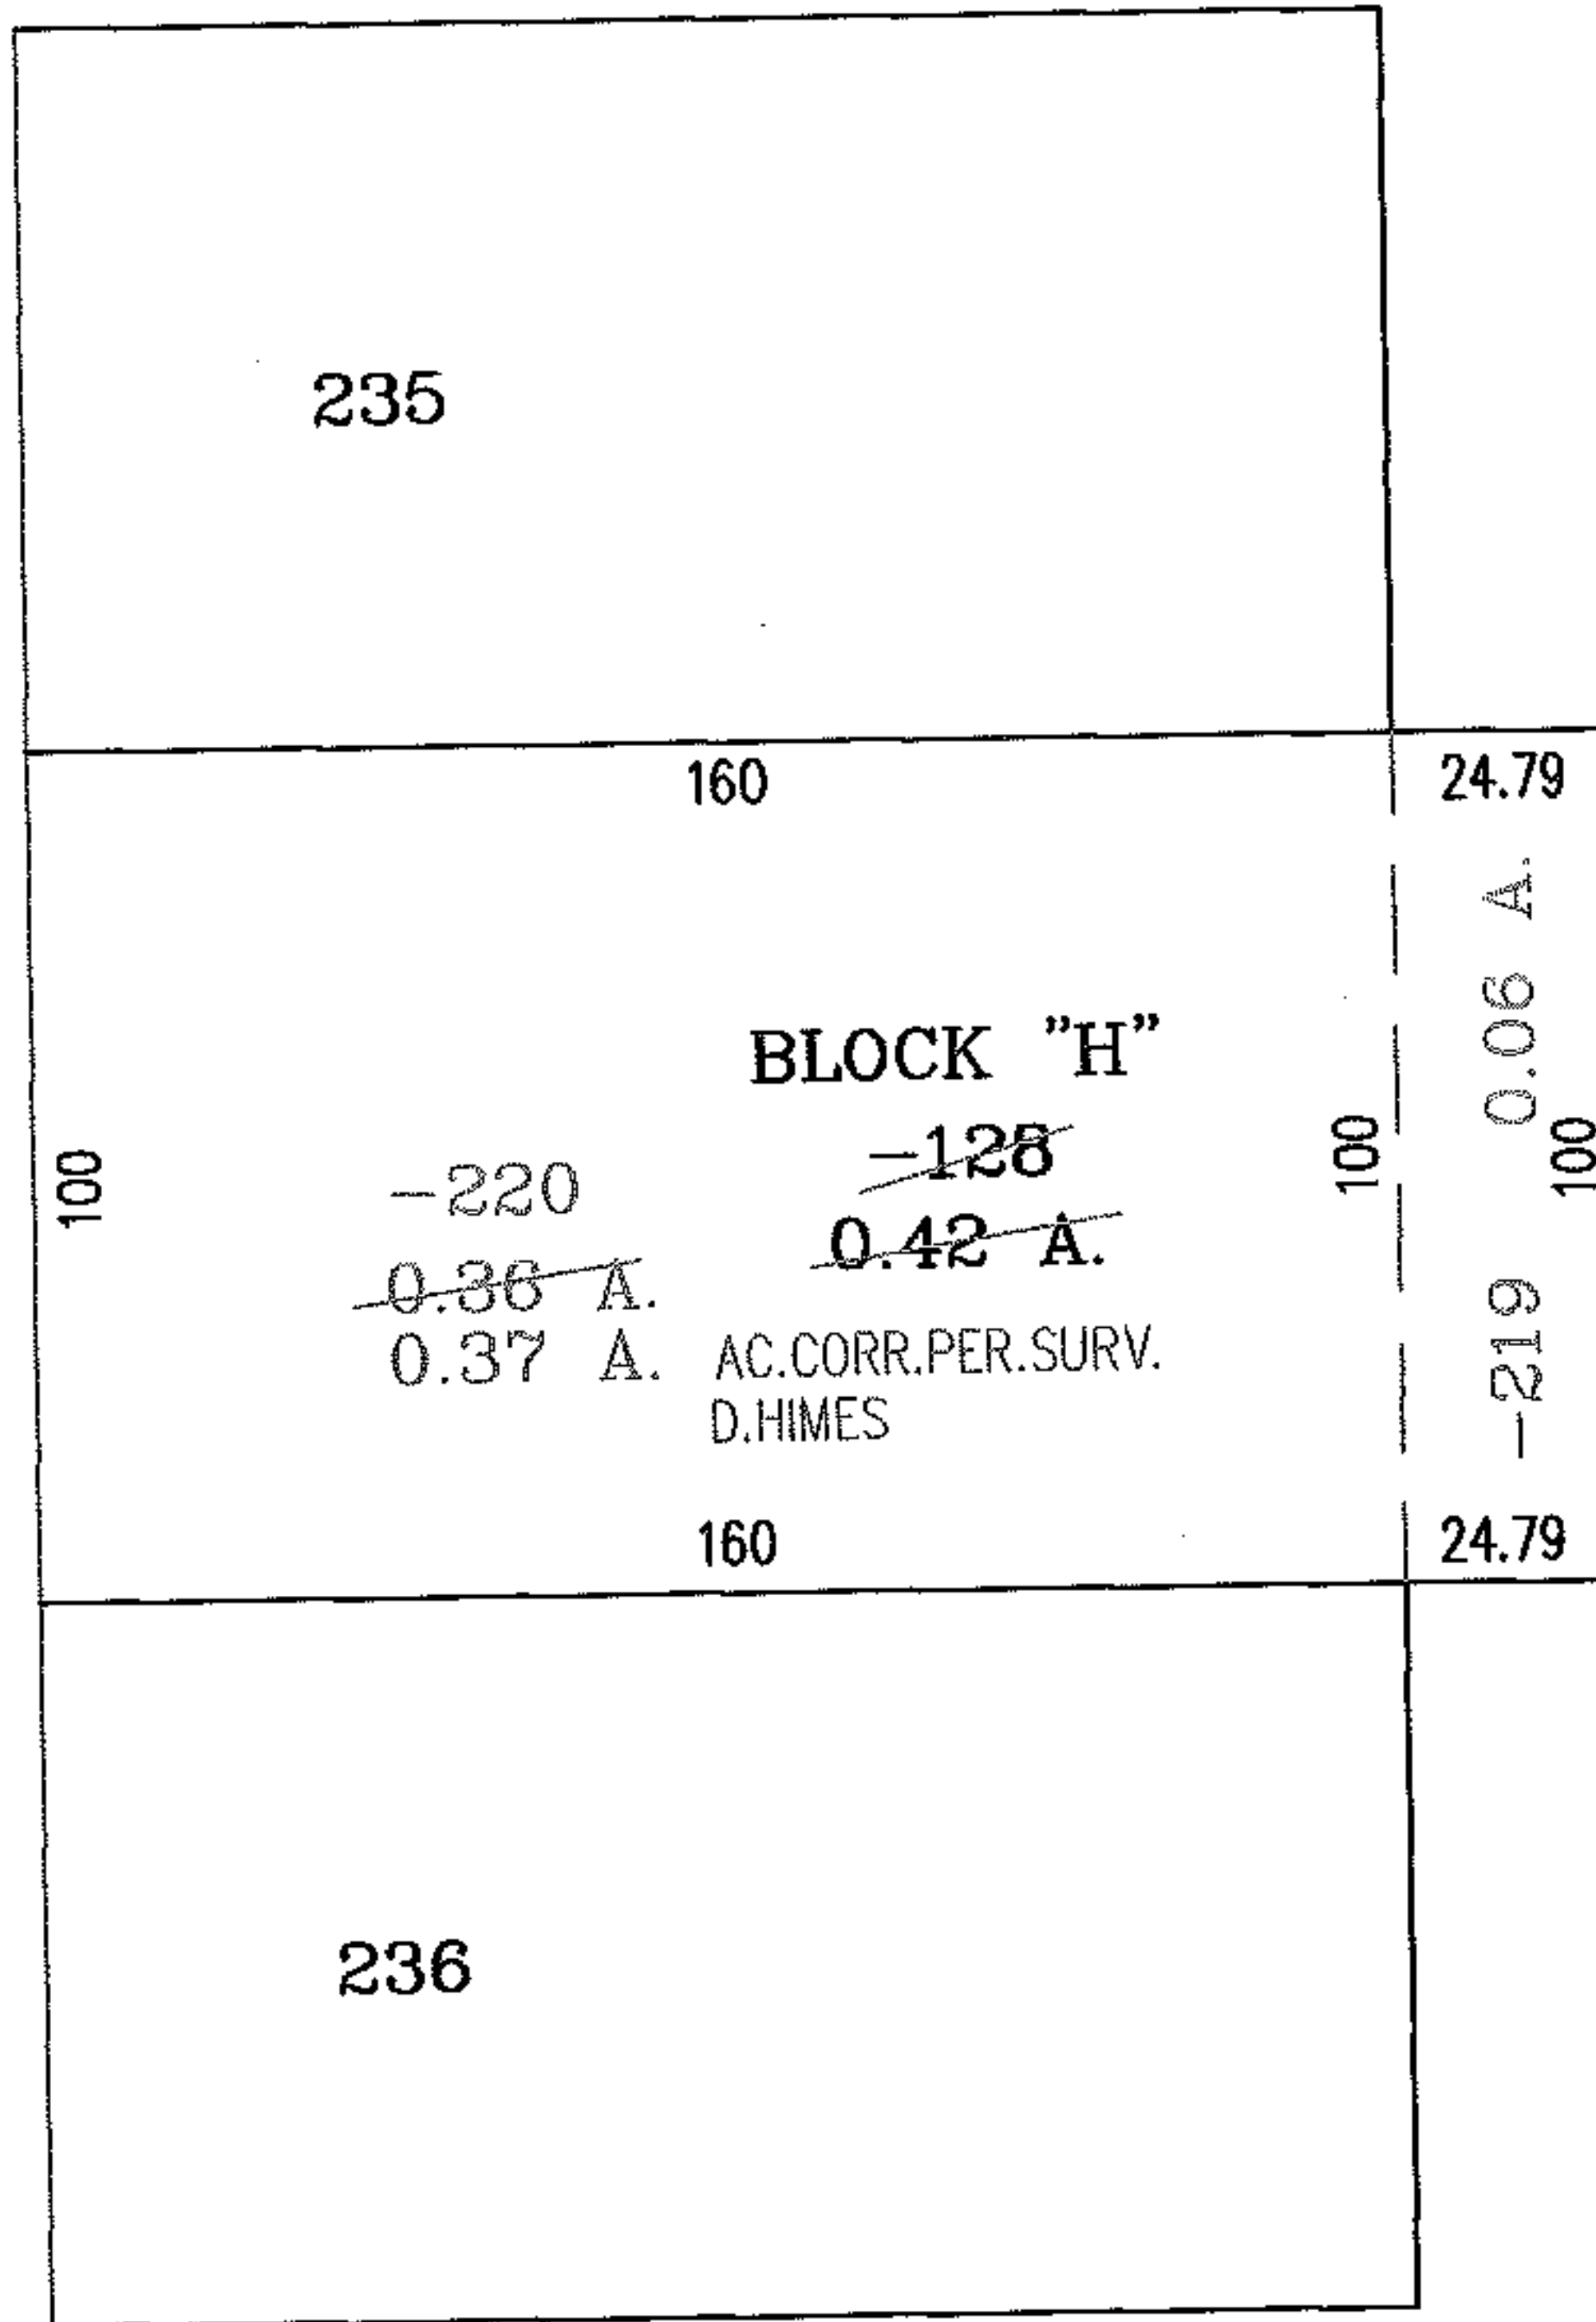

SPLITS/DEEDS PROCESSED

LORAIN COUNTY TAX MAP DEPARTMENT
226 MIDDLE AVE. ELYRIA, OHIO

SURVEYED BY: DONALD E. HIMES

CLOSURE: .00:10.000

MAP PAGE(S): 07-00-002-C

APPROVED BY: RRM DATE: 12-12-05

SCALE: 1" = 50' PRIOR INSTRUMENT: VOL.63 PG.48