
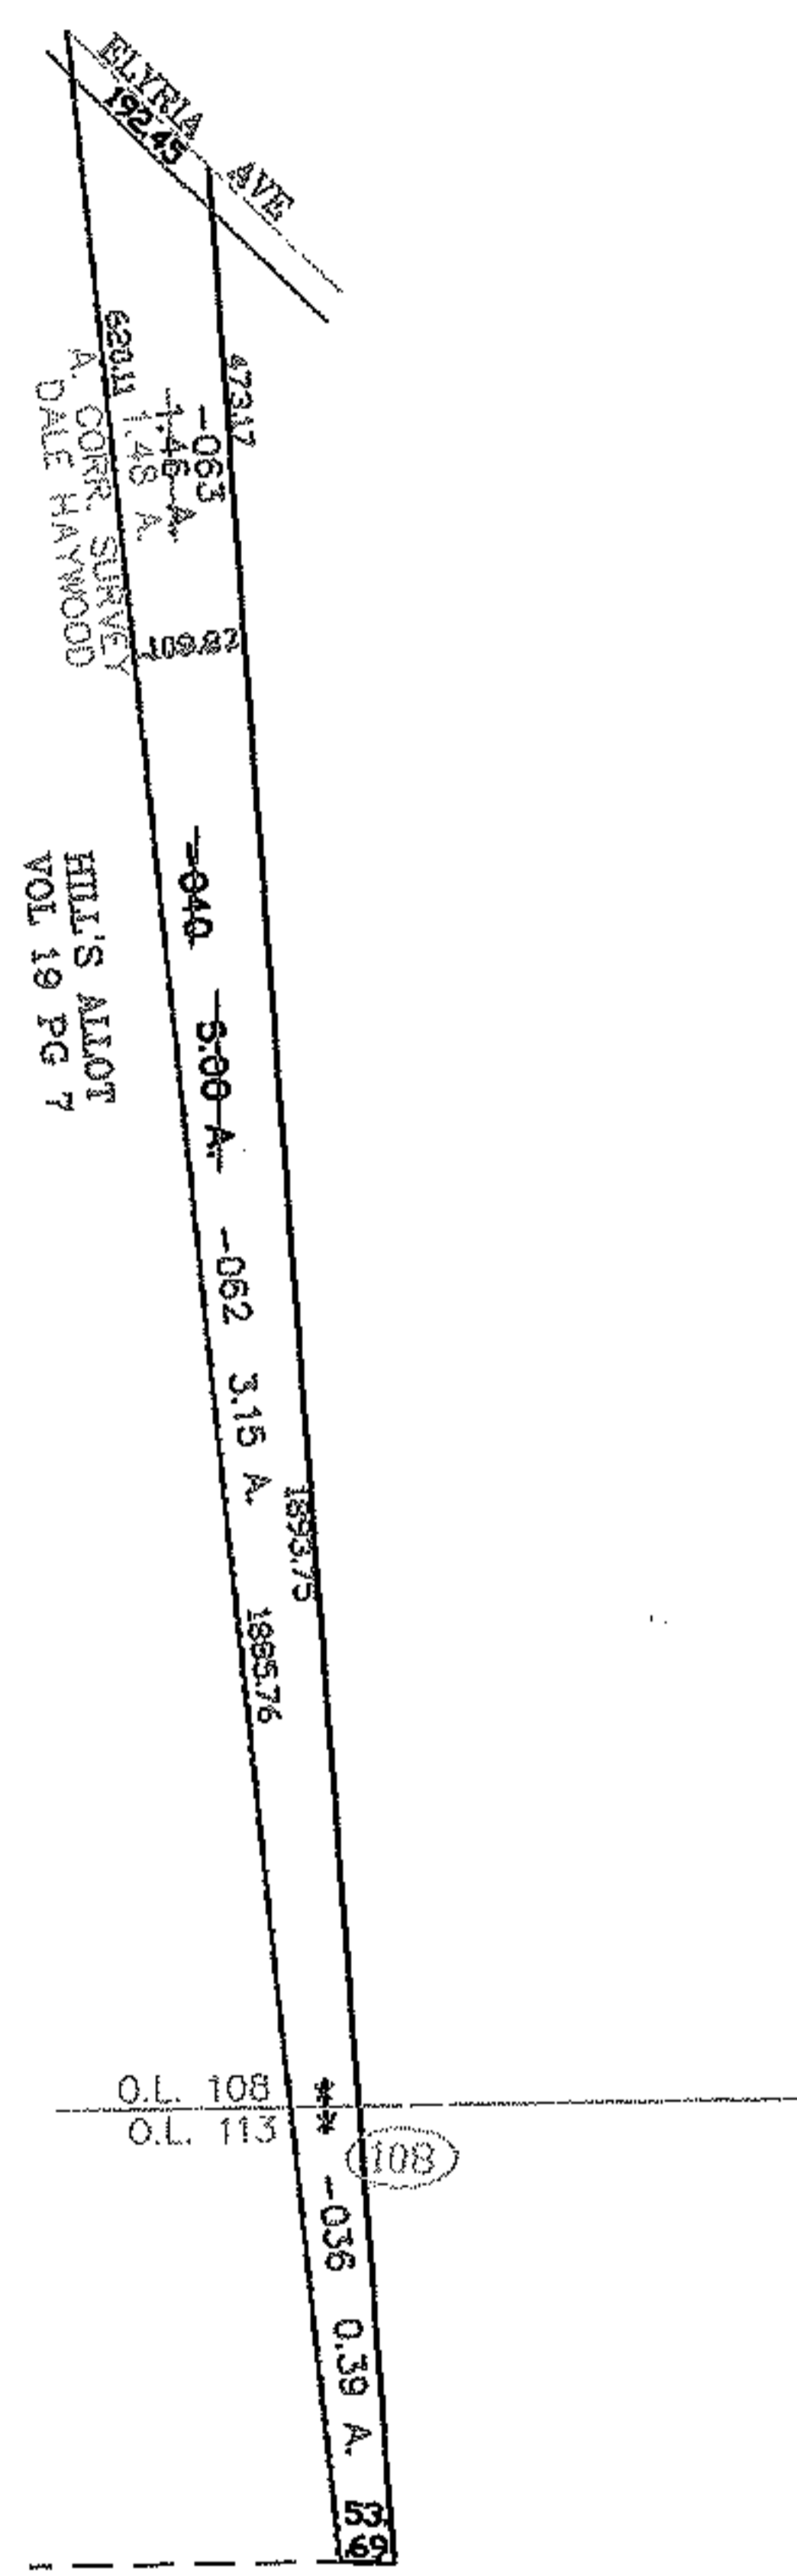


RASTER

PARENT PARCEL: 03-00-108-112-040  
CHILD PARCEL: 03-00-108-112-062, -063 03-00-113-108-036  
STARTING POINT: CENTERLINE OF ELYRIA AVE & NORTHEAST CORNER OF HILL'S ALLOT.

05-01997

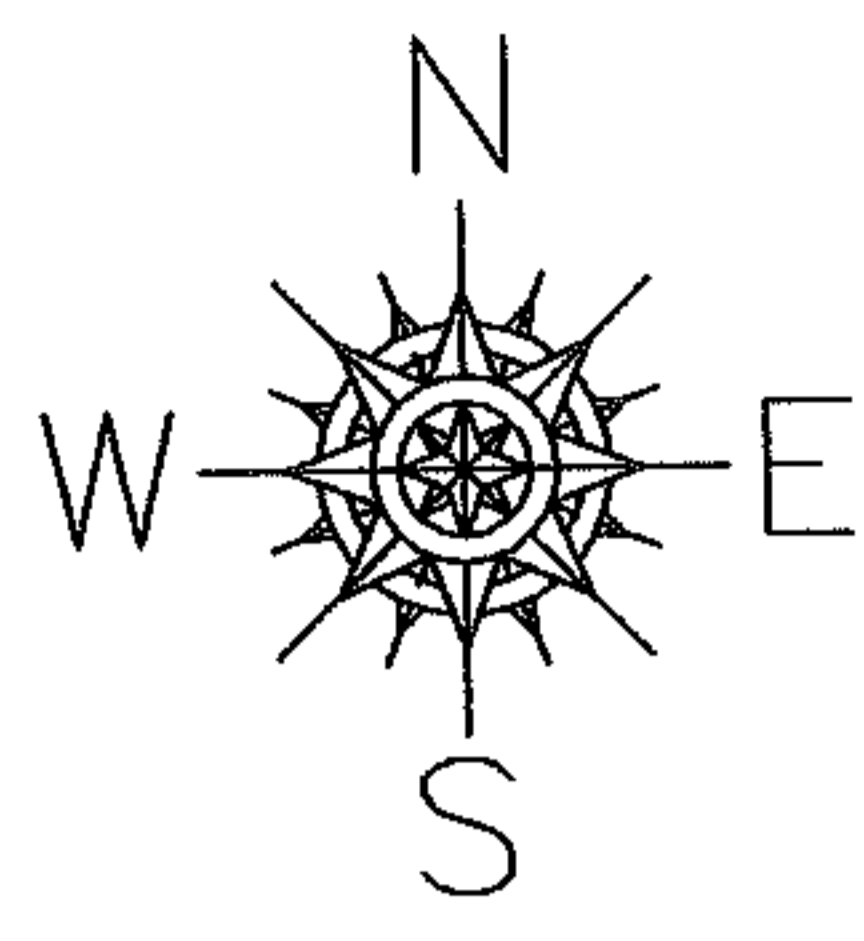

**SPLITS/DEEDS PROCESSED**  
LORAIN COUNTY TAX MAP DEPARTMENT  
226 MIDDLE AVE. ELYRIA, OHIO

SURVEYED BY: DALE HAYWOOD  
CLOSURE: 0.00 : 10.000  
MAP PAGE(S): 01-00-108-B  
APPROVED BY: JAH DATE: 9-7-05  
SCALE: 1" = 400 PRIOR INSTRUMENT: OR 1462/712