


PARENT PARCEL: 06-23-008-104-052

CHILD PARCEL:



10-01998-A

STARTING POINT: SOUTHWEST CORNER OF HAROLD C. & HAZEL C. BLAKE DV 985/764

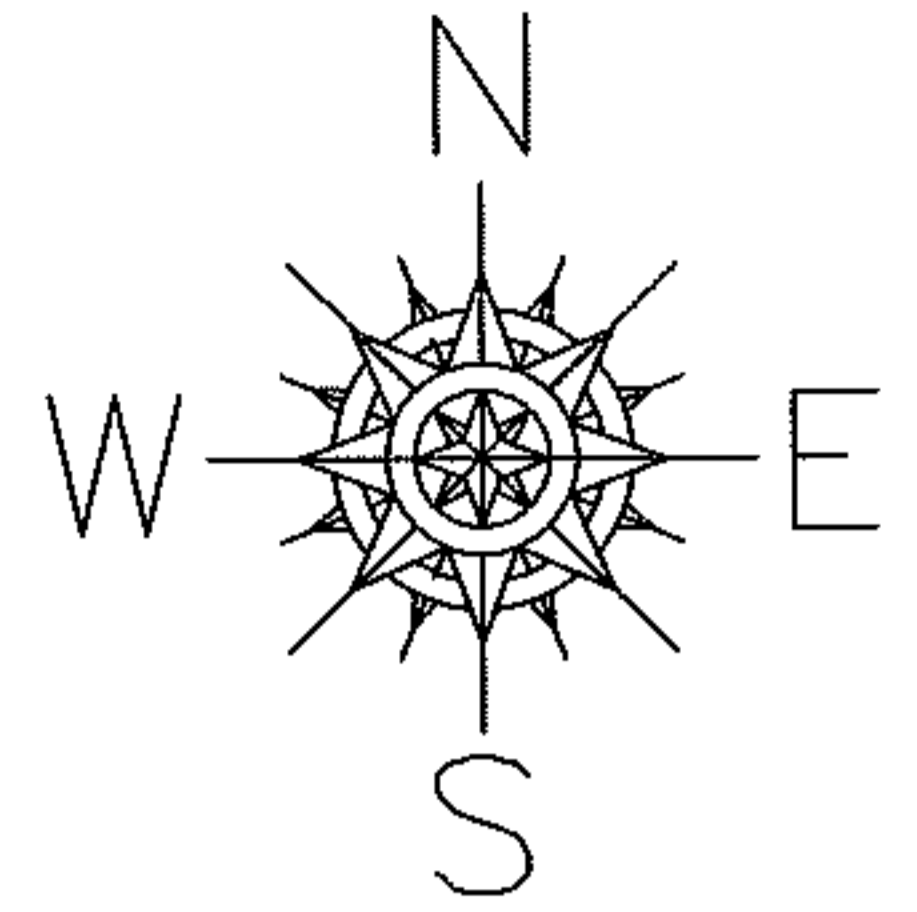

ADD SURVEY BEFORE NEXT TRANSFER

06-23-008-104-052

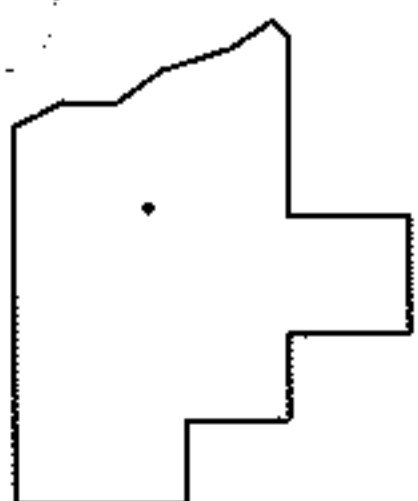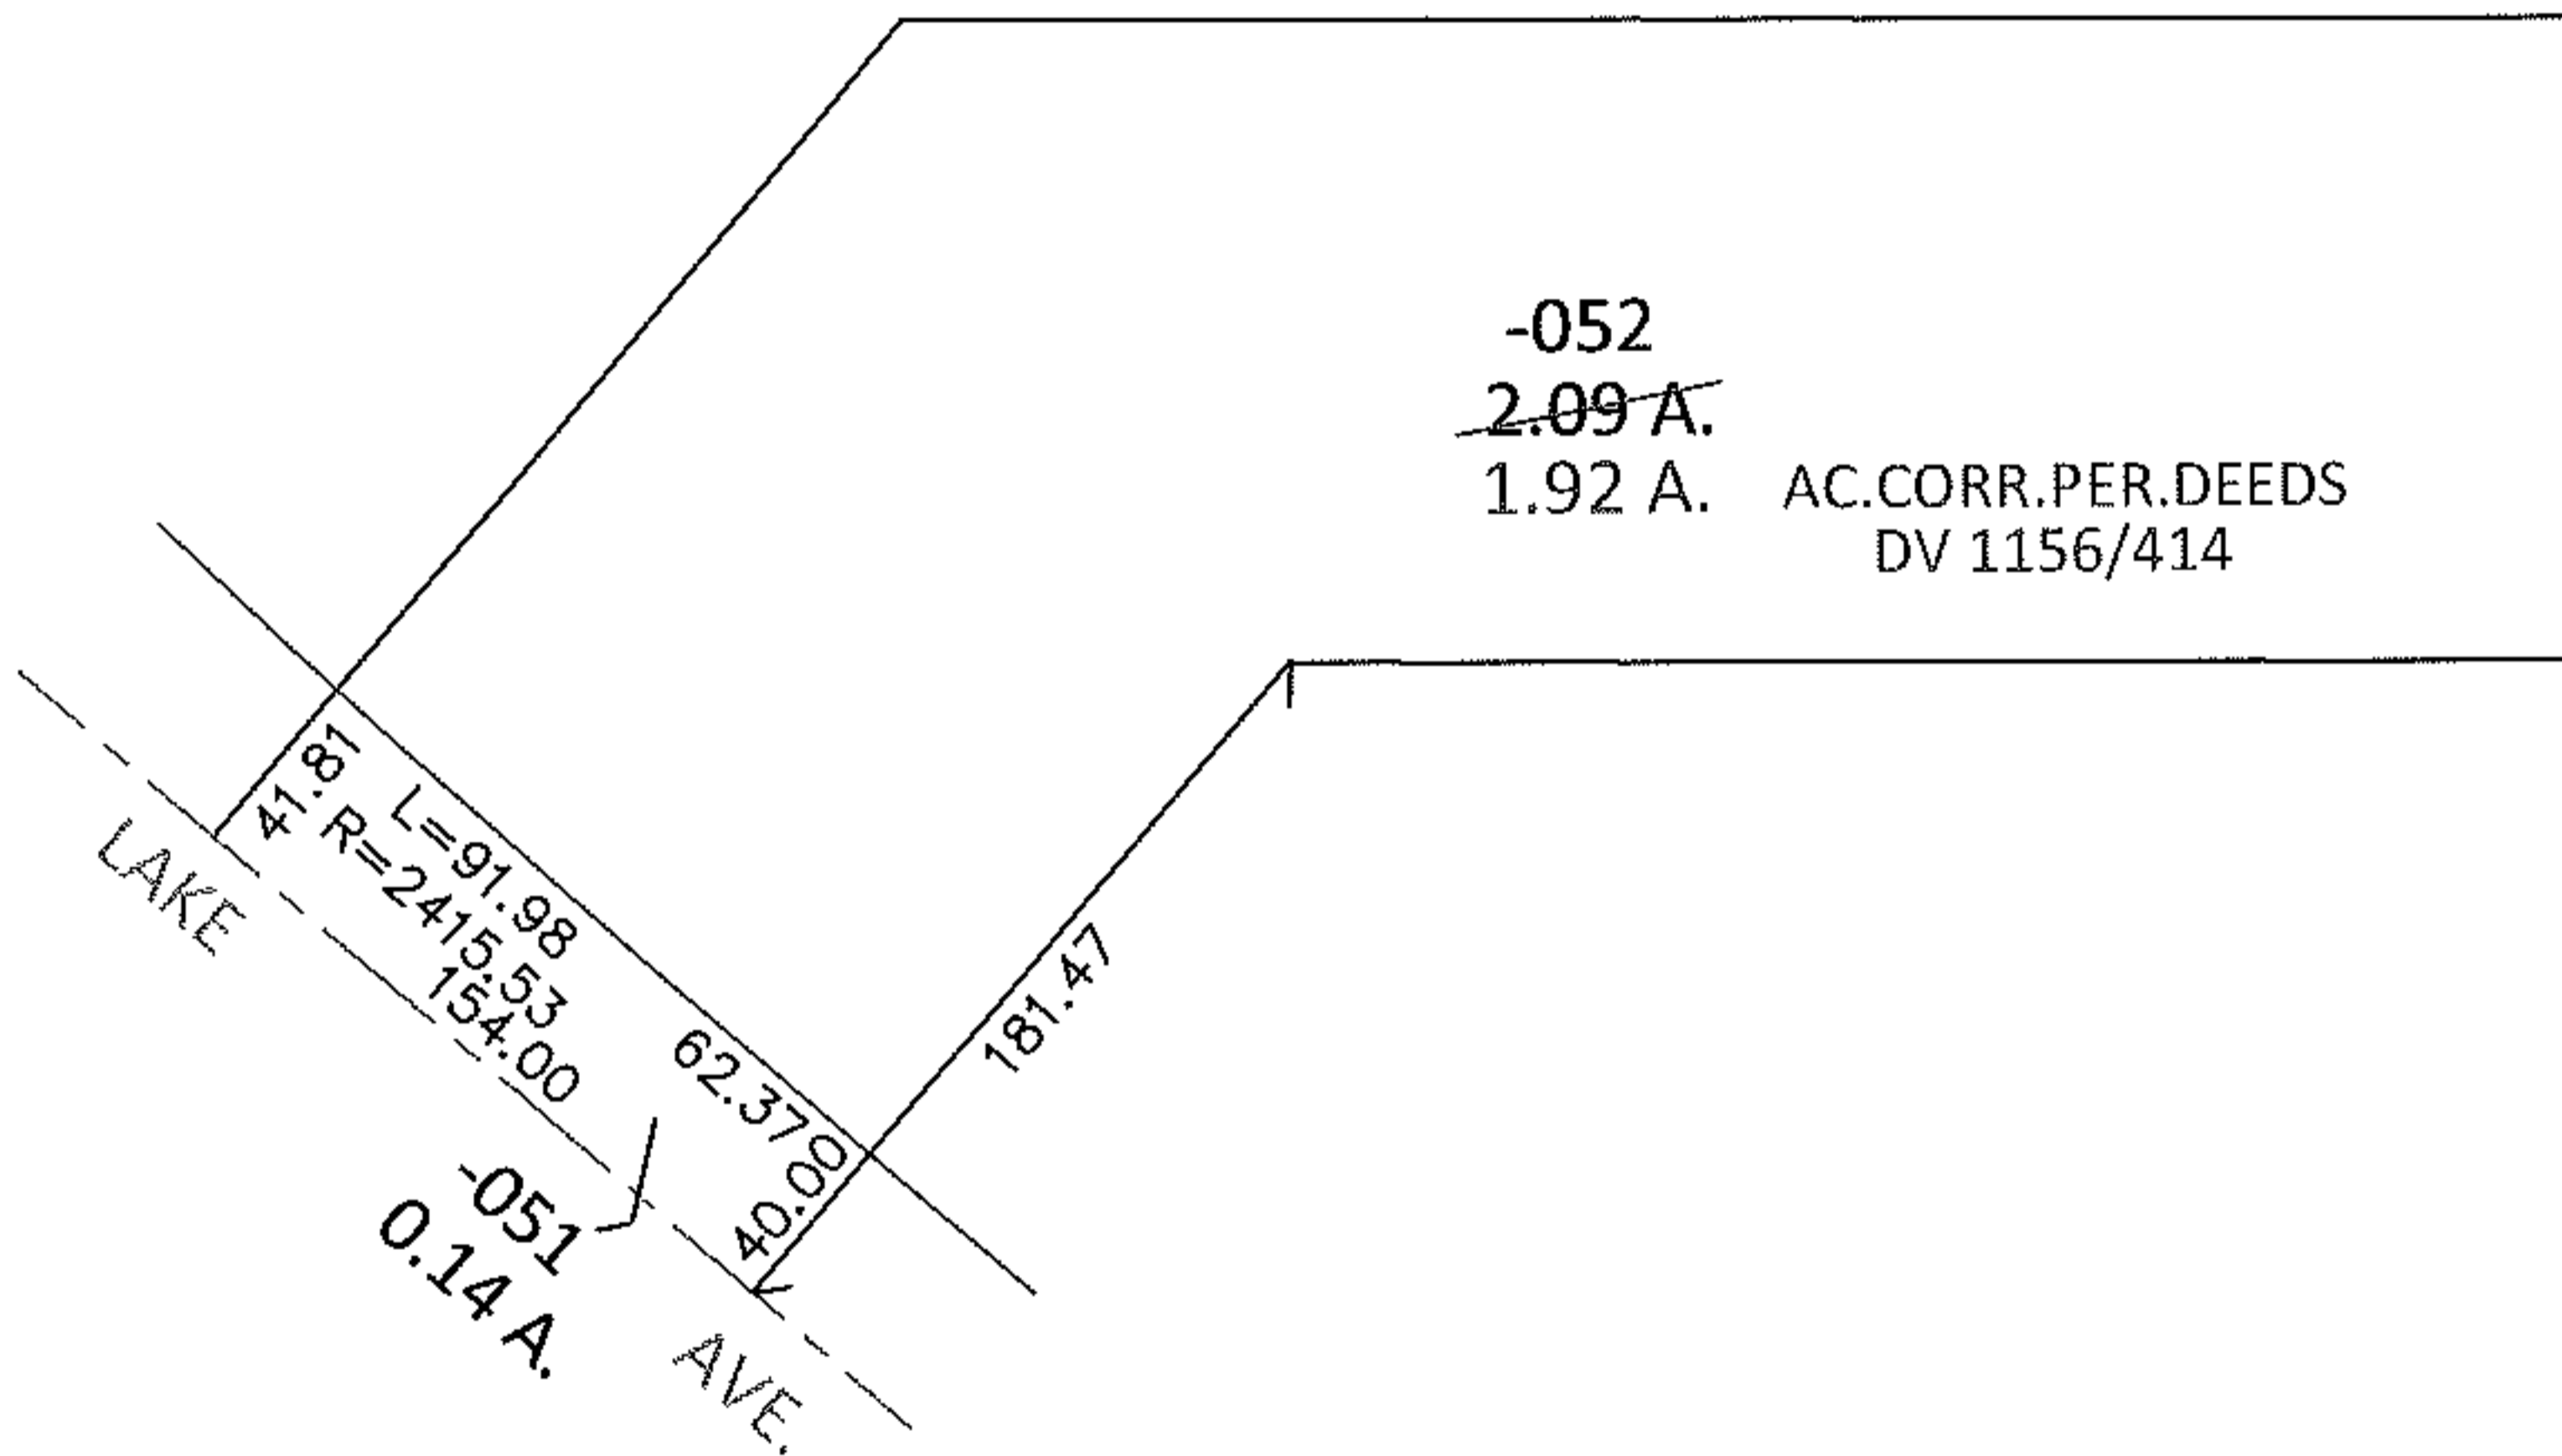

SPLITS/DEEDS PROCESSED

LORAIN COUNTY TAX MAP DEPARTMENT
226 MIDDLE AVE. ELYRIA, OHIO

SURVEYED BY: N/A

CLOSURE: N/A

MAP PAGE(S): 6-24

4-1-10

APPROVED BY: RRM

DATE: XX/XX/XX

SCALE: 1"= 100

PRIOR INST.: DV 1156/414

RASPER