




RASTER

PARENT PARCEL: 07-00-008-116-009

CHILD PARCEL:

STARTING POINT: INTERSECTION OF C/L OF LEAR NAGLE RD. AND C/L OF CENTER RIDGE RD.

NO. 00644-A

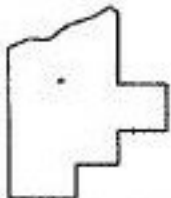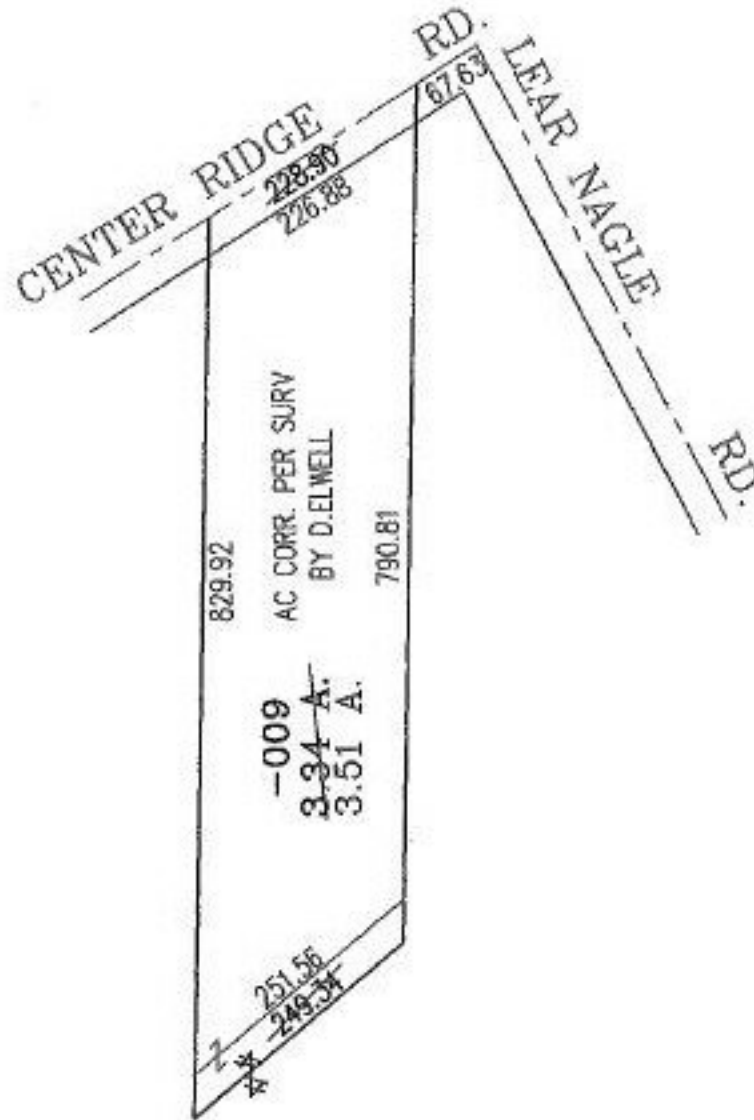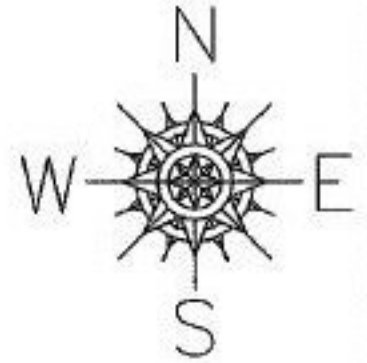

SPLITS/DEEDS PROCESSED

LORAIN COUNTY TAX MAP DEPARTMENT
226 MIDDLE AVE. ELYRIA, OHIO

SURVEYED BY: D. ELWELL

CLOSURE: 00:10.000

MAP PAGE(S): 7-00-008-C

APPROVED BY: RRM DATE: 1-4-02

SCALE: 1" = 200 PRIOR INSTRUMENT: DV 1118/741