



PASTER

PARENT PARCEL: 04-00-005-000-025

CHILD PARCEL: 04-00-006-135-110, 04-00-005-000-104

STARTING POINT: CENTERLINE OF WALKER RD. & MOORE RD.

NO. 00658-X

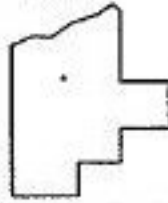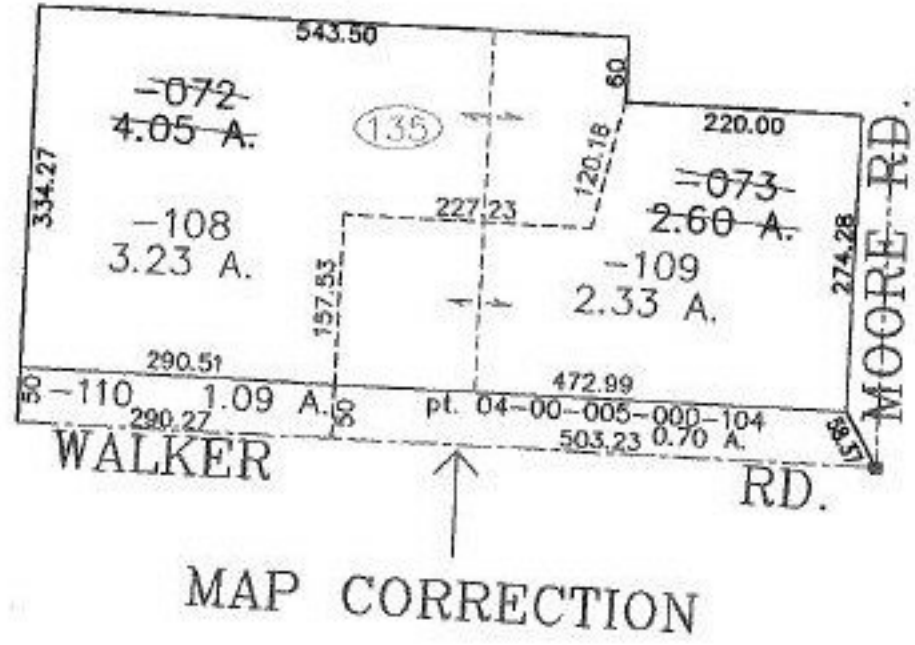

SPLITS/DEEDS PROCESSED
LORAIN COUNTY TAX MAP DEPARTMENT
 226 MIDDLE AVE. ELYRIA, OHIO

SURVEYED BY: RALPH M. GUGAR
 CLOSURE: 0.00 : 10.000
 MAP PAGE(S): 4-00-006-H
 APPROVED BY: JAH DATE: 1-30-02
 SCALE: 1" = 200' PRIOR INSTRUMENT: DV 314/609