

PASTER


PARENT PARCEL: 12-00-024-000-025

CHILD PARCEL: SAME

STARTING POINT: NAIL AT NE CORNER OF O.L. 24 AND SE CORNER OF -017

NO. 00676-A

# UPDATE LEGAL DIST. MISSING

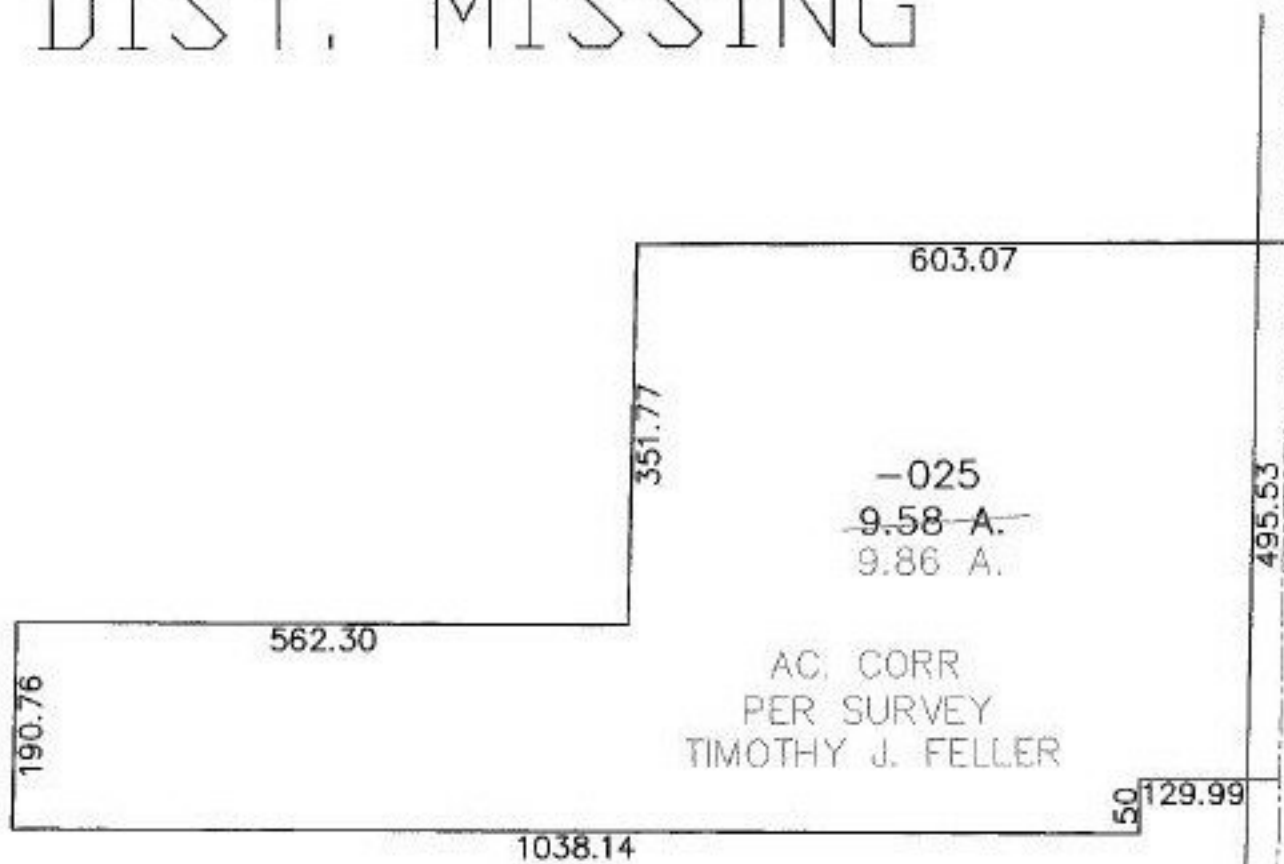

**SPLITS/DEEDS PROCESSED**  
**LORAIN COUNTY TAX MAP DEPARTMENT**  
 226 MIDDLE AVE. ELYRIA, OHIO

SURVEYED BY: TIMOTHY J. FELLER  
 CLOSURE: 0.00  
 MAP PAGE(S): 12-00-024-B  
 APPROVED BY: DRH DATE: 4/17/03  
 SCALE: 1" = 200 PRIOR INSTRUMENT: 20020811715